


Plot of Survey of Lots 5020 to 5024 in Section 3  
 of Bell Lake Subdivisions, Walworth County, Wisconsin  
 Lloyd L. Jensen  
 County Surveyor  
 Aug. 1946  
 G.T.D

#1616

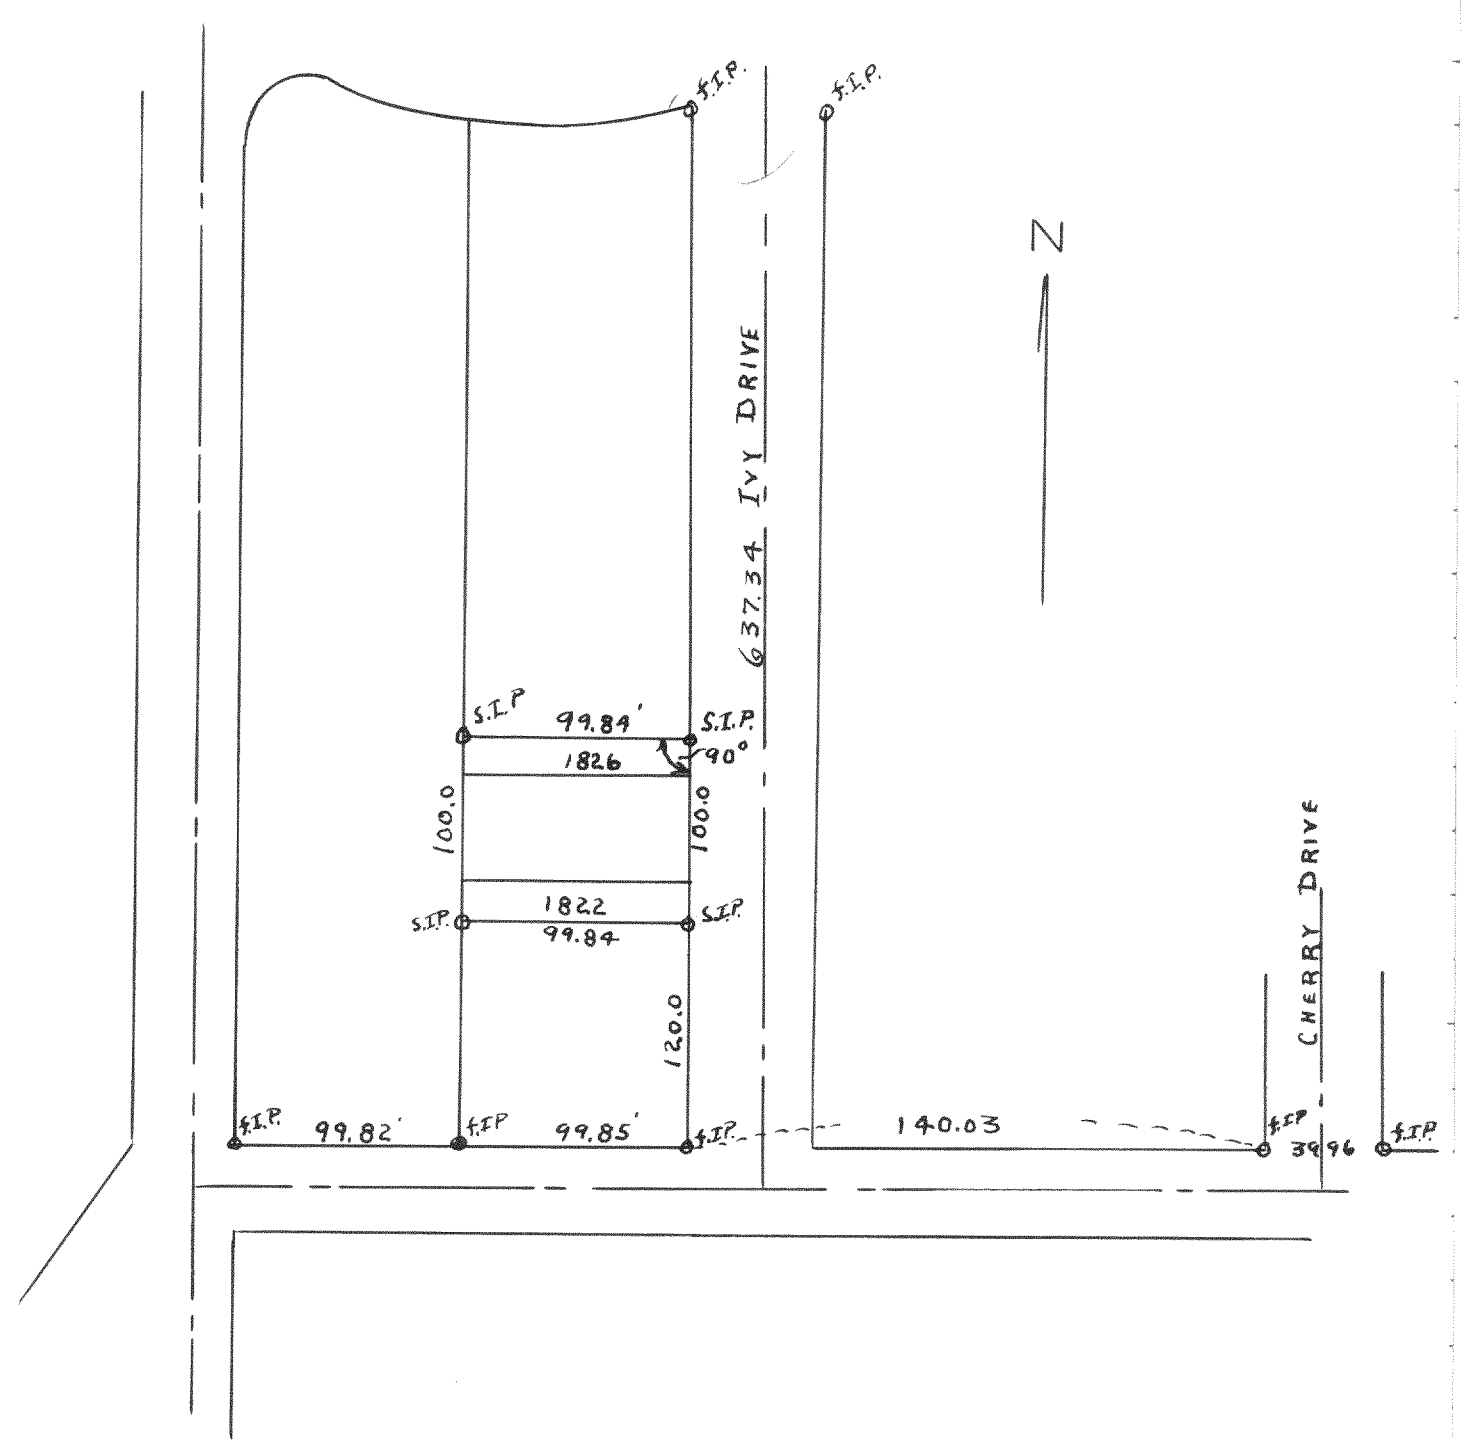

Plot of Survey of Lots 1822 to 1826 in Section I  
 of Bell Lake Subdivisions in Walworth County, Wis.  
 Lloyd L. Jensen  
 County Surveyor  
 Aug. 1946