



SURVEY No. 1224

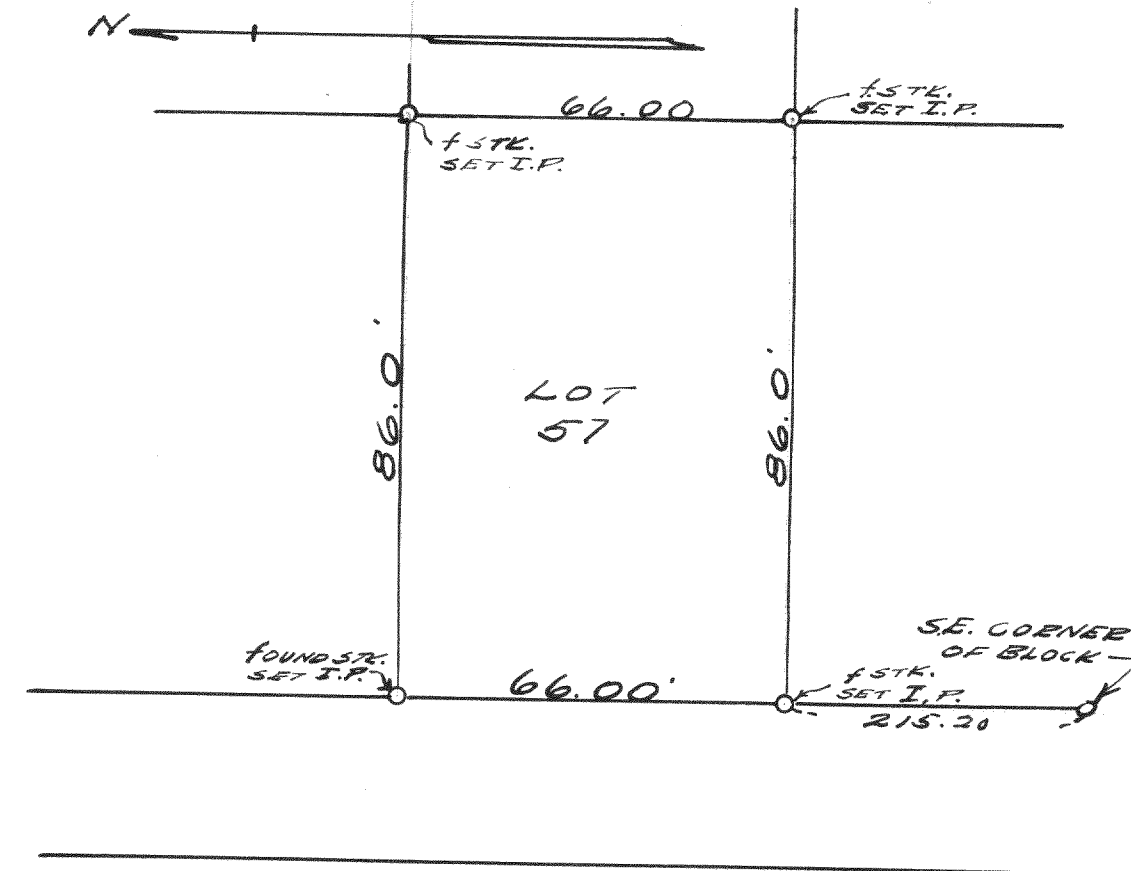

PLAT OF SURVEY OF ROBINSON'S SECOND
SUBDIVISION, (LOT 57). TIN RITE, WALWORTH
COUNTY, WISCONSIN
MAY, 1941
Lloyd L Jensen
S.E.J.

SURVEY No. 1225

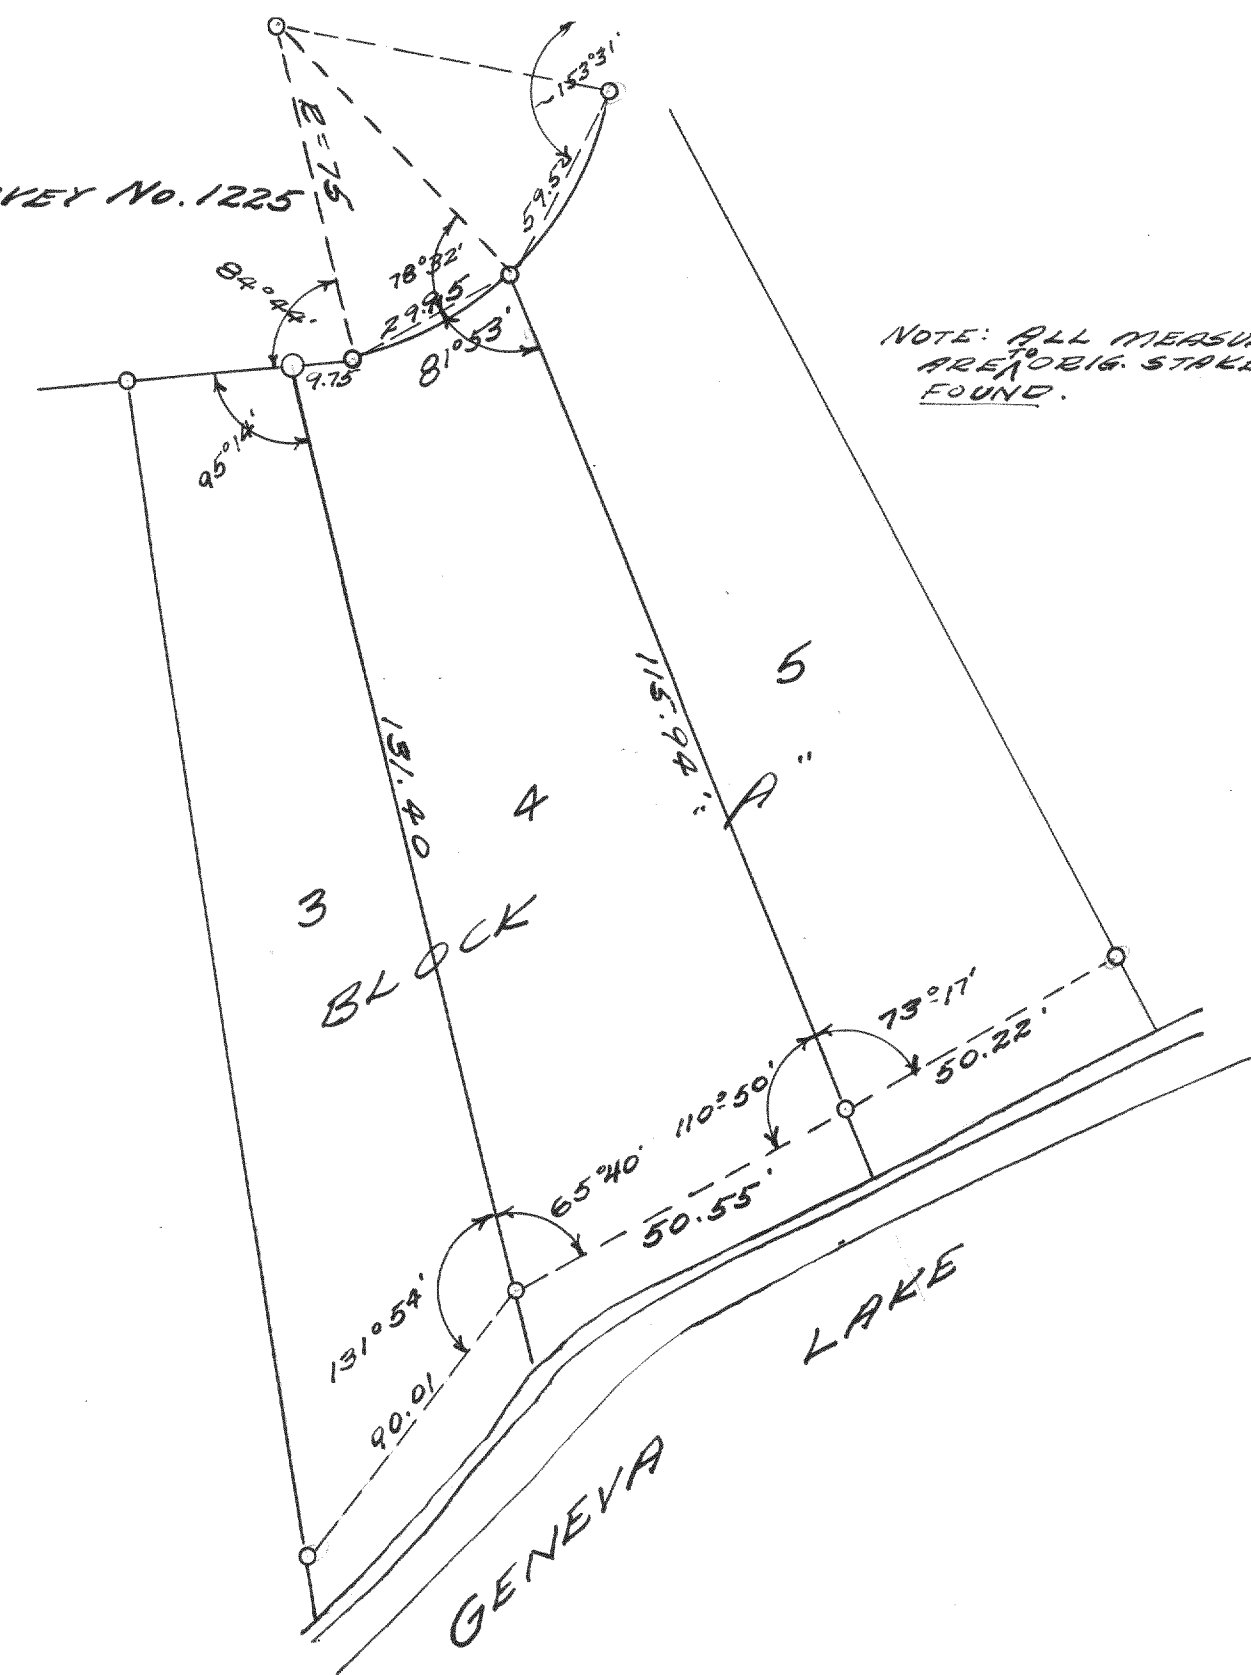

SURVEY OF LOT 4 BLOCK "A" OF
CISCO BEACH SUBD., SECTION 5,
TIN RITE, WALWORTH CO., WISC.
JUNE 1941
Lloyd L Jensen
S.E.J.