



# 1617

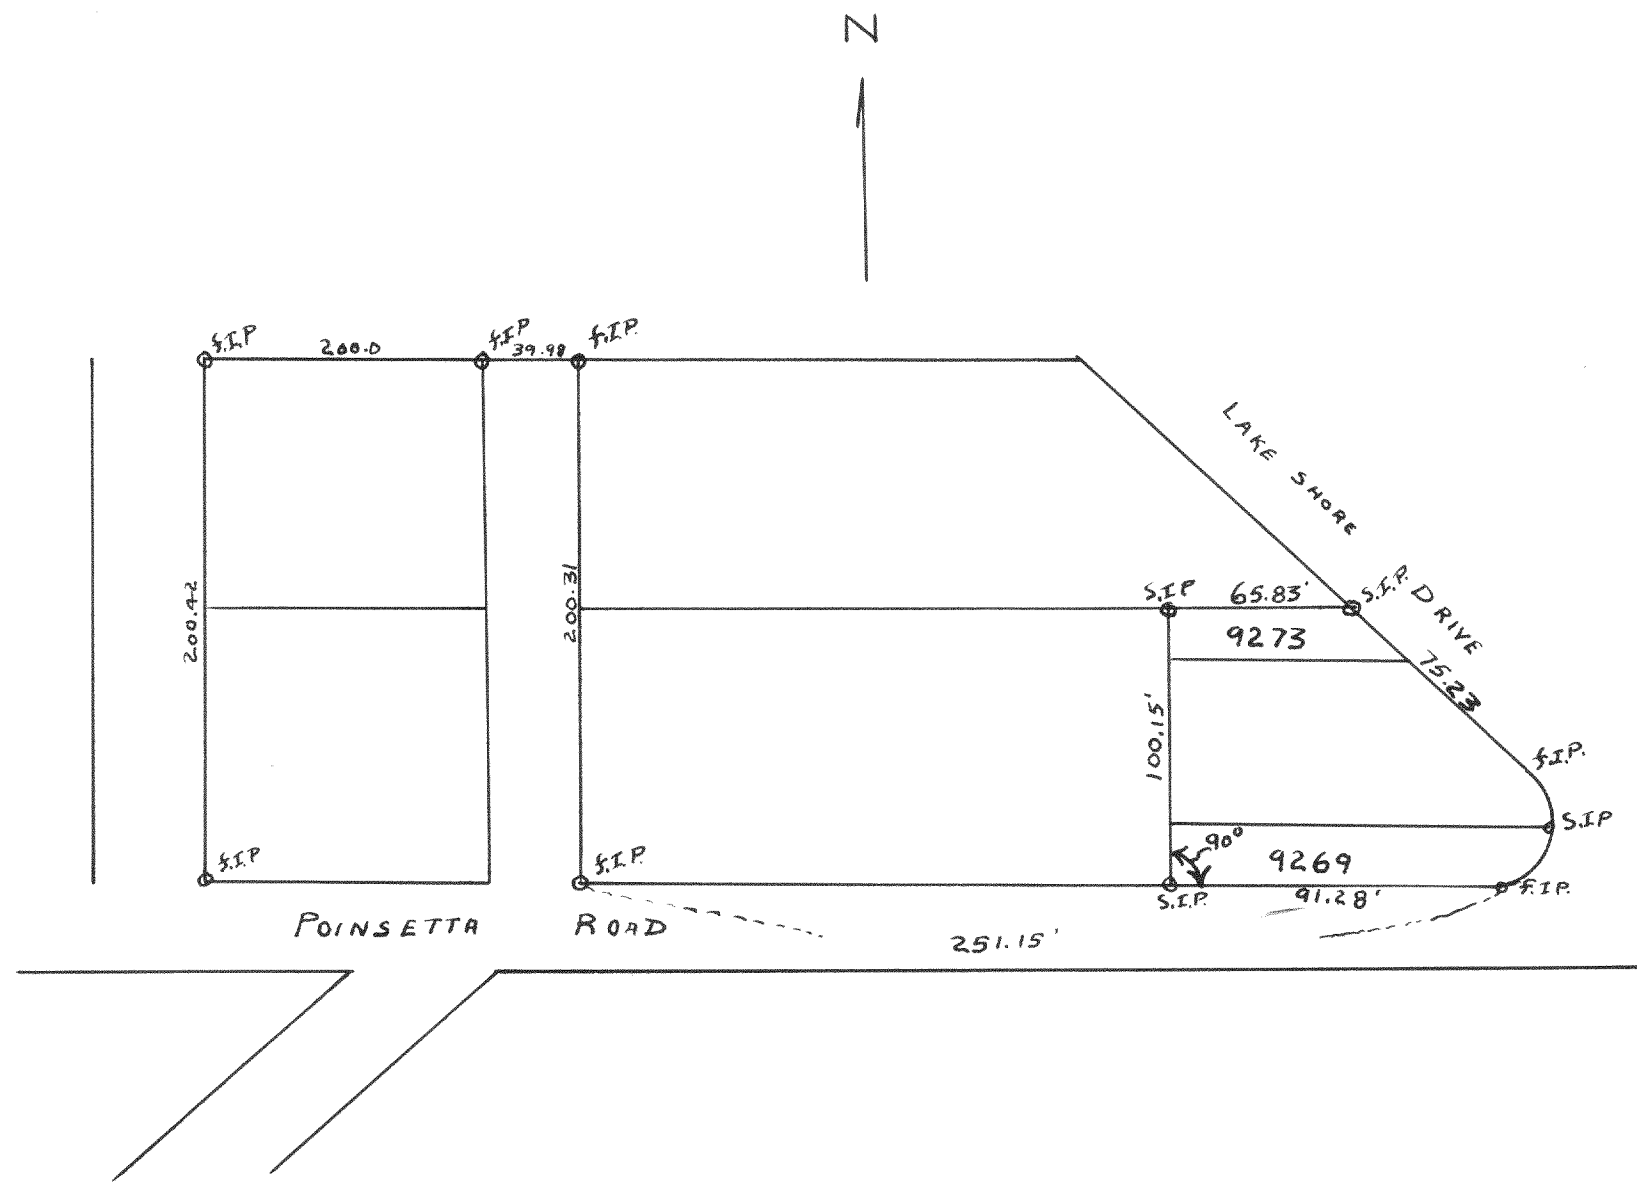

Plat of survey of Lots 9269 to 9273 in section 5  
of Bell Lake subdivisions, Walworth County, Wisconsin  
Lloyd I. Jensen  
County Surveyor  
Sept 1946

# 1618

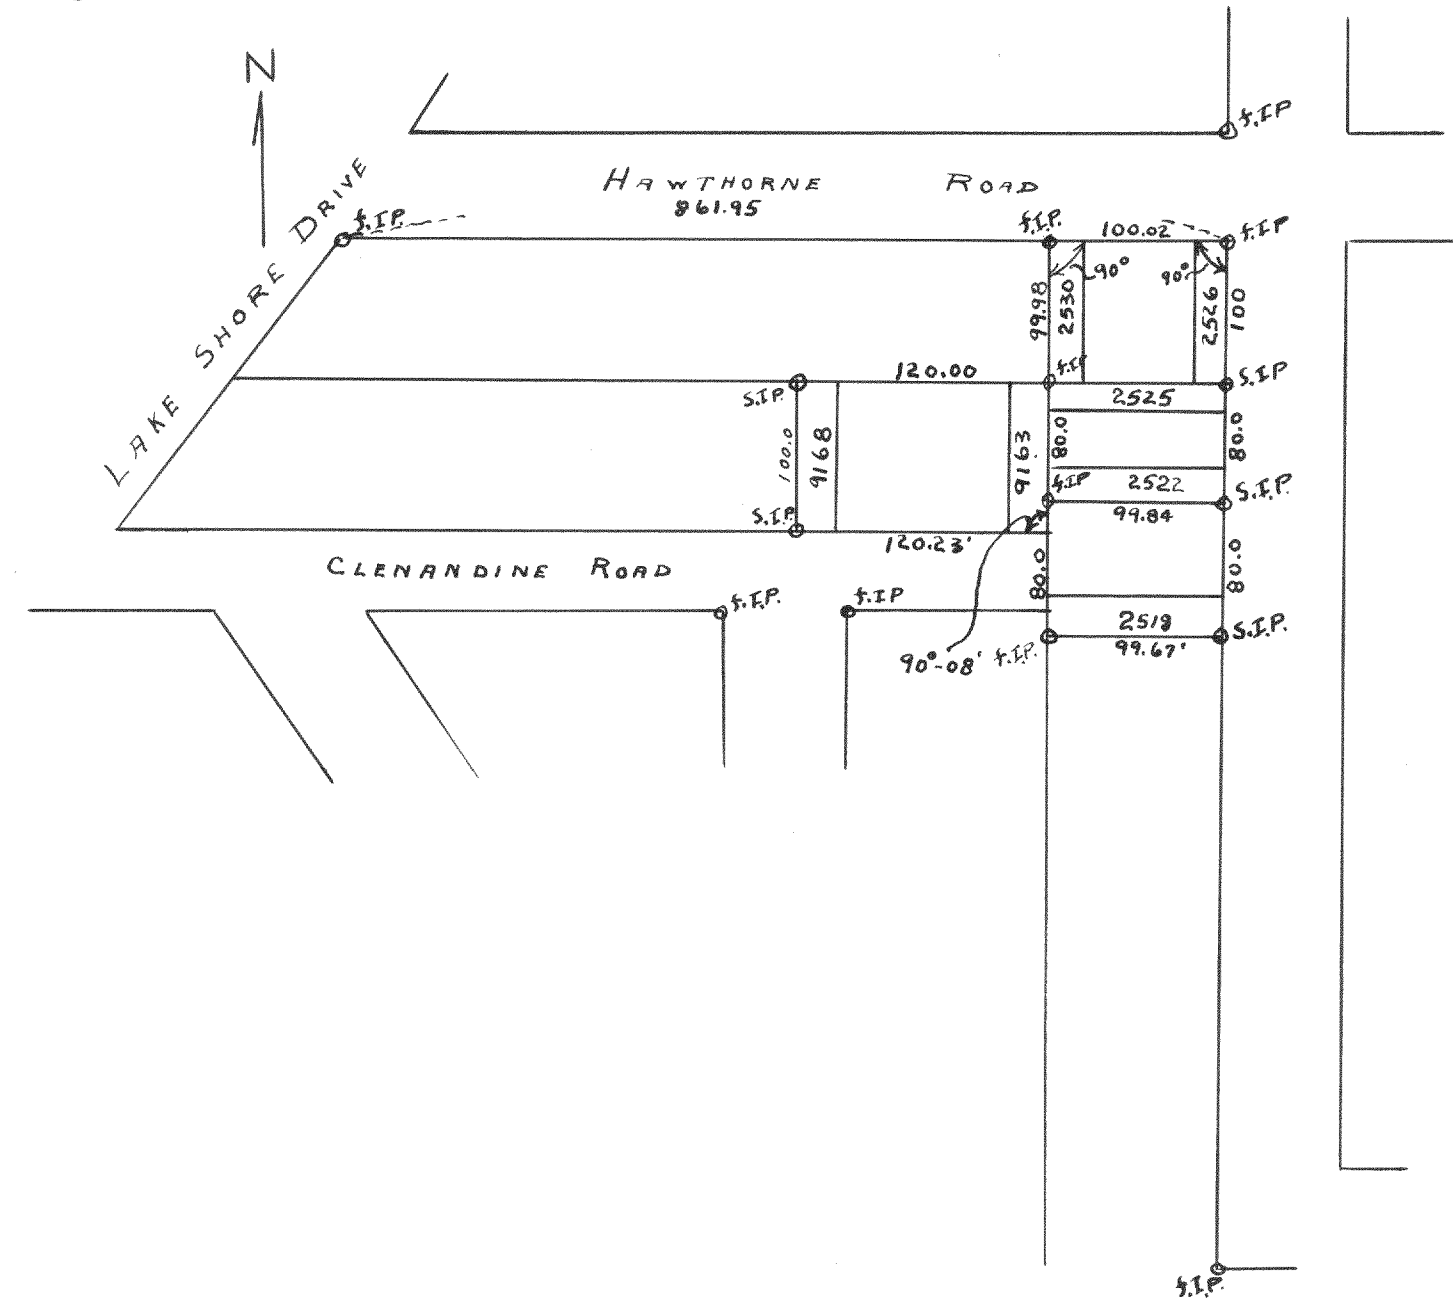

Plat of survey of Lots 2518 to 2530 in section 2  
and Lots 9163 to 9168 in section 5 of Bell Lake  
subdivisions, Walworth County, Wisconsin  
Lloyd I. Jensen  
County Surveyor  
Sept. 1946