


#1619

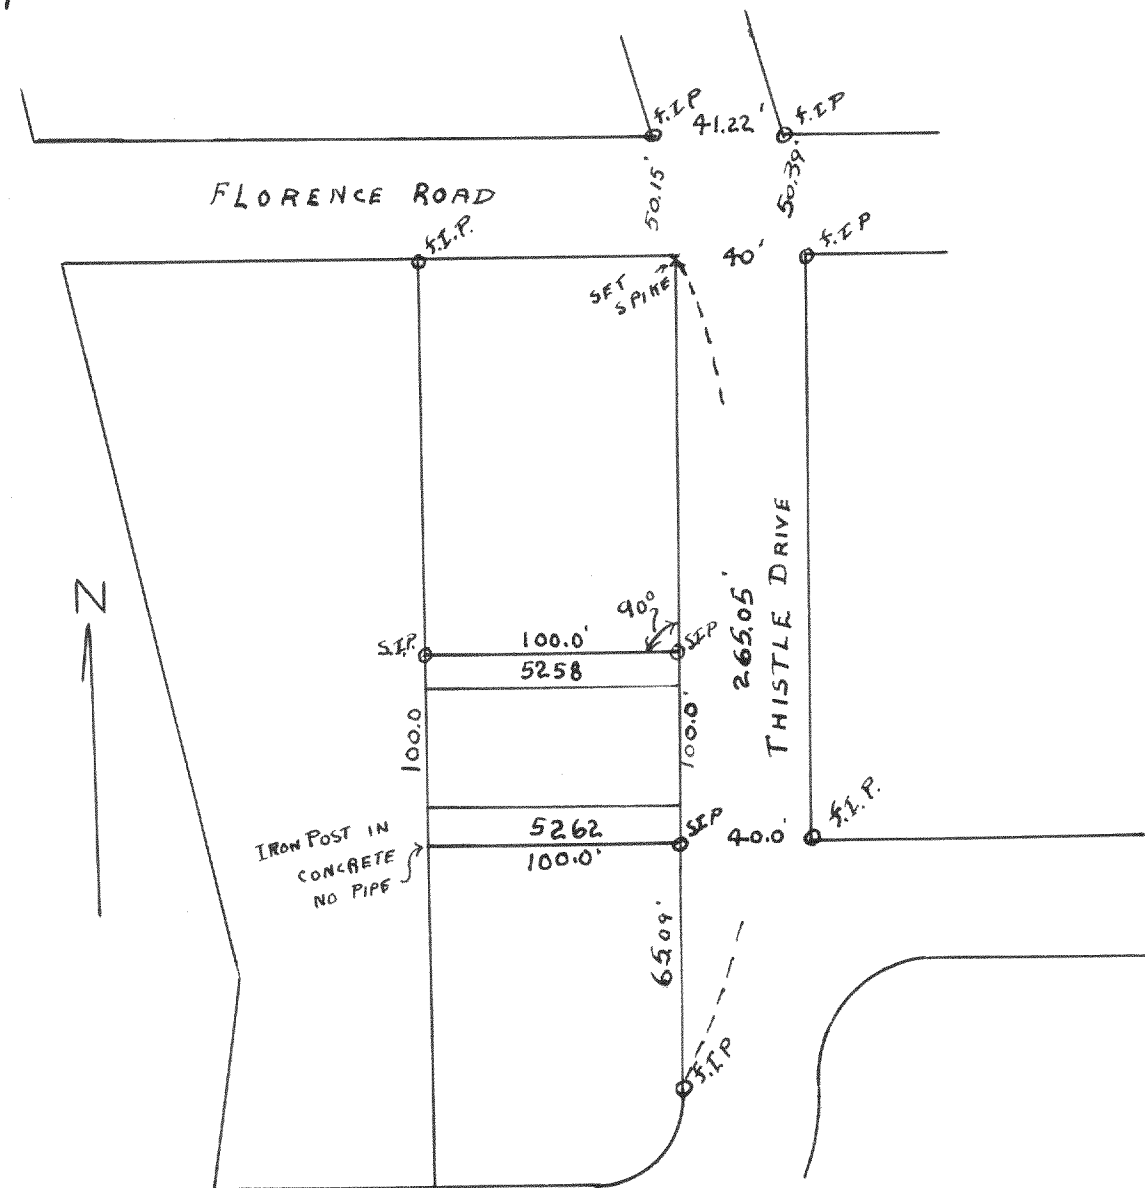


Plat of survey of lots 5258 to 5262 in
Section 3 of Bell Lake Subdivisions, Walworth
County, Wisconsin

Sept. 1946

Lloyd T. Jensen
County Surveyor
G.T.D.

#1620

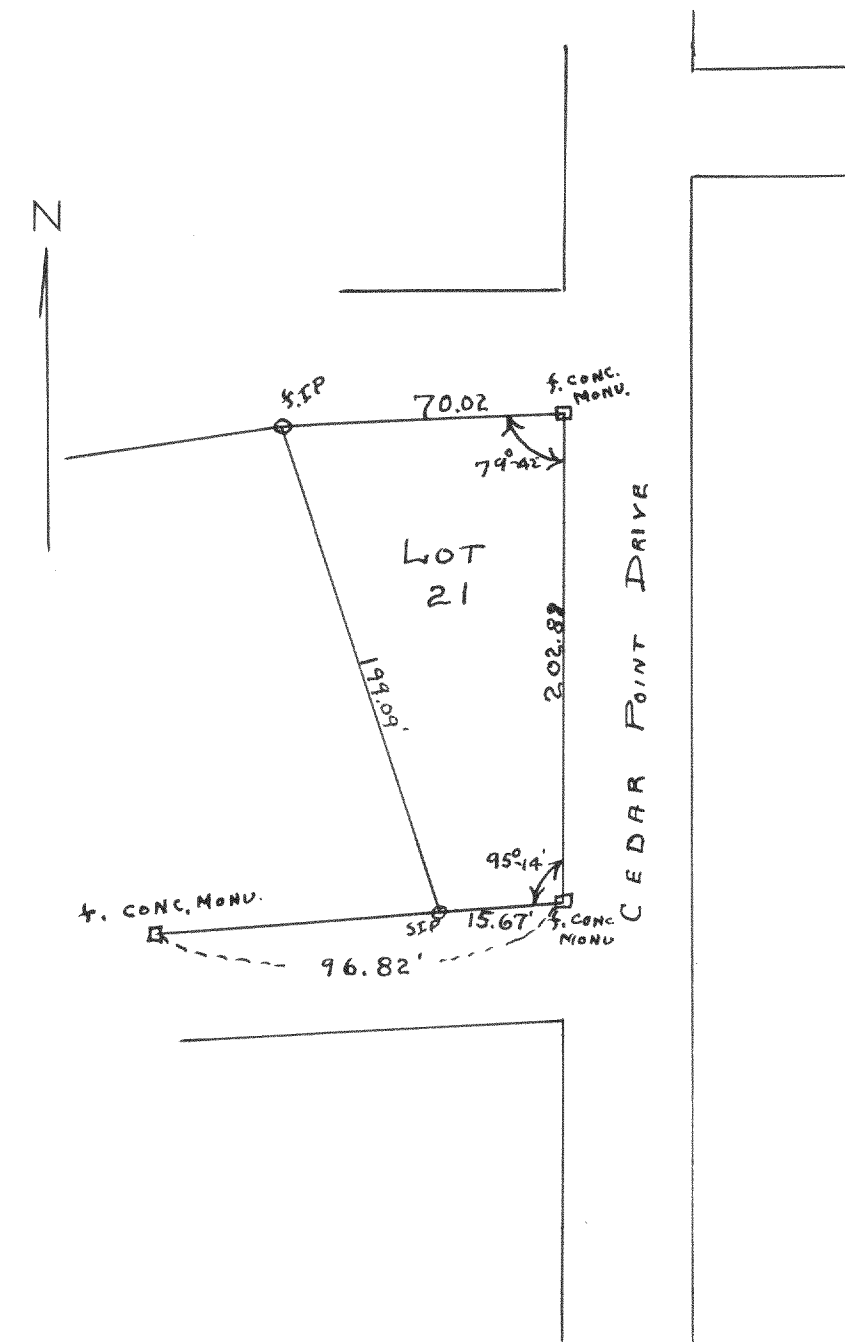

Plat of Survey of Lot 21 located in Cedar Point Park 1st Addition
in the Village of Williams Bay, Walworth County, Wisconsin

Sept. 1946

Lloyd T. Jensen
County Surveyor
G.T.D.