



1623

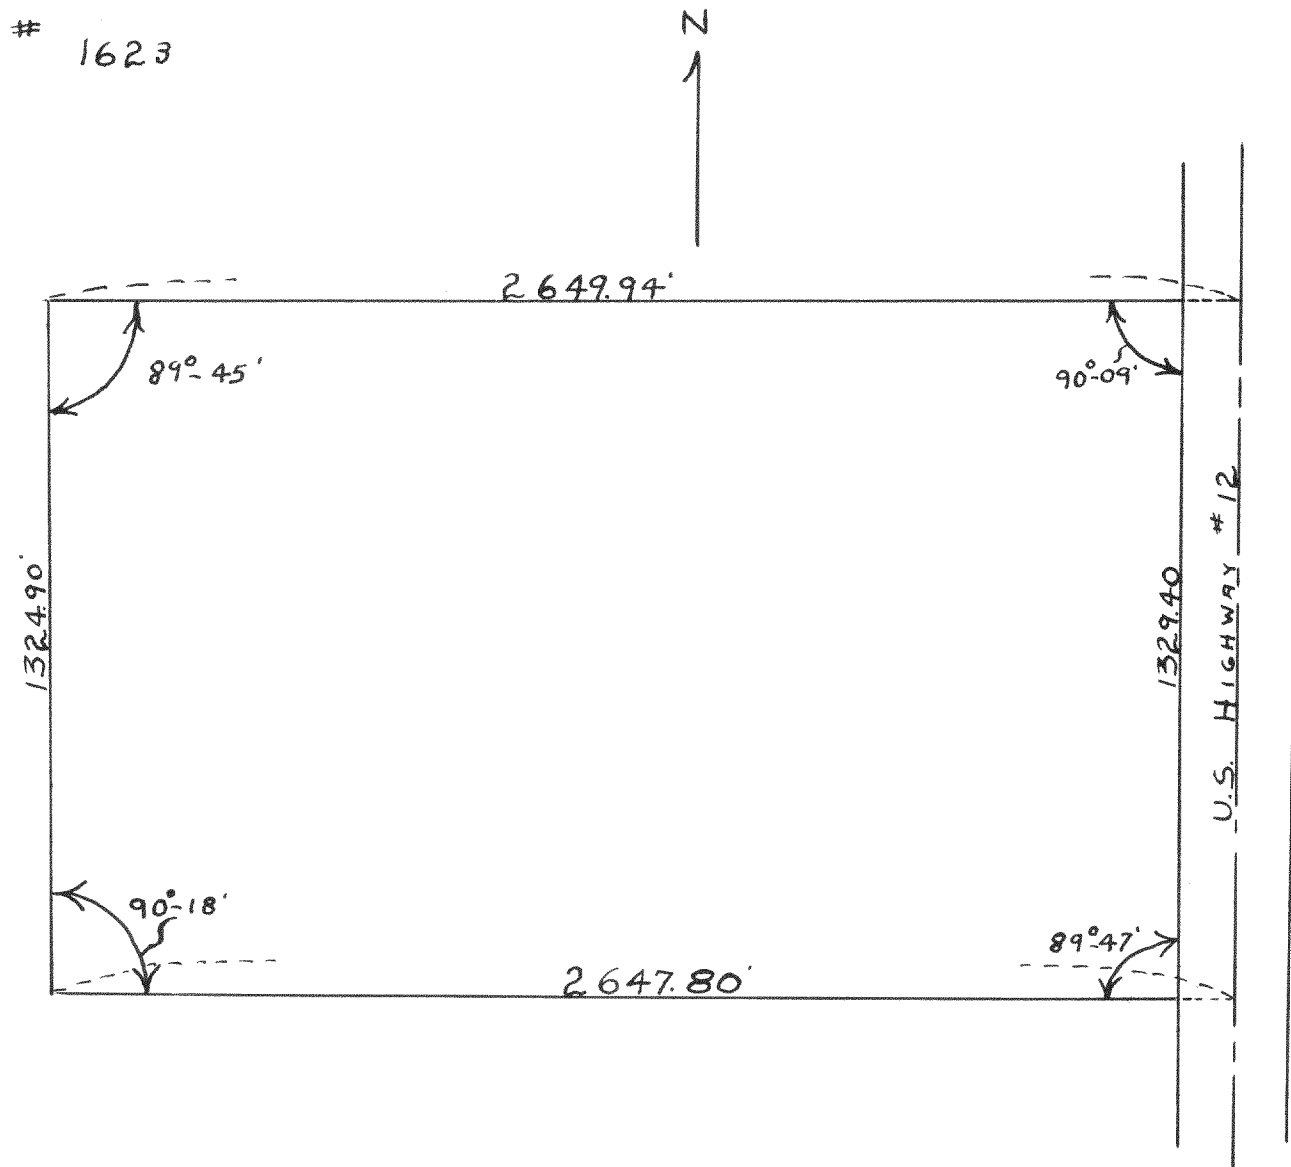

Plat of Final Line Survey of the Ben Cameron
Farm located in the S. 1/2 of the NE 1/4 of Section 7
T2N R17E, Walworth County, Wisconsin
Lloyd L. Jensen
County Surveyor
G.T.D.
Sept 1946

1624

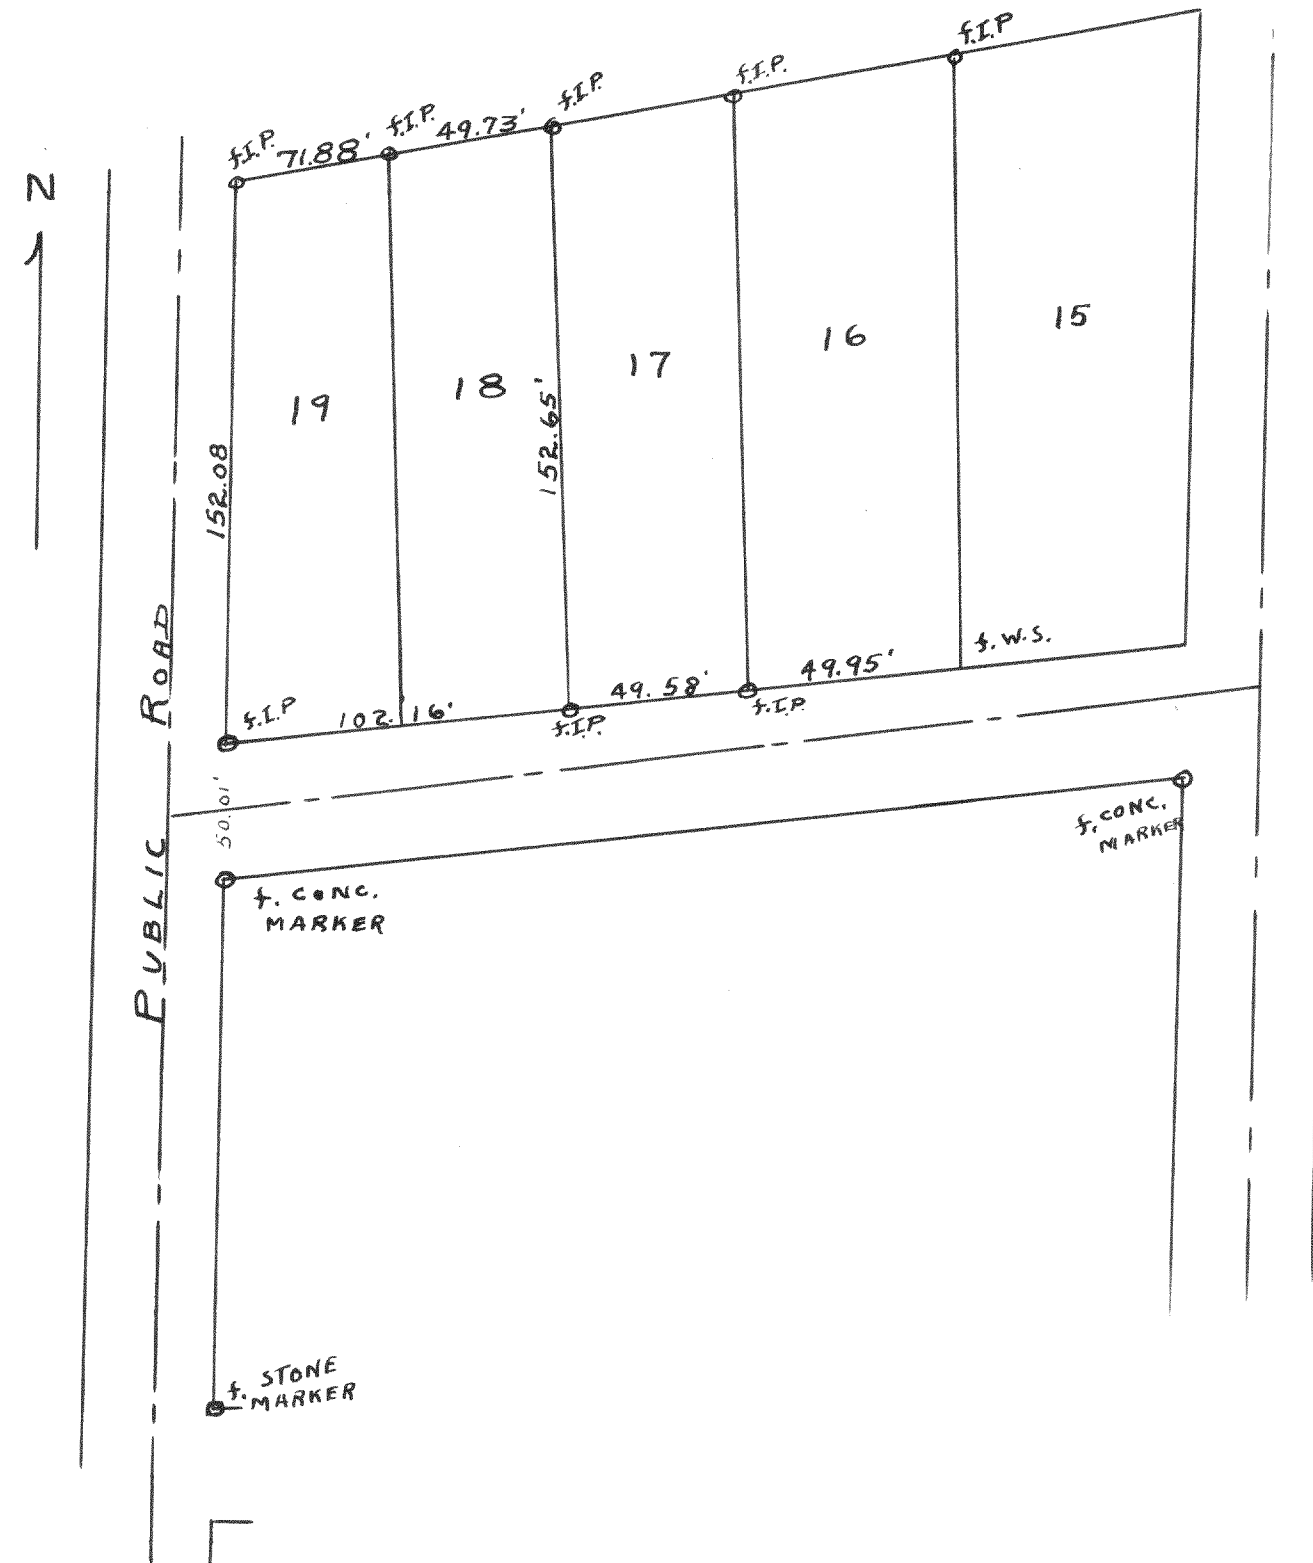

Plat of Survey of Lots 18 and 19, Elliotts Subdivision,
Powers Lake, Walworth County, Wisconsin
Lloyd L. Jensen
County Surveyor
G.T.D.
Oct 1946