



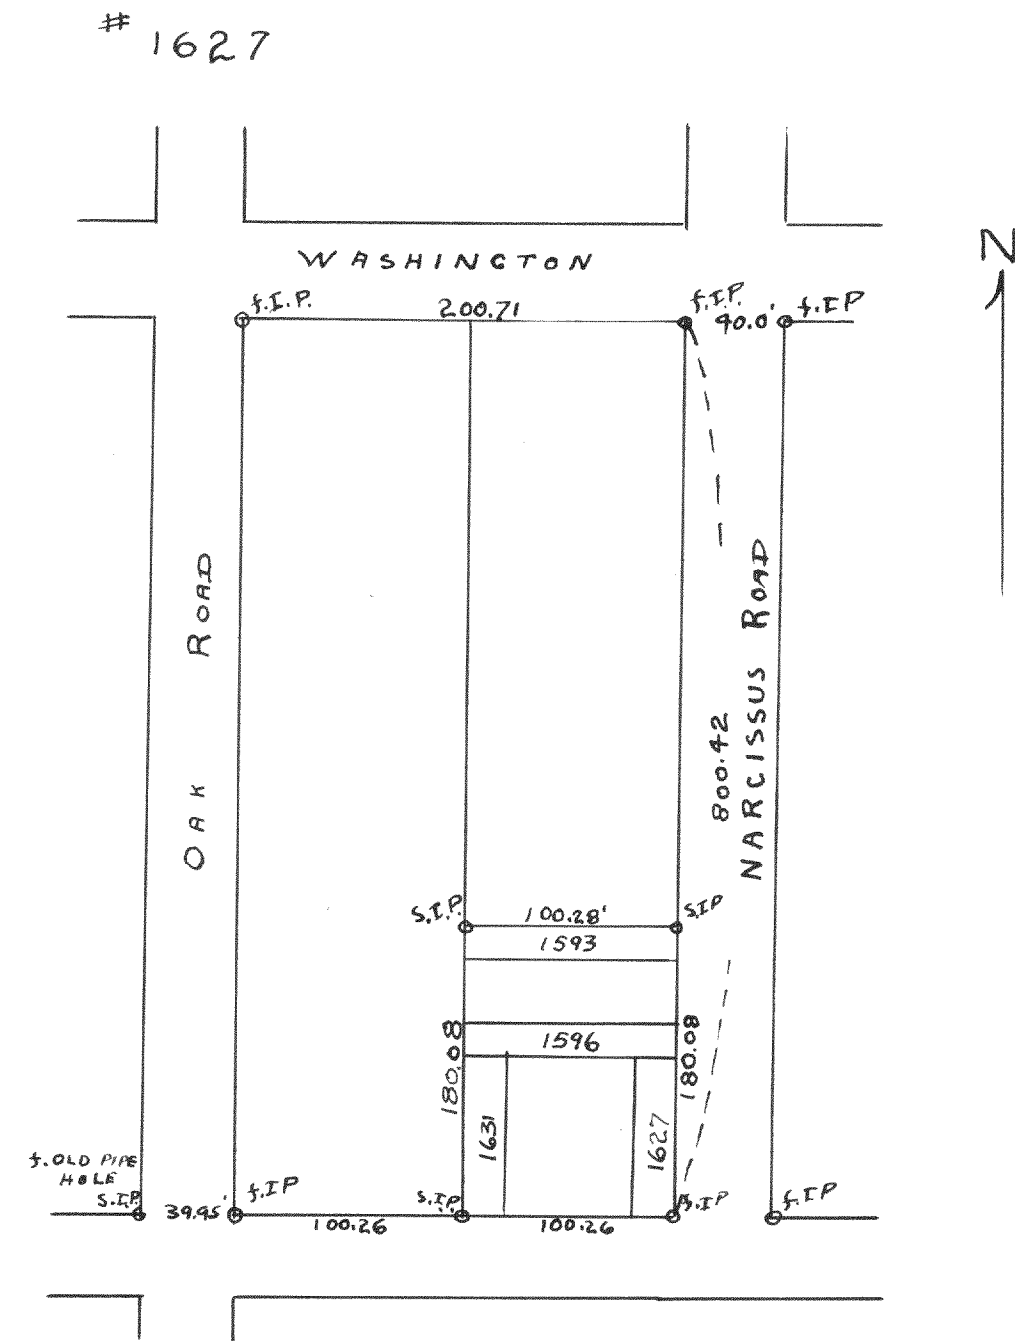

Plat of Survey of Lots 1593 to 1596 and Lots 1627 to 1631 in Lake Como Beach Subdivision
Walworth County Wisconsin

OCT. 1946

Lloyd L. Jensen
County Surveyor
G.T.D

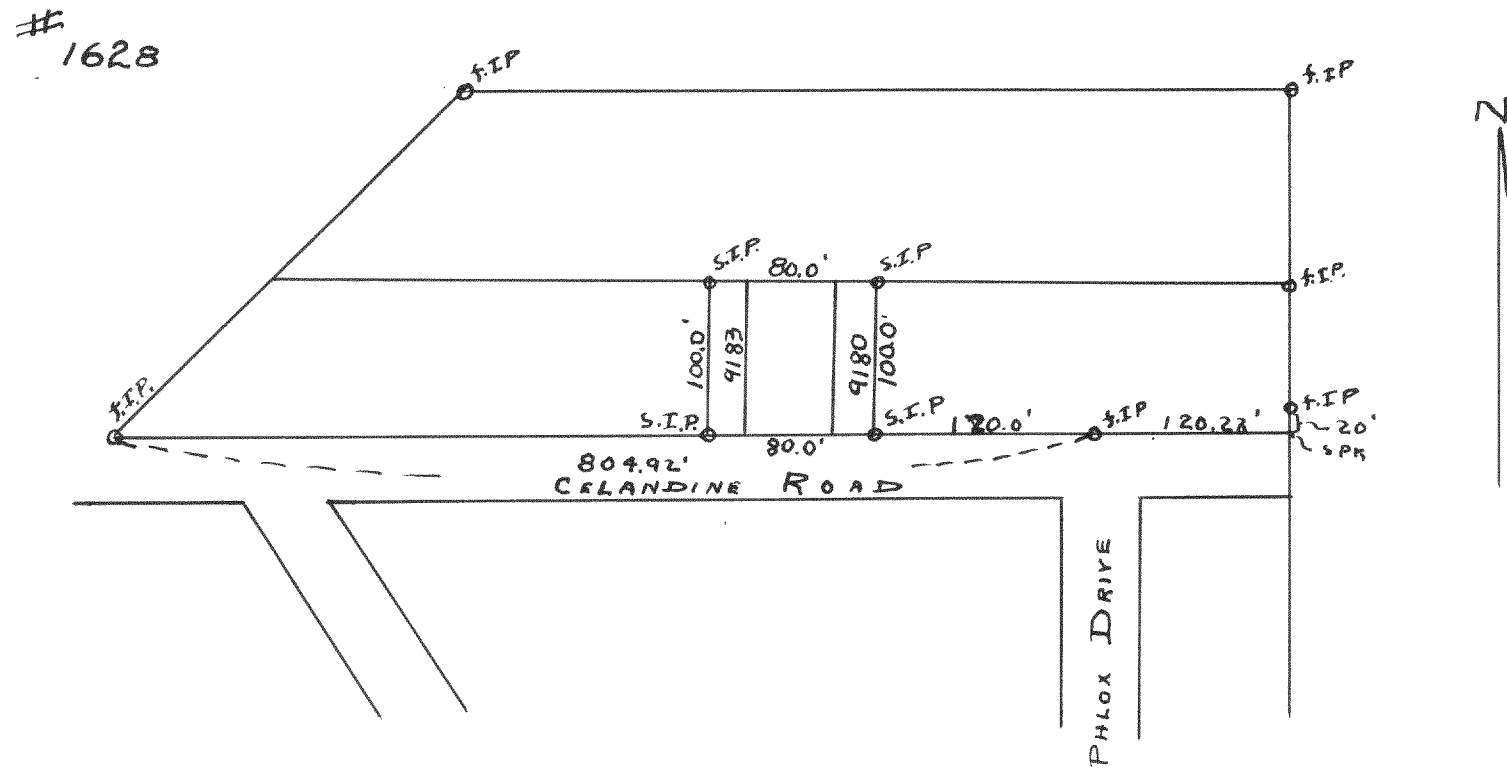

Plat of Survey of Lots 9180 to 9183 in
Section 5 of Bell Lake Subdivision, Walworth
County Wisconsin

OCT. 1946

Lloyd L. Jensen
County Surveyor
G.T.D