


1629

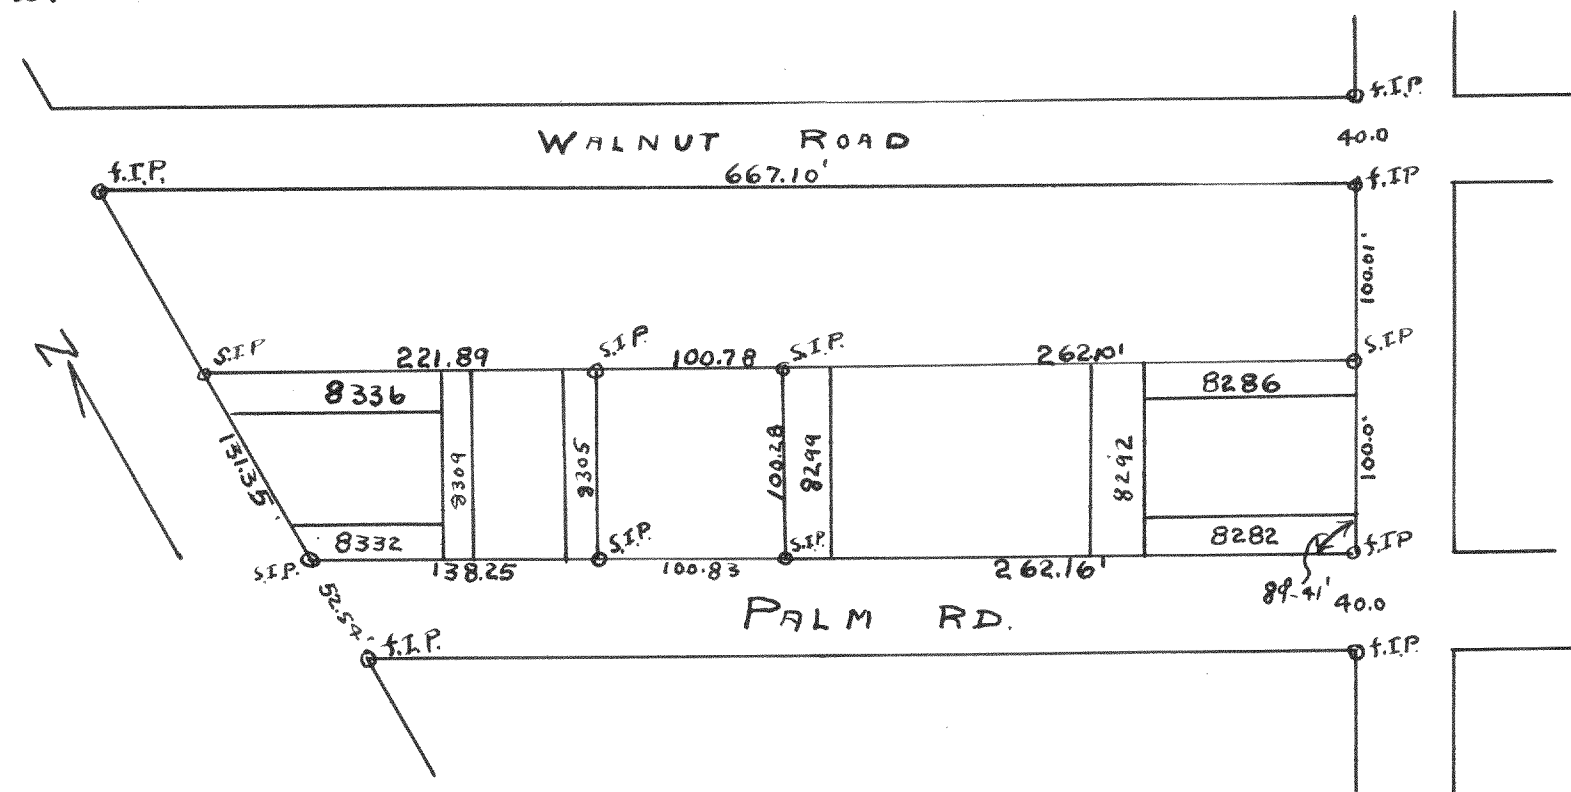


Plat of survey of Lots 8282 to 8286, Lots 8292 to 8299,
 Lots 8305 to 8309 and Lots 8332 to 8336 in Section 5
 of Pell Lake Subdivisions, Walworth County, Wisconsin

Oct 1946

Lloyd L. Jensen
 County Surveyor
 G.T.D

1630

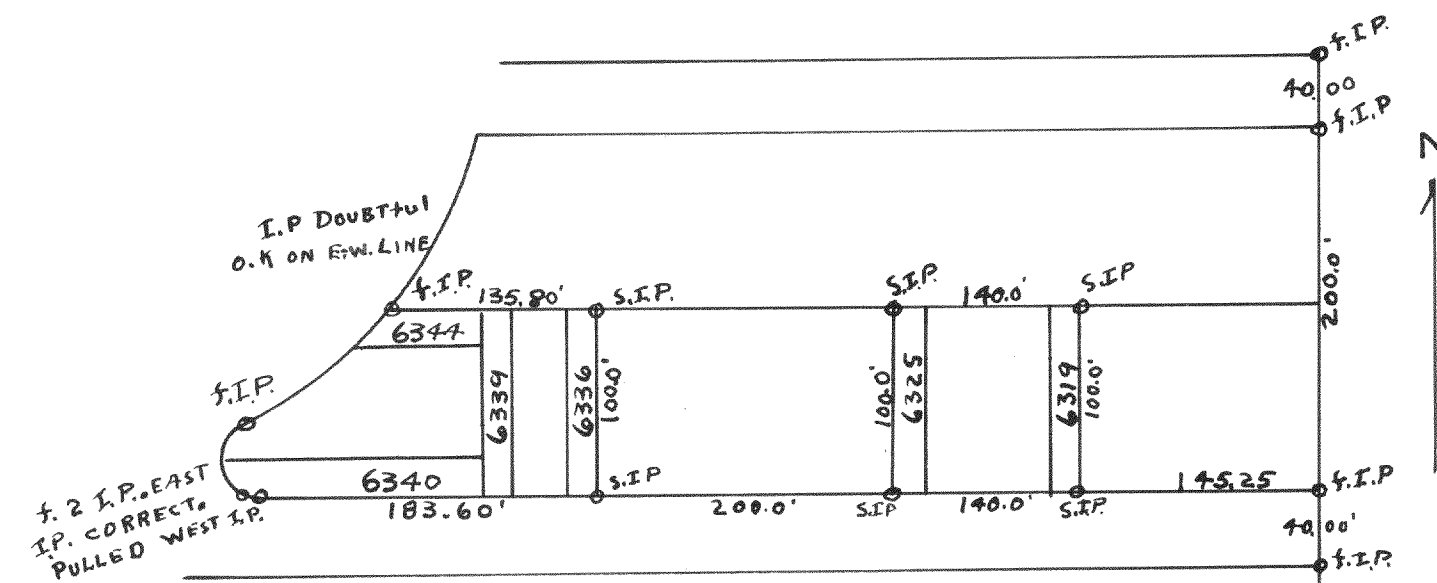

Plat of survey of Lots 6319 to 6325,
 Lots 6336 to 6339 and Lots 6340 to 6344
 in Section 4 of Pell Lake Subdivisions,
 Walworth County, Wisconsin

Oct. 1946

Lloyd L. Jensen
 County Surveyor
 G.T.D