


1631

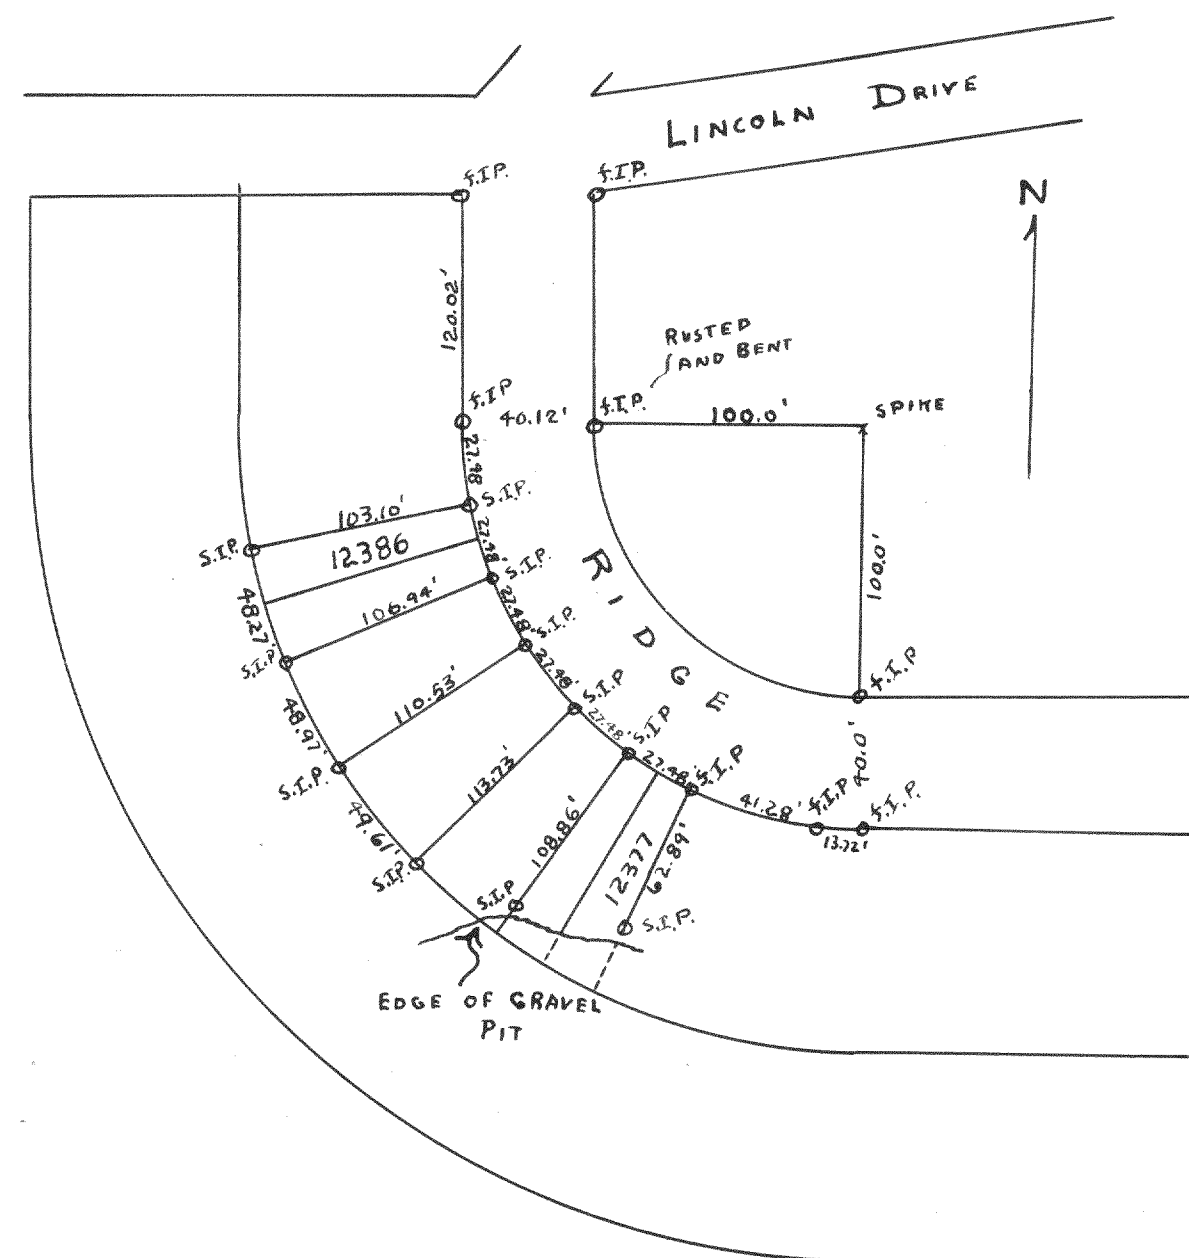


Plot of Survey of Lots 12377 to 12386 of
Lake Como Beach Subdivisions, Walworth
County, Wisconsin

Nov. 1946

Lloyd L. Jensen
County Surveyor
G.T.D.

1632

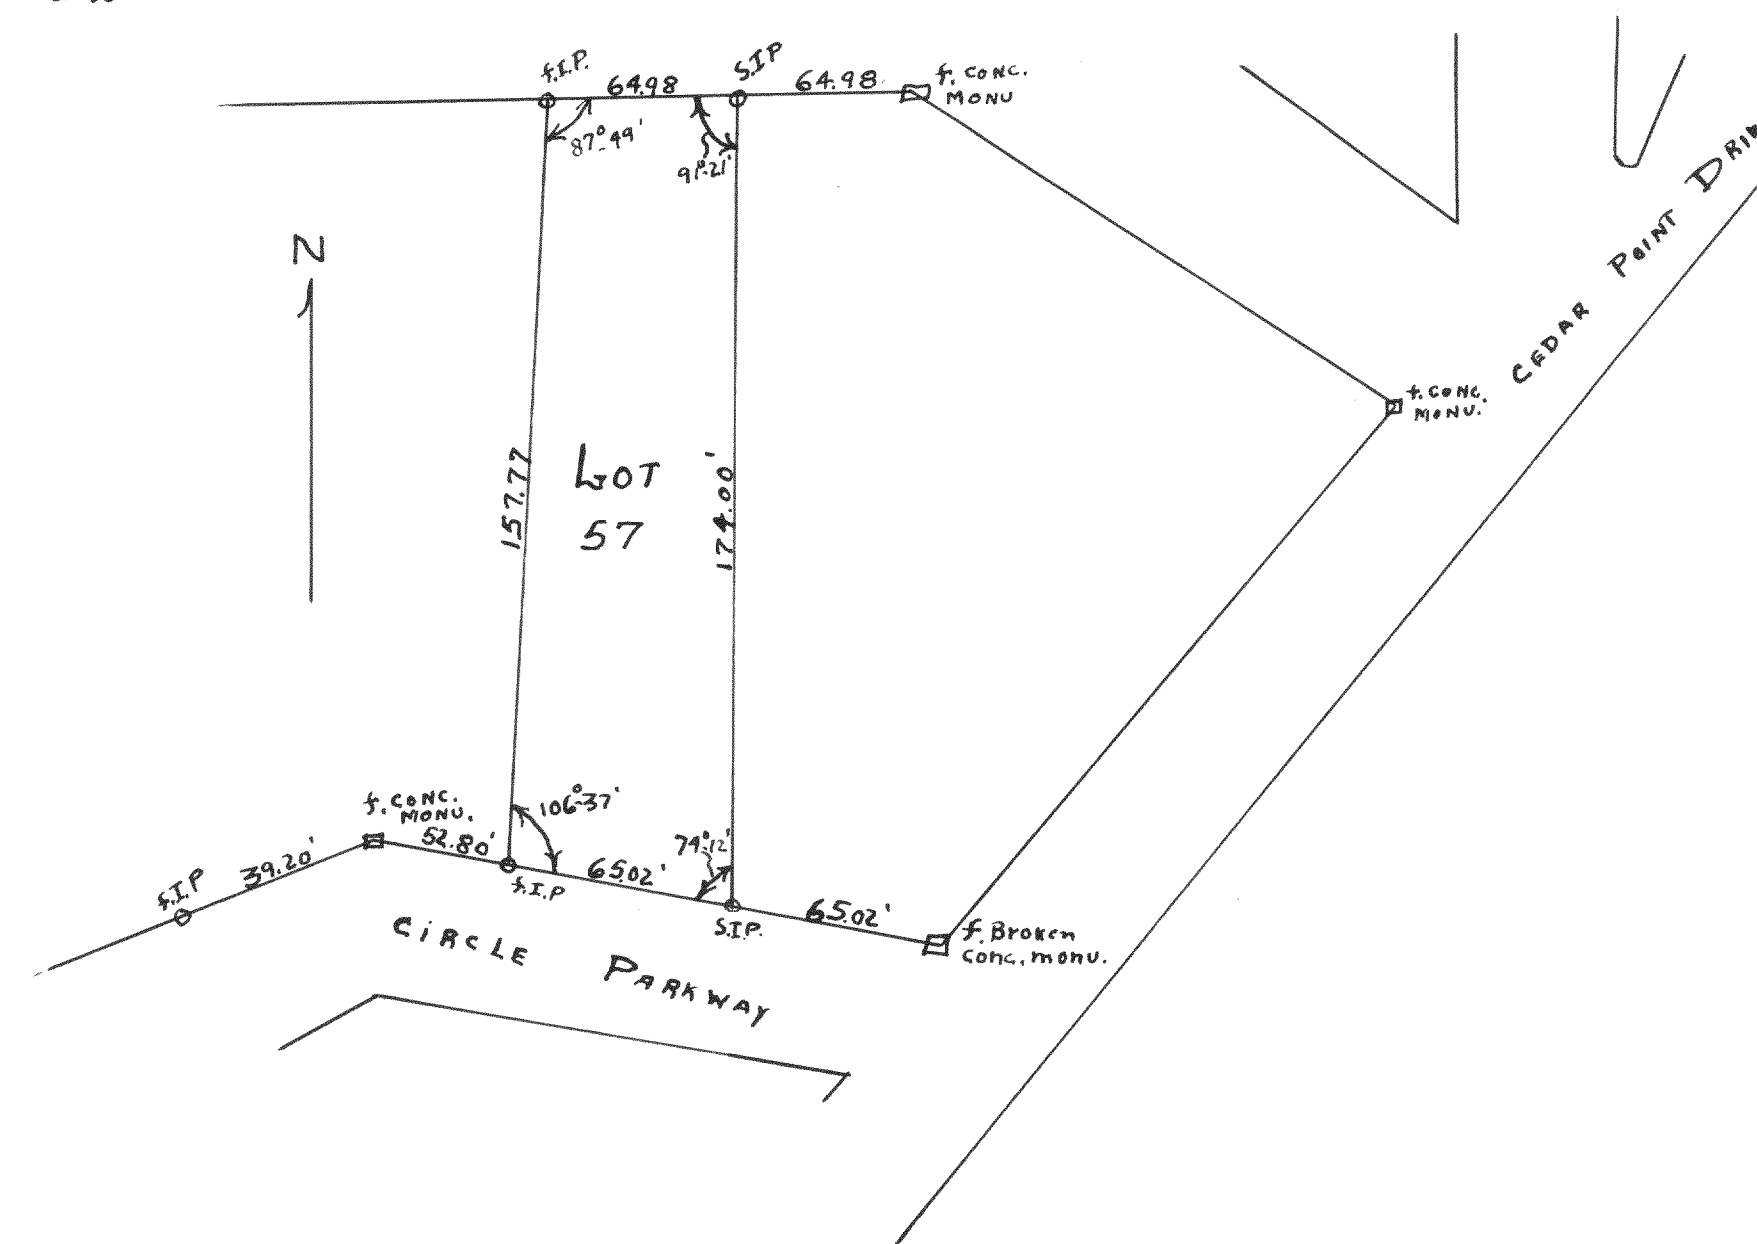

Plot of Survey of Lot 57 Cedar Point Park
3rd Addition in the Village of Williams Bay, Walworth
County, Wisconsin

Dec. 1946

Lloyd L. Jensen
County Surveyor
G.T.D.