



#1633

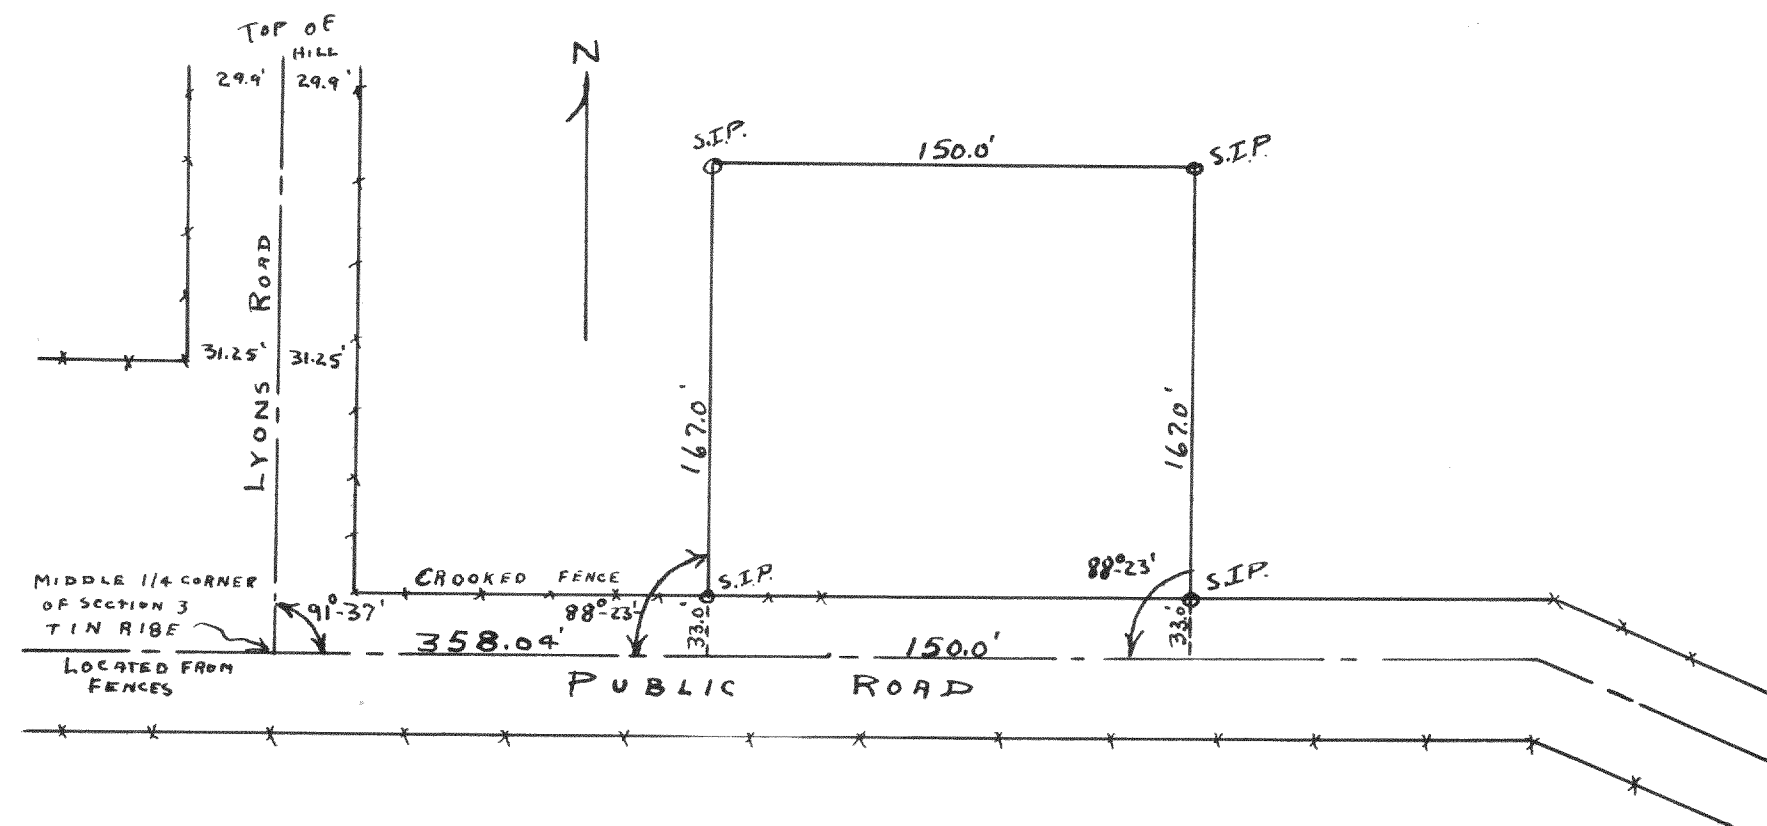

Plat of Survey of parcel of land owned by
Edmund Kerner located in the SW 1/4 of the NE 1/4
of Section 3 TIN RIBE of Malworth County, Wisconsin
Jan. 1947
Lloyd L. Jensen
County Surveyor
G.T.D.

#1634

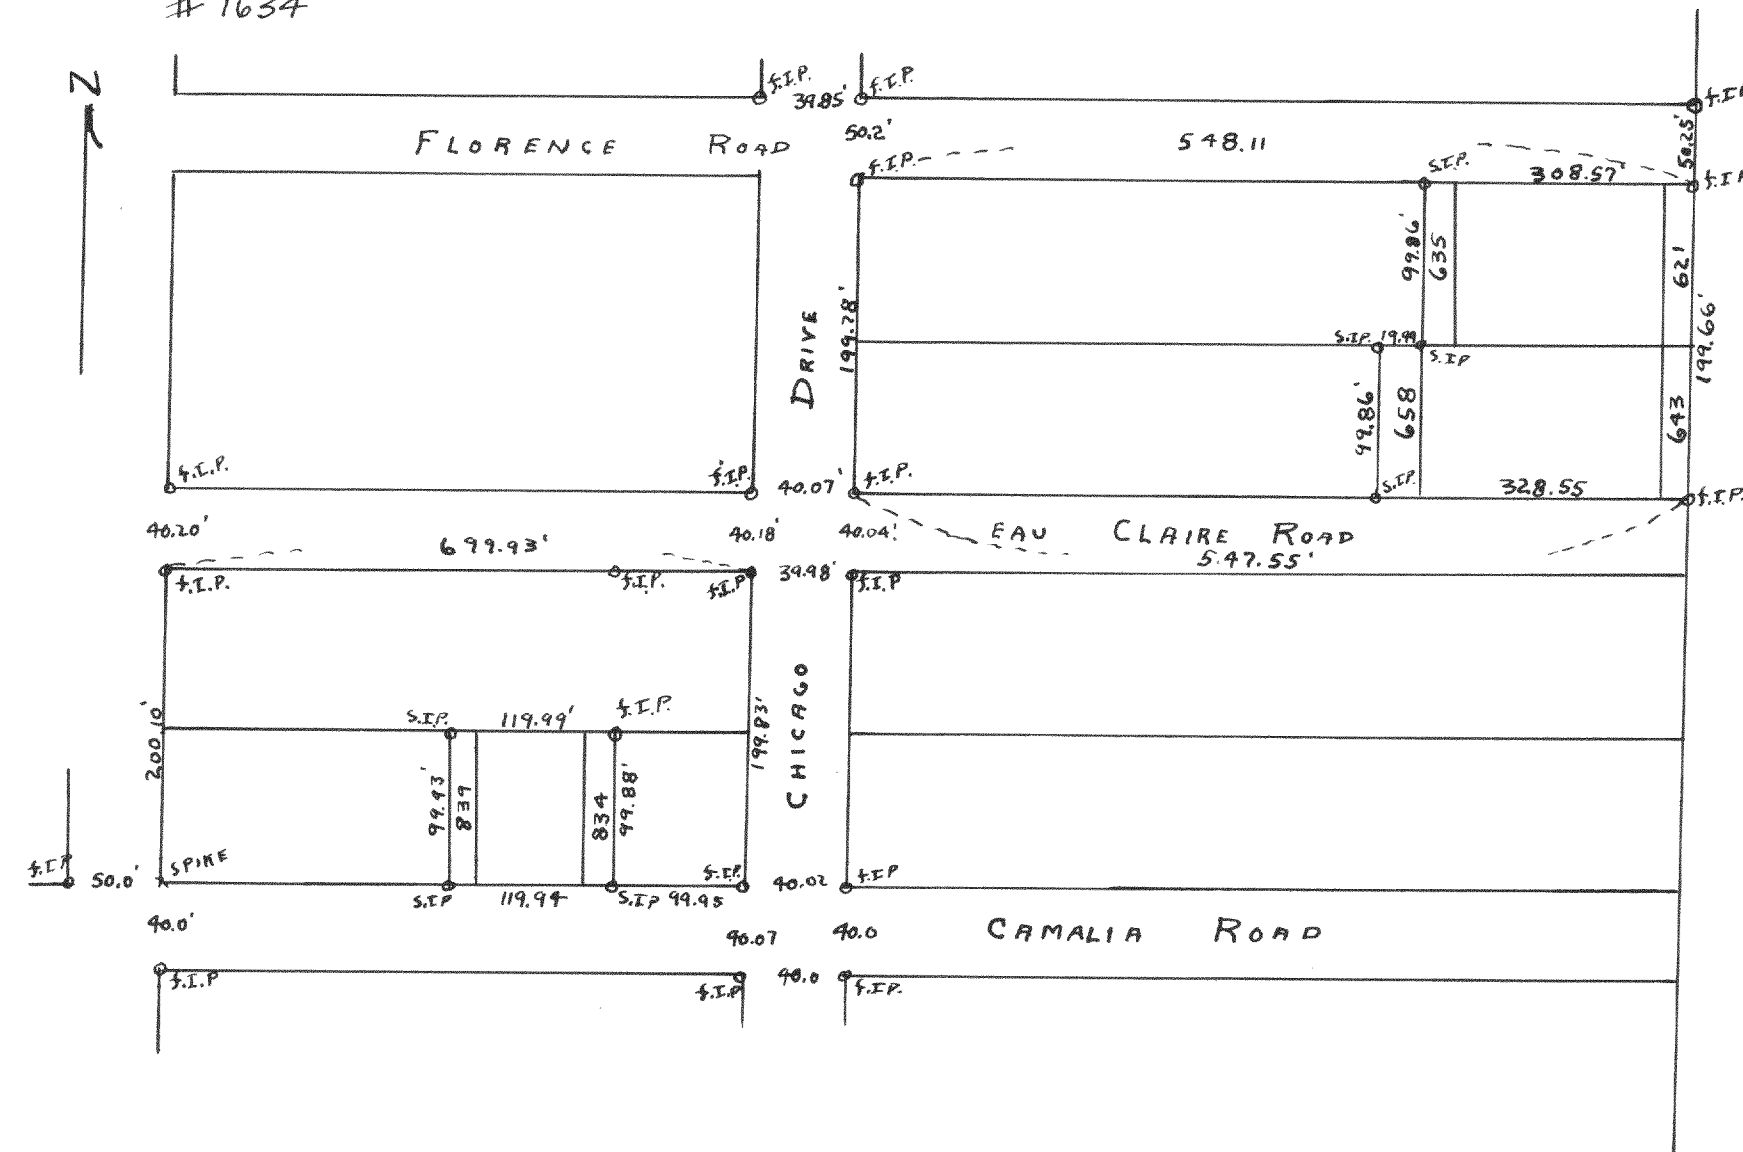

Plat of Survey of Lots 834 to 839, Lots 621 to 635, and
Lots 643 to 658 in Bell Lake Addition, Malworth County, Wisconsin
Lloyd L. Jensen
County Surveyor
G.T.D.