



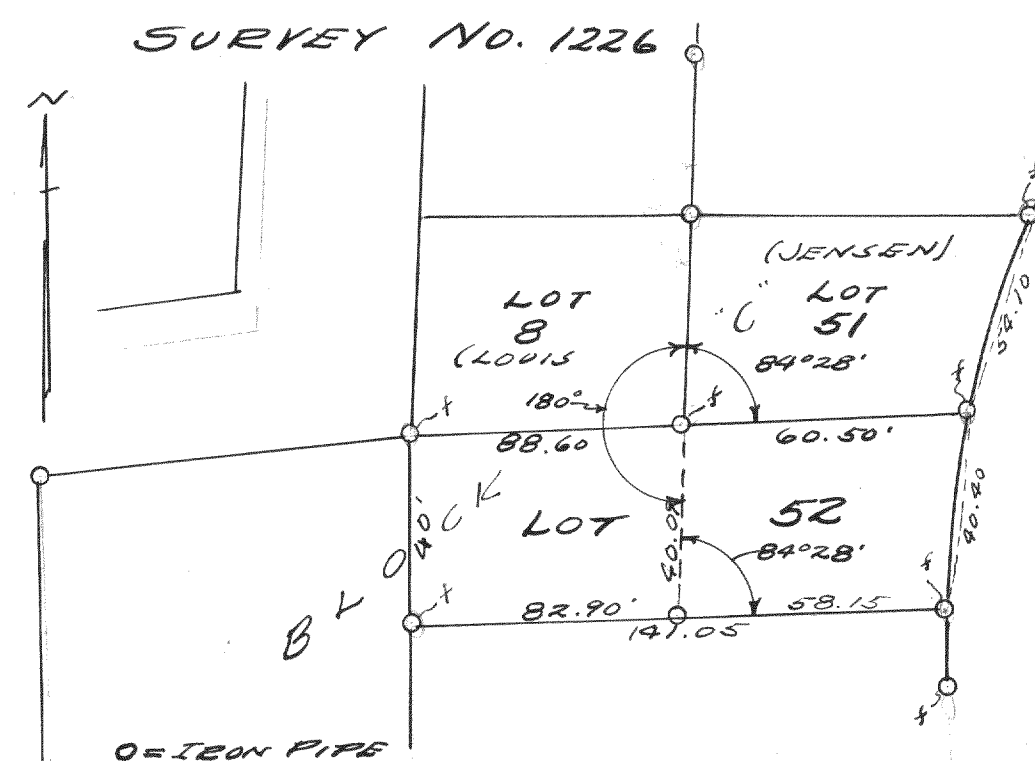

PLAT OF SURVEY OF LOT 52 OF
BLOCK "C" OF CISCO BEACH SUBD.

AUG. 1941


Lloyd L Jensen
W.E.G.

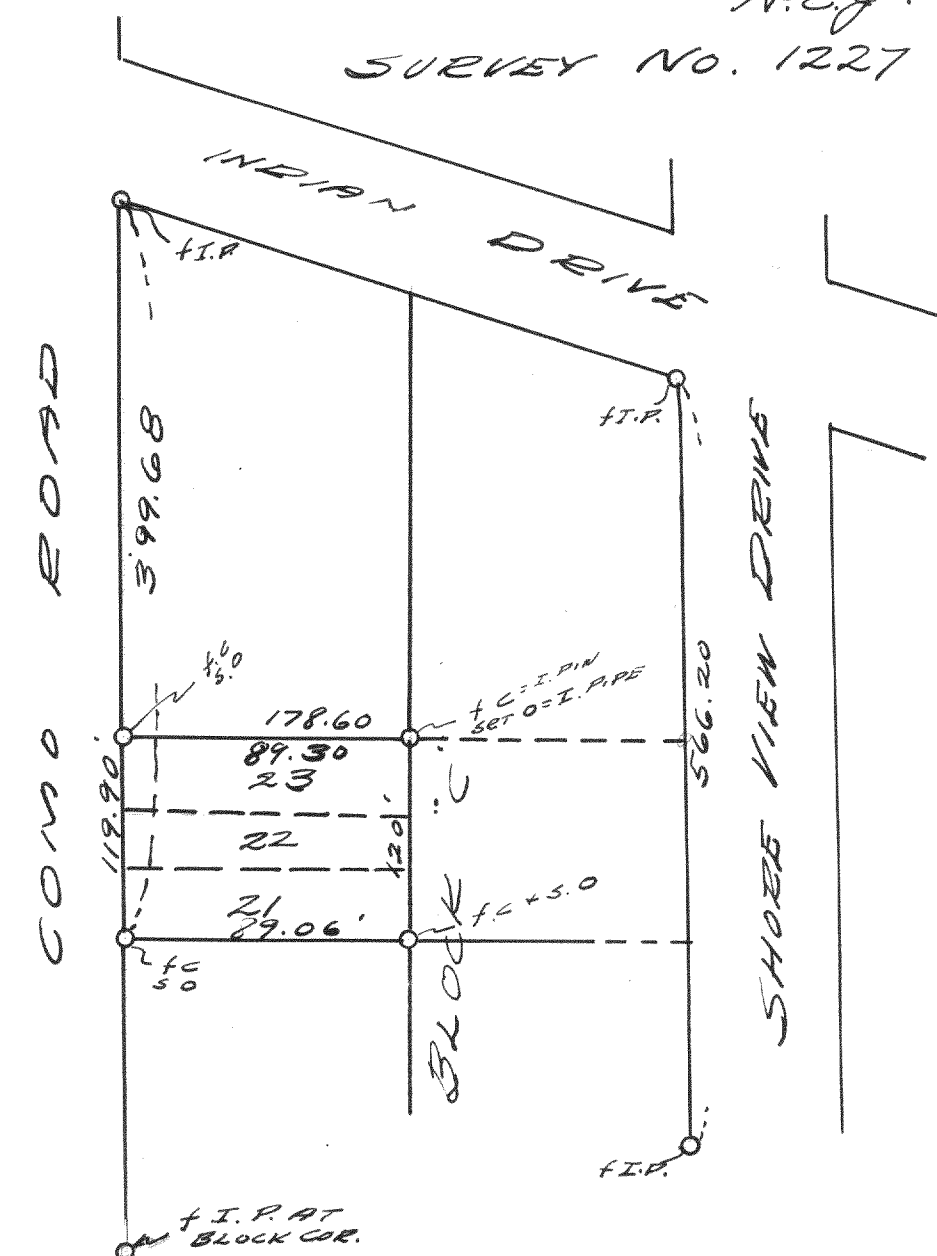

SURVEY OF LOTS 21 TO 23, BLOCK "C"

OF CISCO BEACH SUBD.

Lloyd L Jensen
K.E.D.

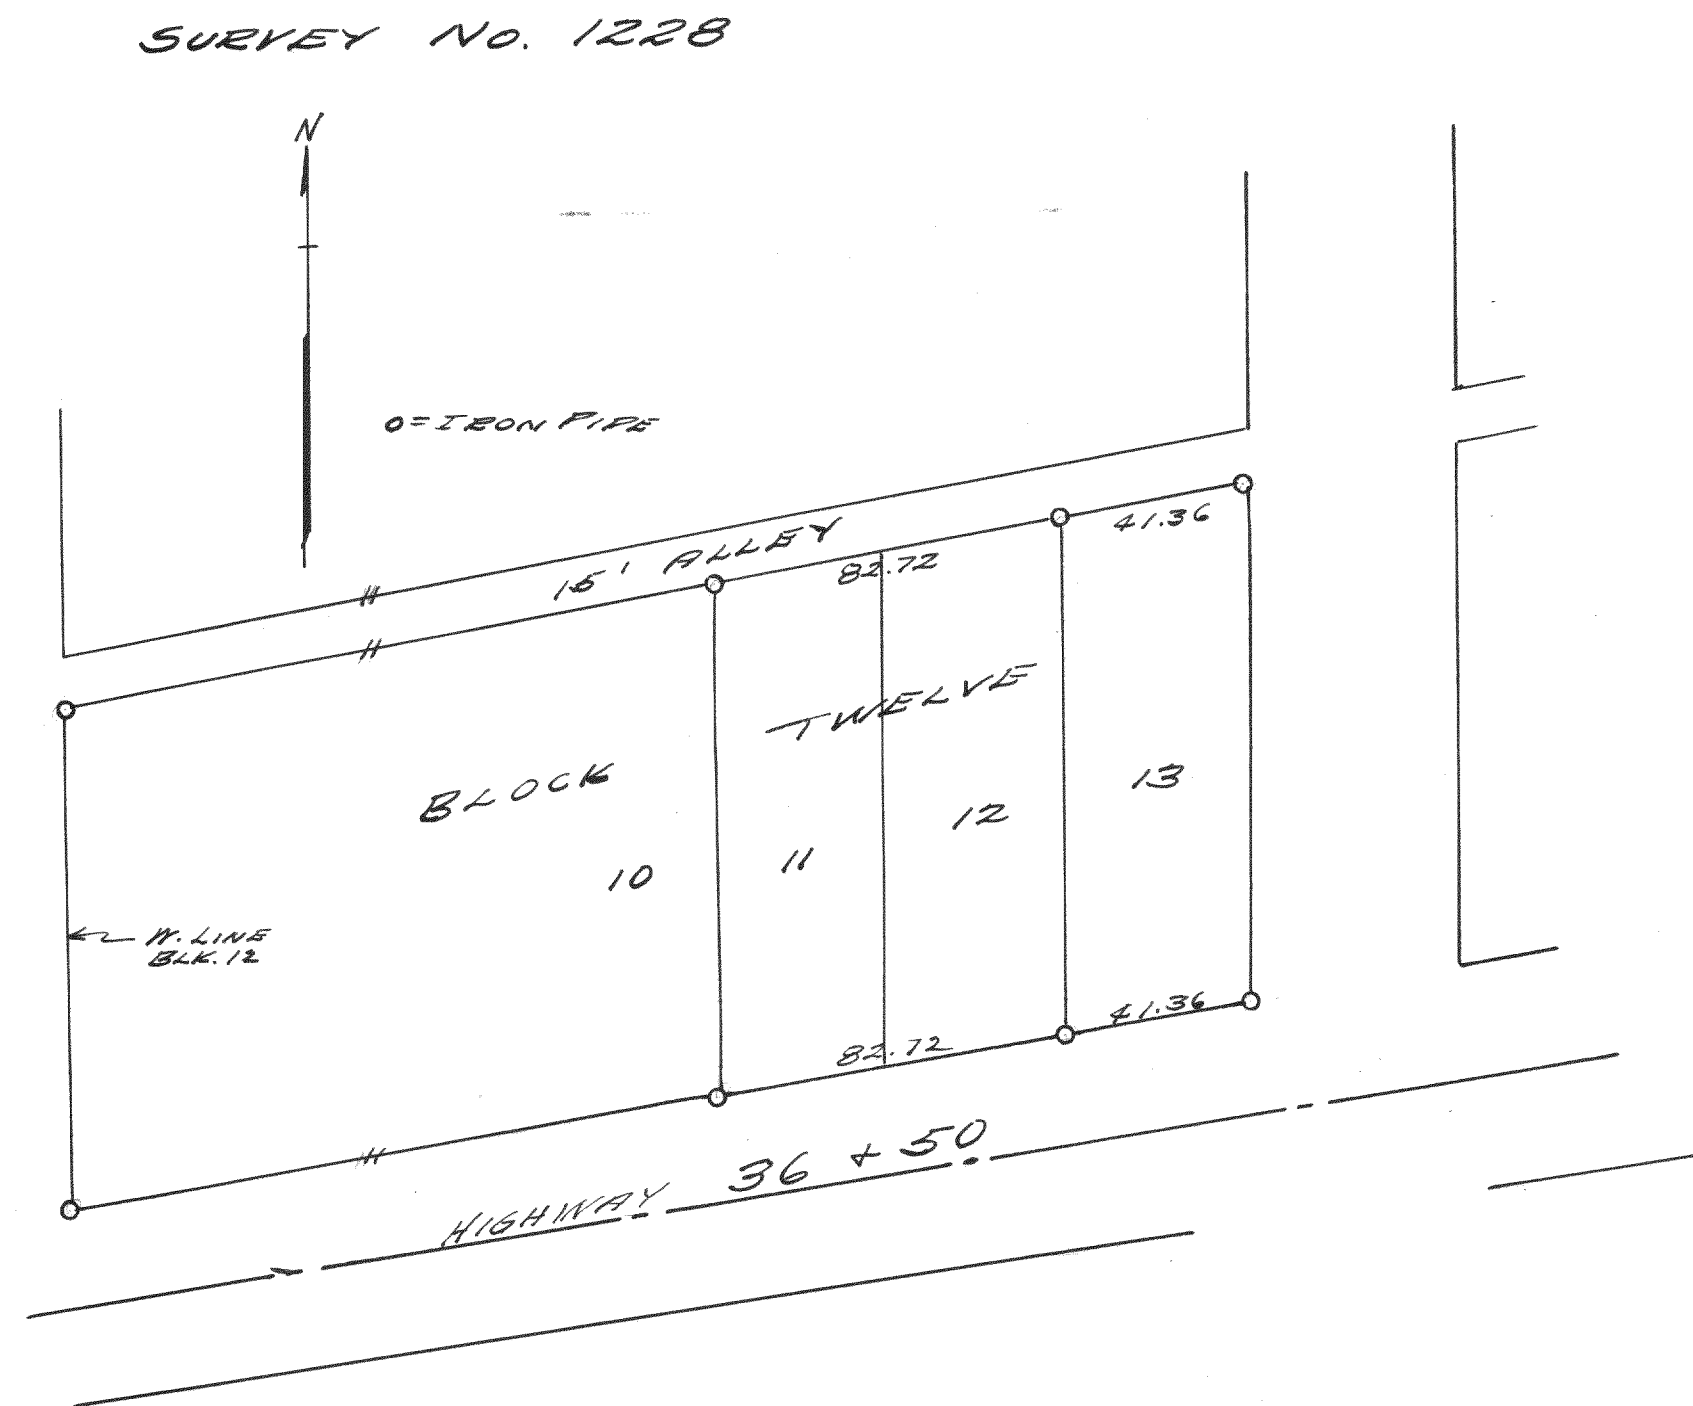

PLAT OF SURVEY OF LOTS 11 & 12 OF BLK. 12
OF UNIT "B" OF SUNSET HILLS SUBD., WAL.
COUNTY, WISCONSIN.

DEC. 6, 1941

Lloyd L Jensen
R.E.J.