



#1637

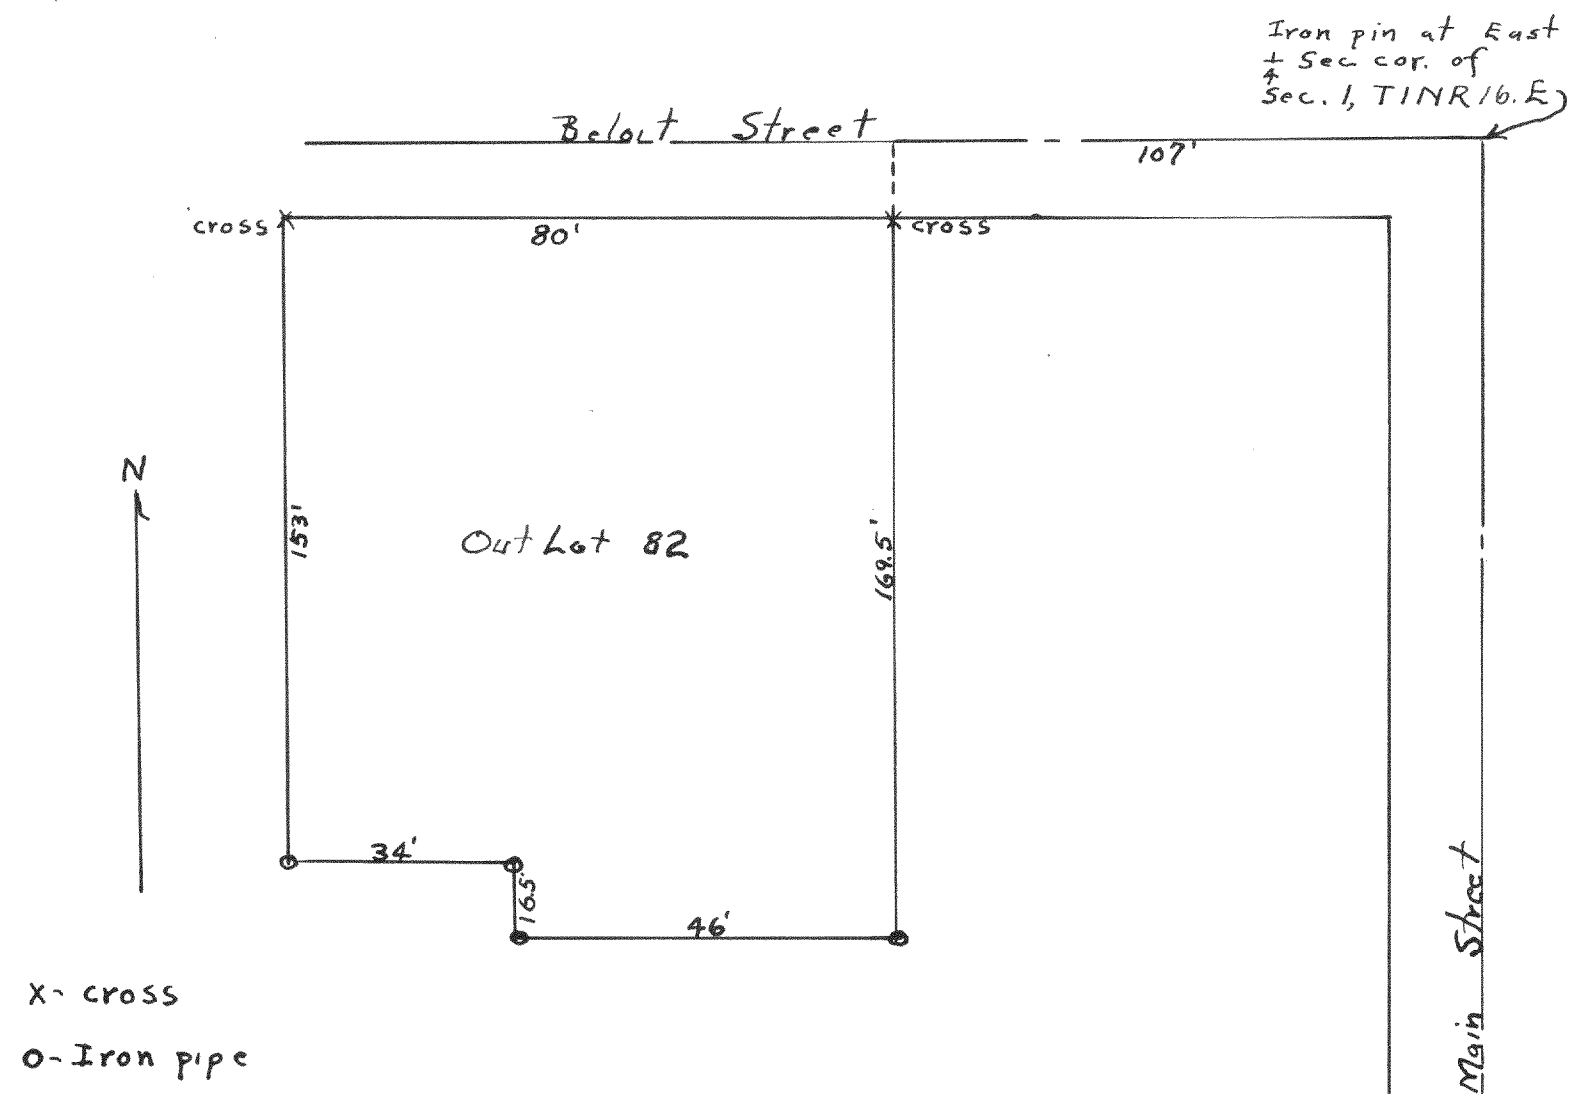

Plat of survey of a parcel of land located
in the SE 1/4 of section 21, T1N R16E, Village
of Walworth, known as outlot 82, Walworth
County, Wisconsin
March 7, 1946

Lloyd J. Jensen
County Surveyor
G.T.D.

#1638

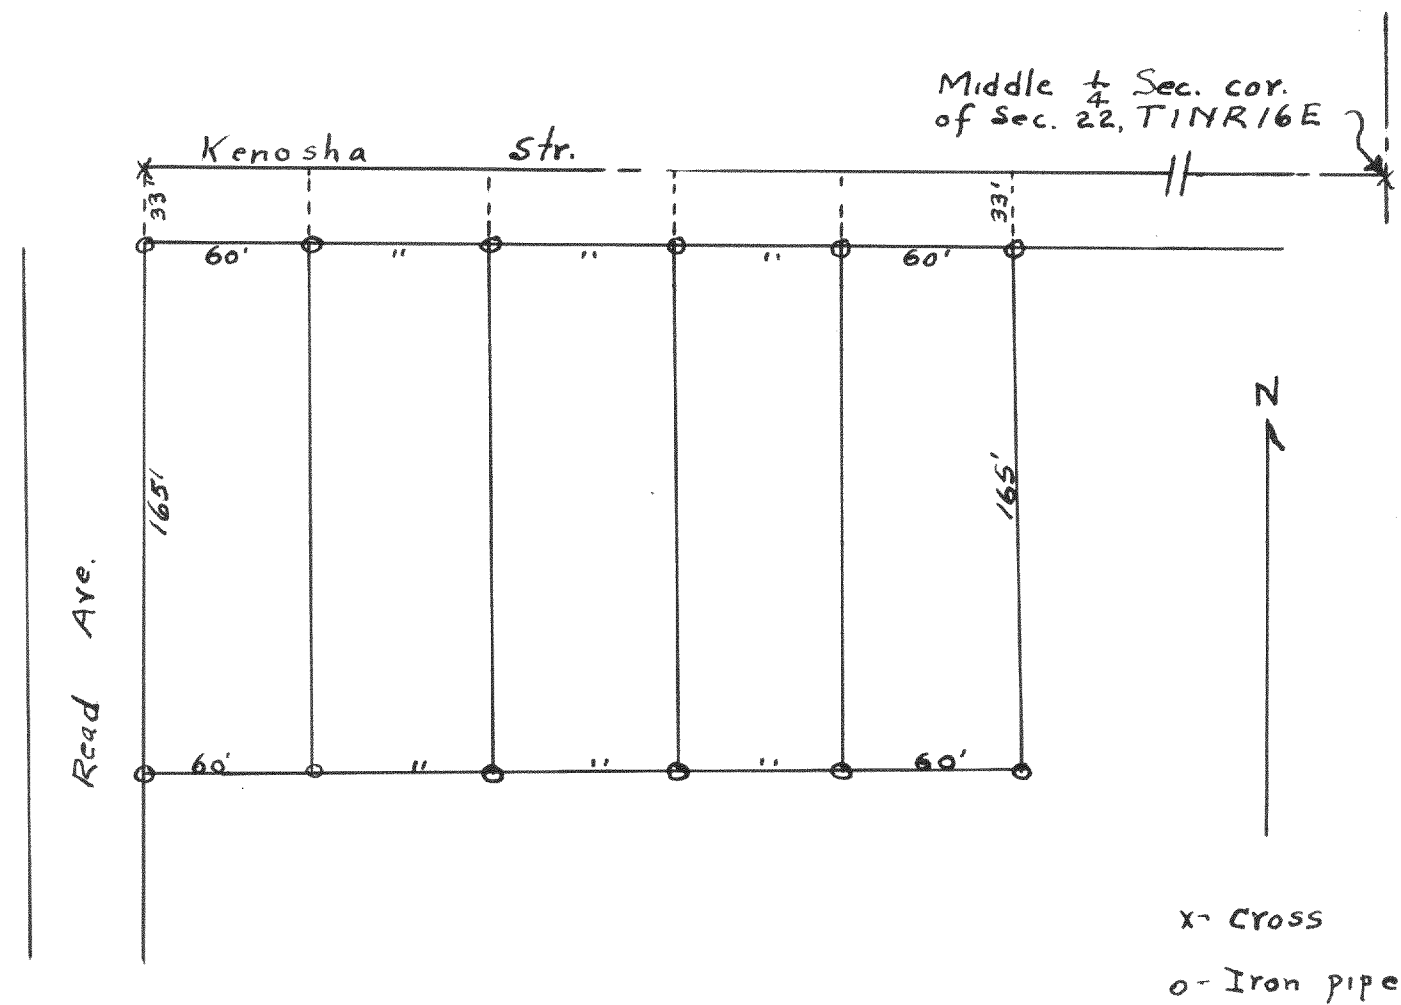

Plat of survey of part of outlot 218 of the Village
of Walworth, Walworth County, Wisconsin

July 2, 1946

Lloyd J. Jensen
County Surveyor
G.T.D.