


#1641

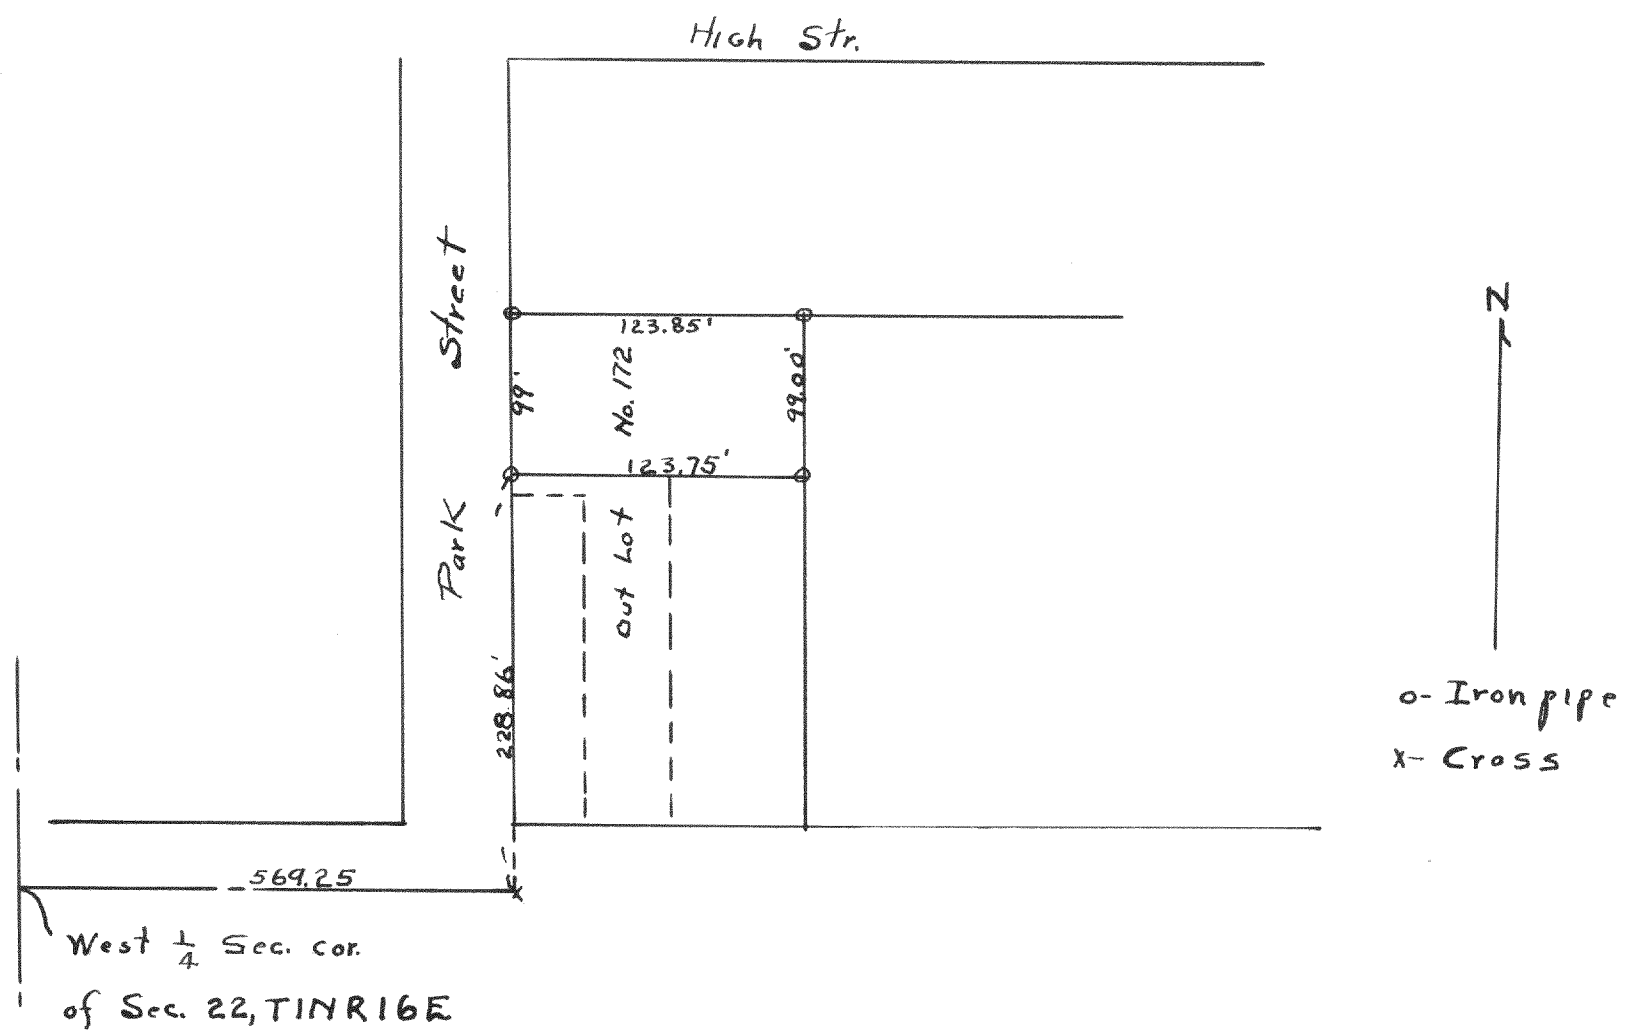


Plat of part of Outlot No. 172 of Assessors
plat of the Village of Walworth, Walworth County, Wisconsin

June 1946

Lloyd L. Jensen
County Surveyor

G.T.D.

#1642

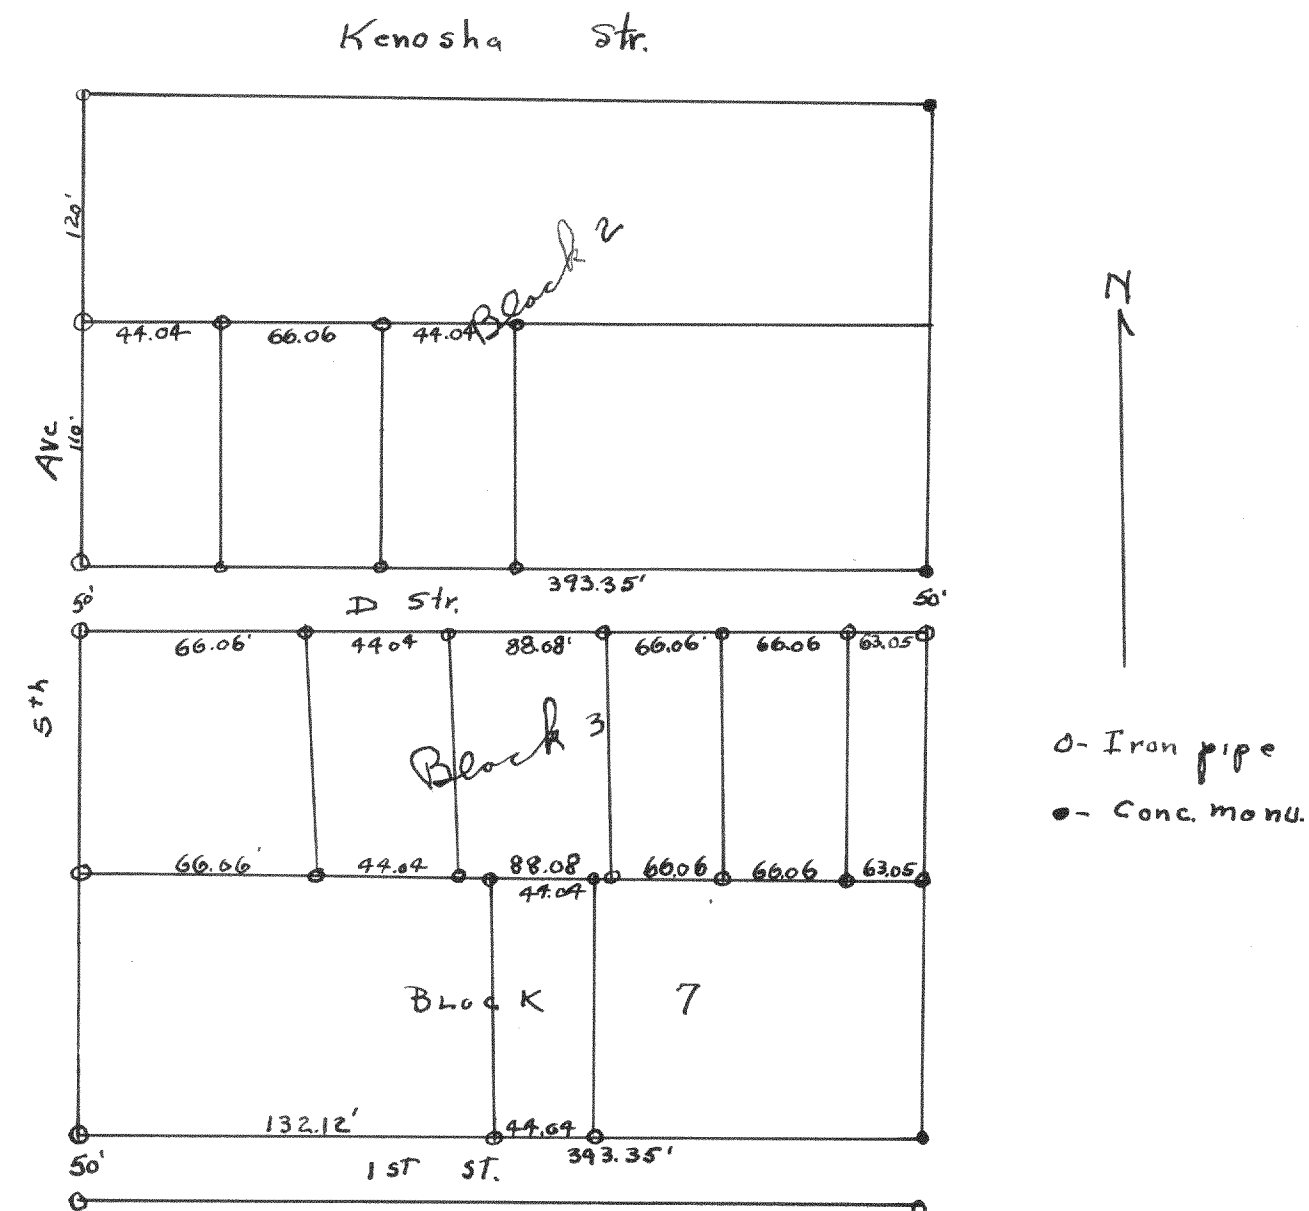

Plat of survey of part of Block 2 and all of Block 3
of East side Addition and part of Block 7 of East
side 2nd Addition to the Village of Walworth,
Walworth County, Wisconsin

1946

Lloyd L. Jensen
County Surveyor
G.T.D.