



#1643

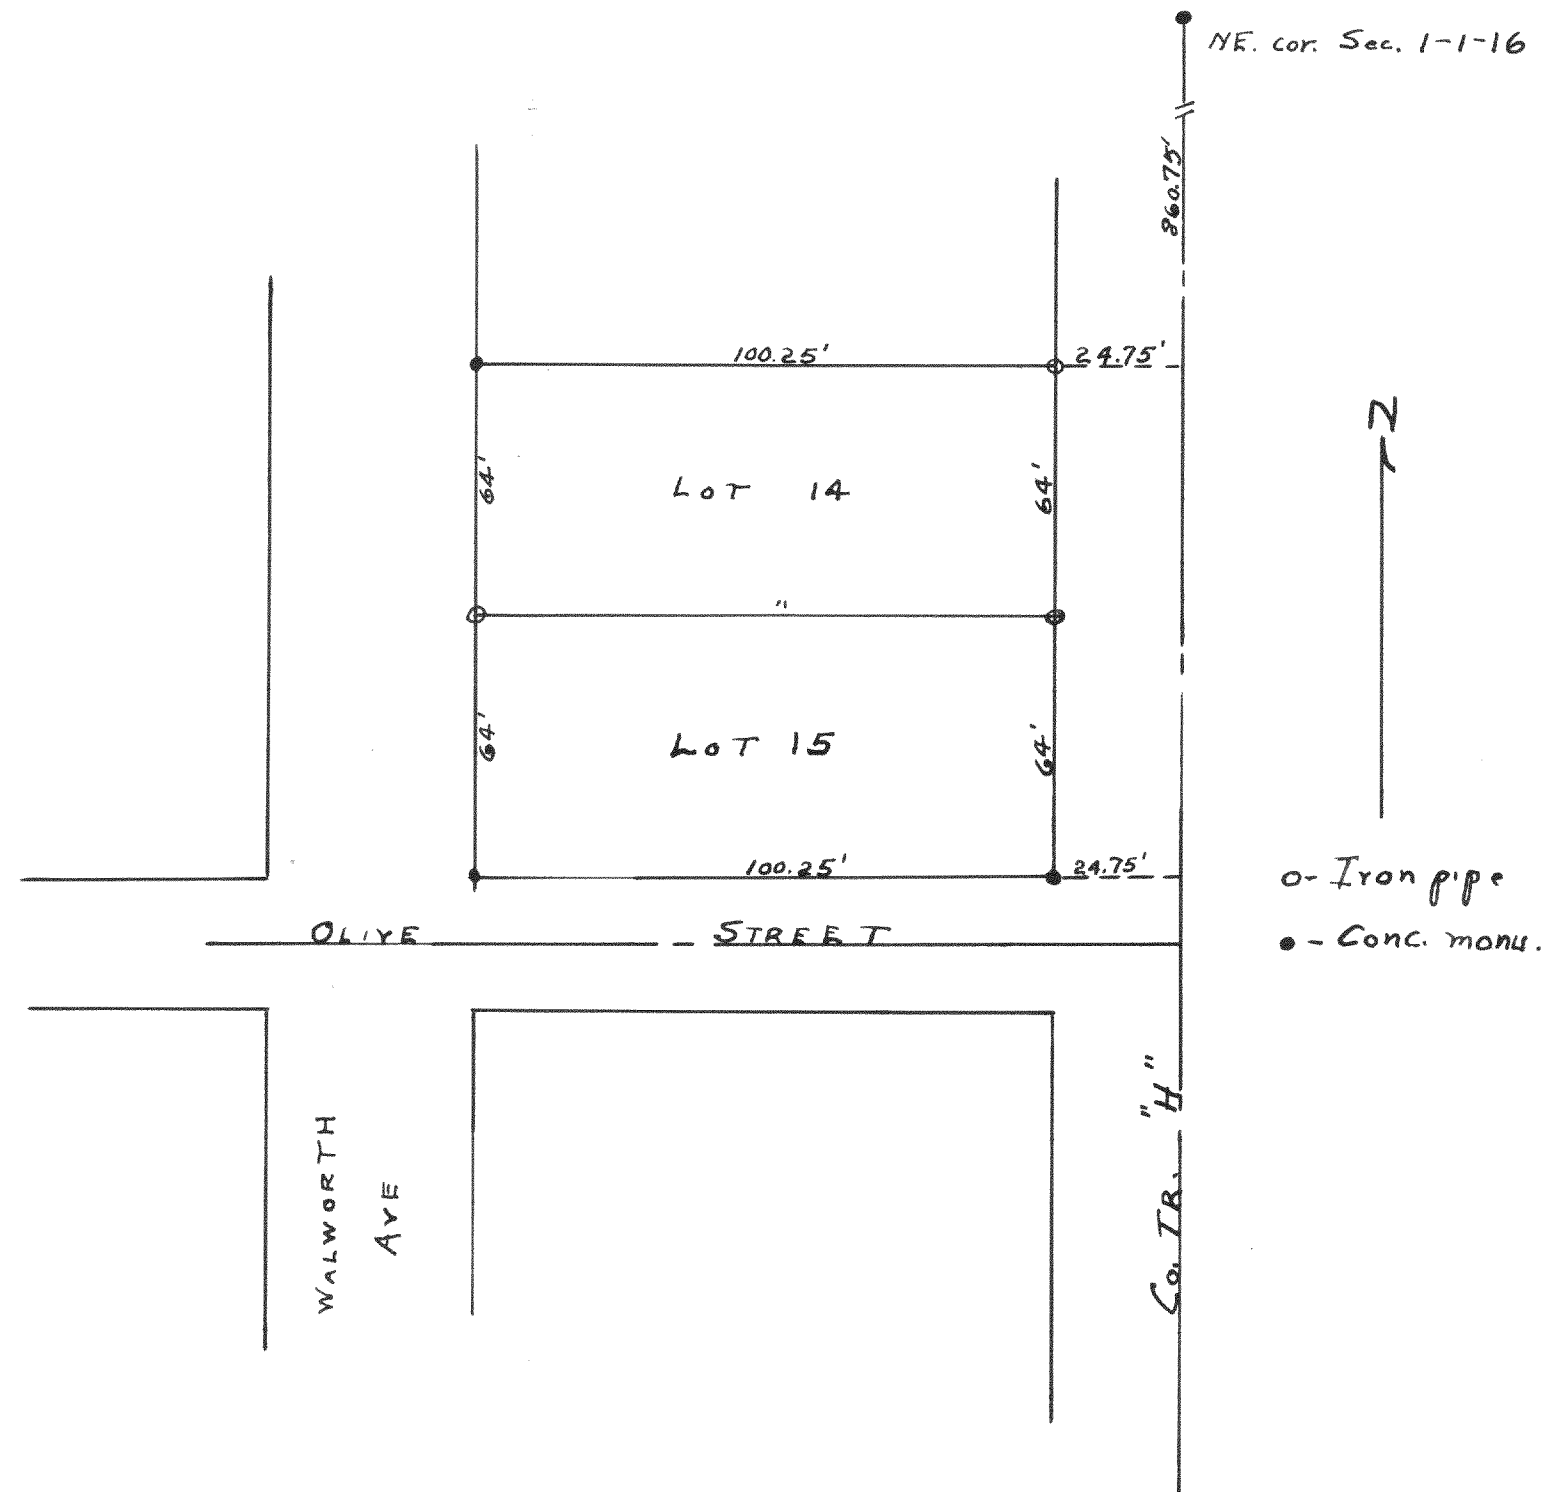

Plot of survey of lots 14 and 15 of
Wm. H. Francis subdivision in the
Village of Williams Bay, Walworth County Wisconsin
Dec. 1946
Lloyd L. Jensen
County Surveyor
G.T.D.

#1644

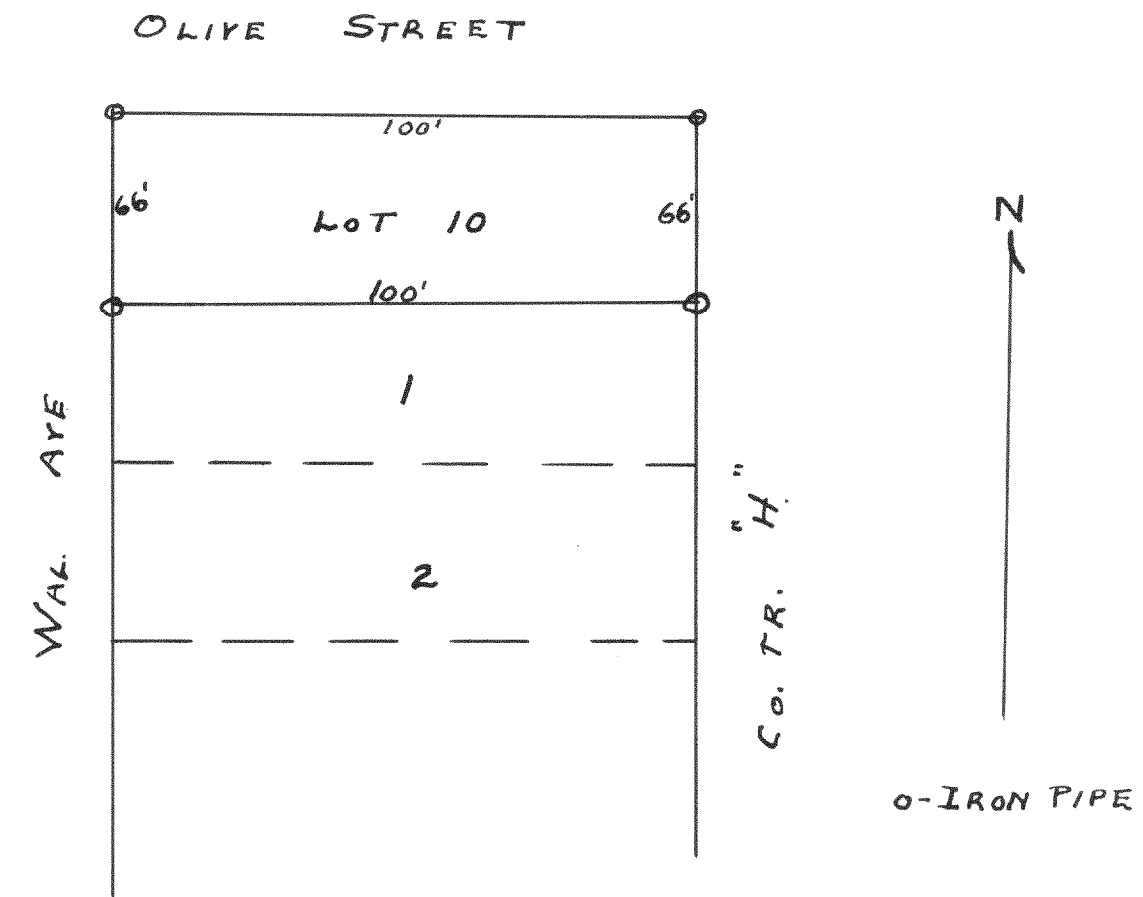

Plot of survey of lot 10 of Addition No. 1
to the Village of Williams Bay, Walworth County
Wisconsin

Dec. 1946

Lloyd L. Jensen
County Surveyor
G.T.D.