


#1645

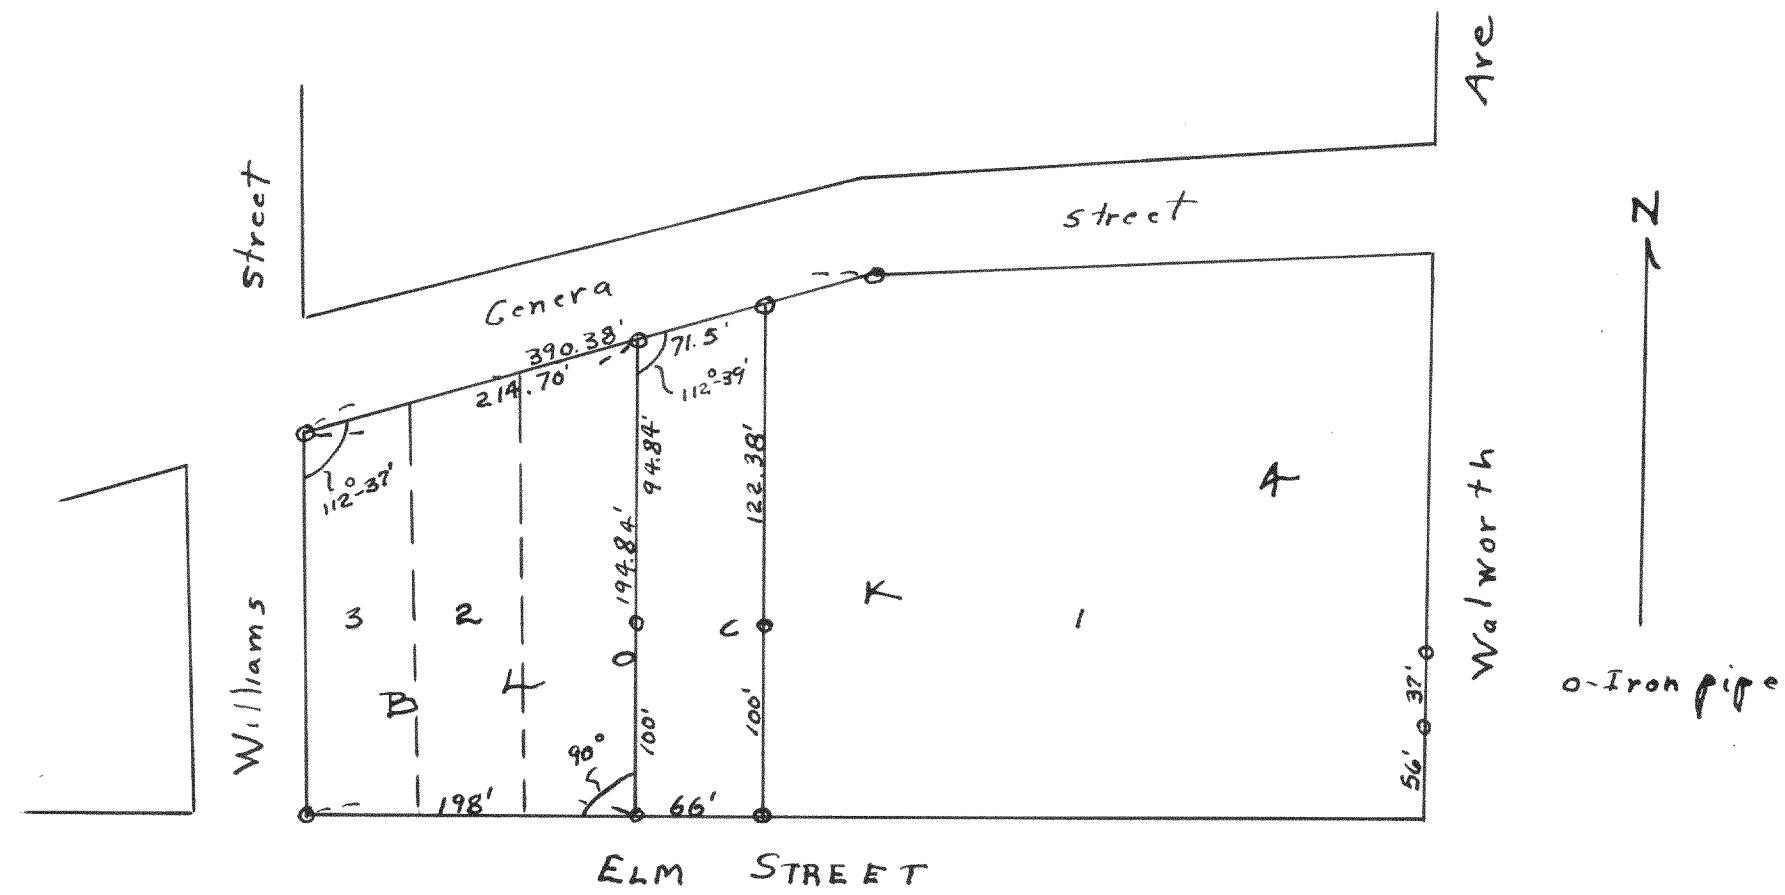


Plat of survey of part of lot 1 of Block 4 of
the original plat of the Village of Williams
Bay, Walworth County, Wisconsin

May 25, 1946

Lloyd L. Jensen
County Surveyor
G.T.D.

#1646

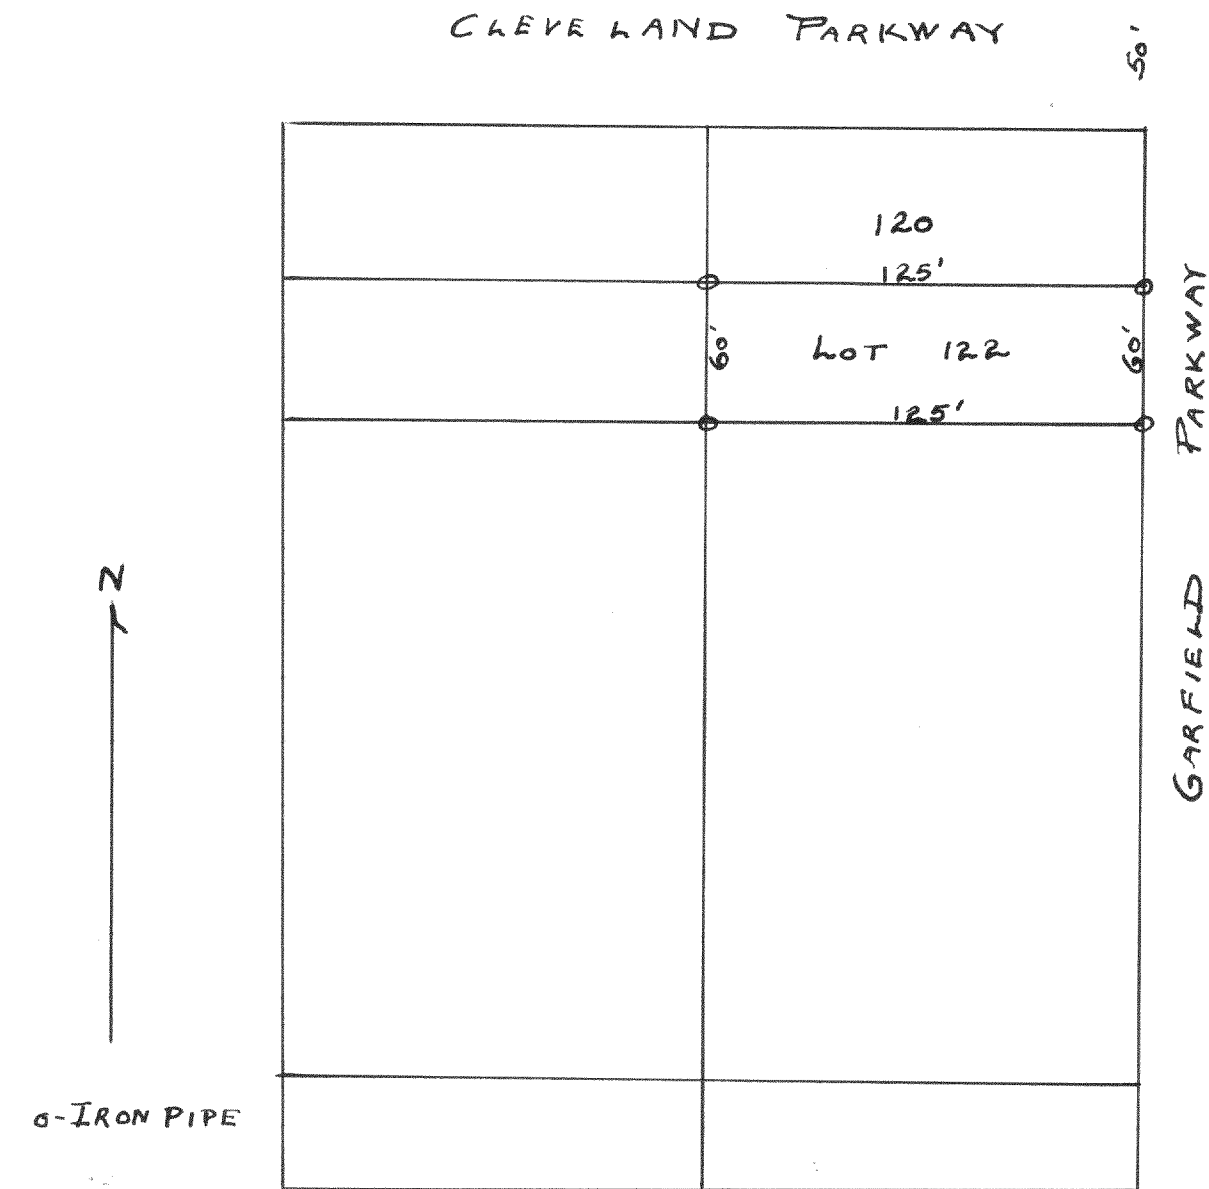

Plat of survey of lot 122 of the original
Cedar Point Park subdivision of Williams
Bay, Walworth County, Wisconsin

Sept. 1946

Lloyd L. Jensen
County Surveyor
G.T.D.