




#1647

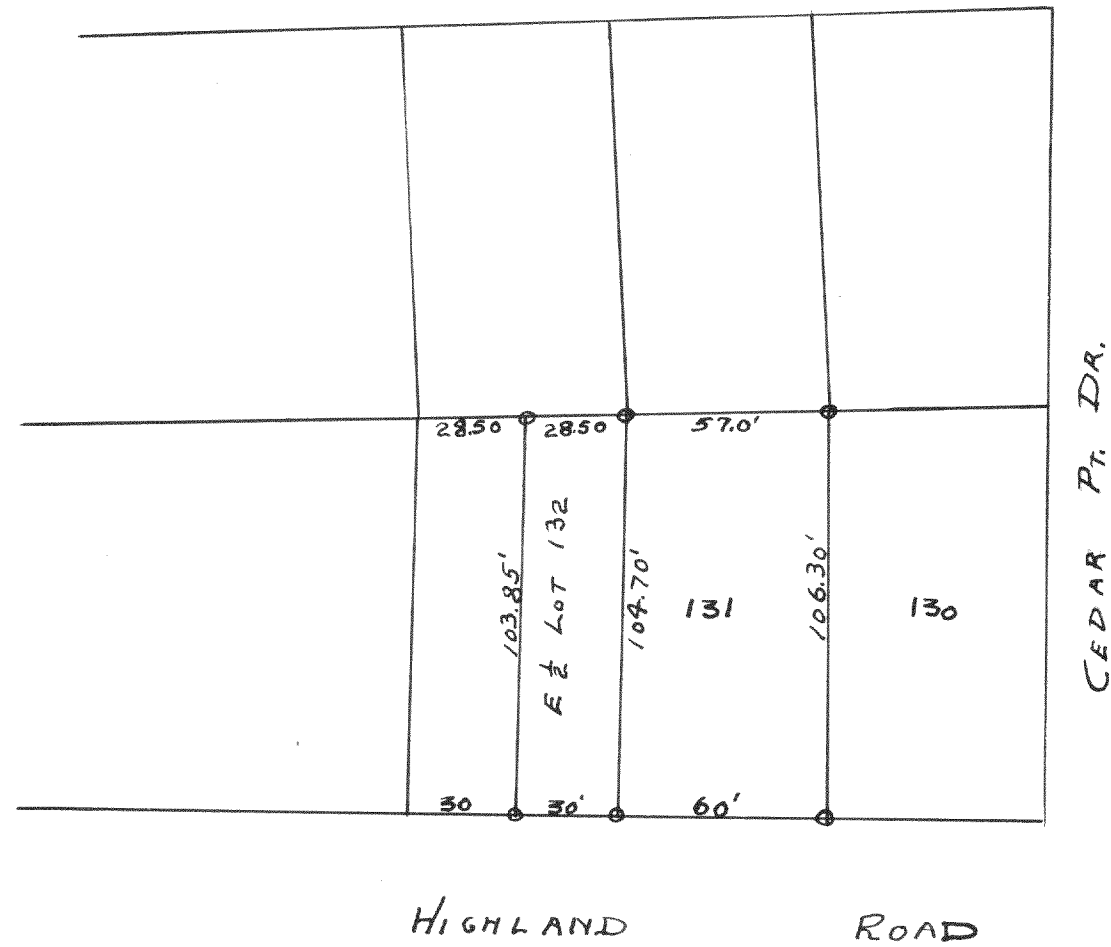

Plat of survey of lot 131 and the East 1/2
of lot 132 of the 2nd Addition to Cedar Point
Park, Williams Bay, Wisconsin
May 23, 1946
Lloyd L. Jensen
County Surveyor
G.T.D

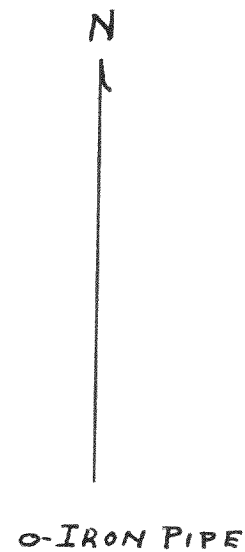

#1648

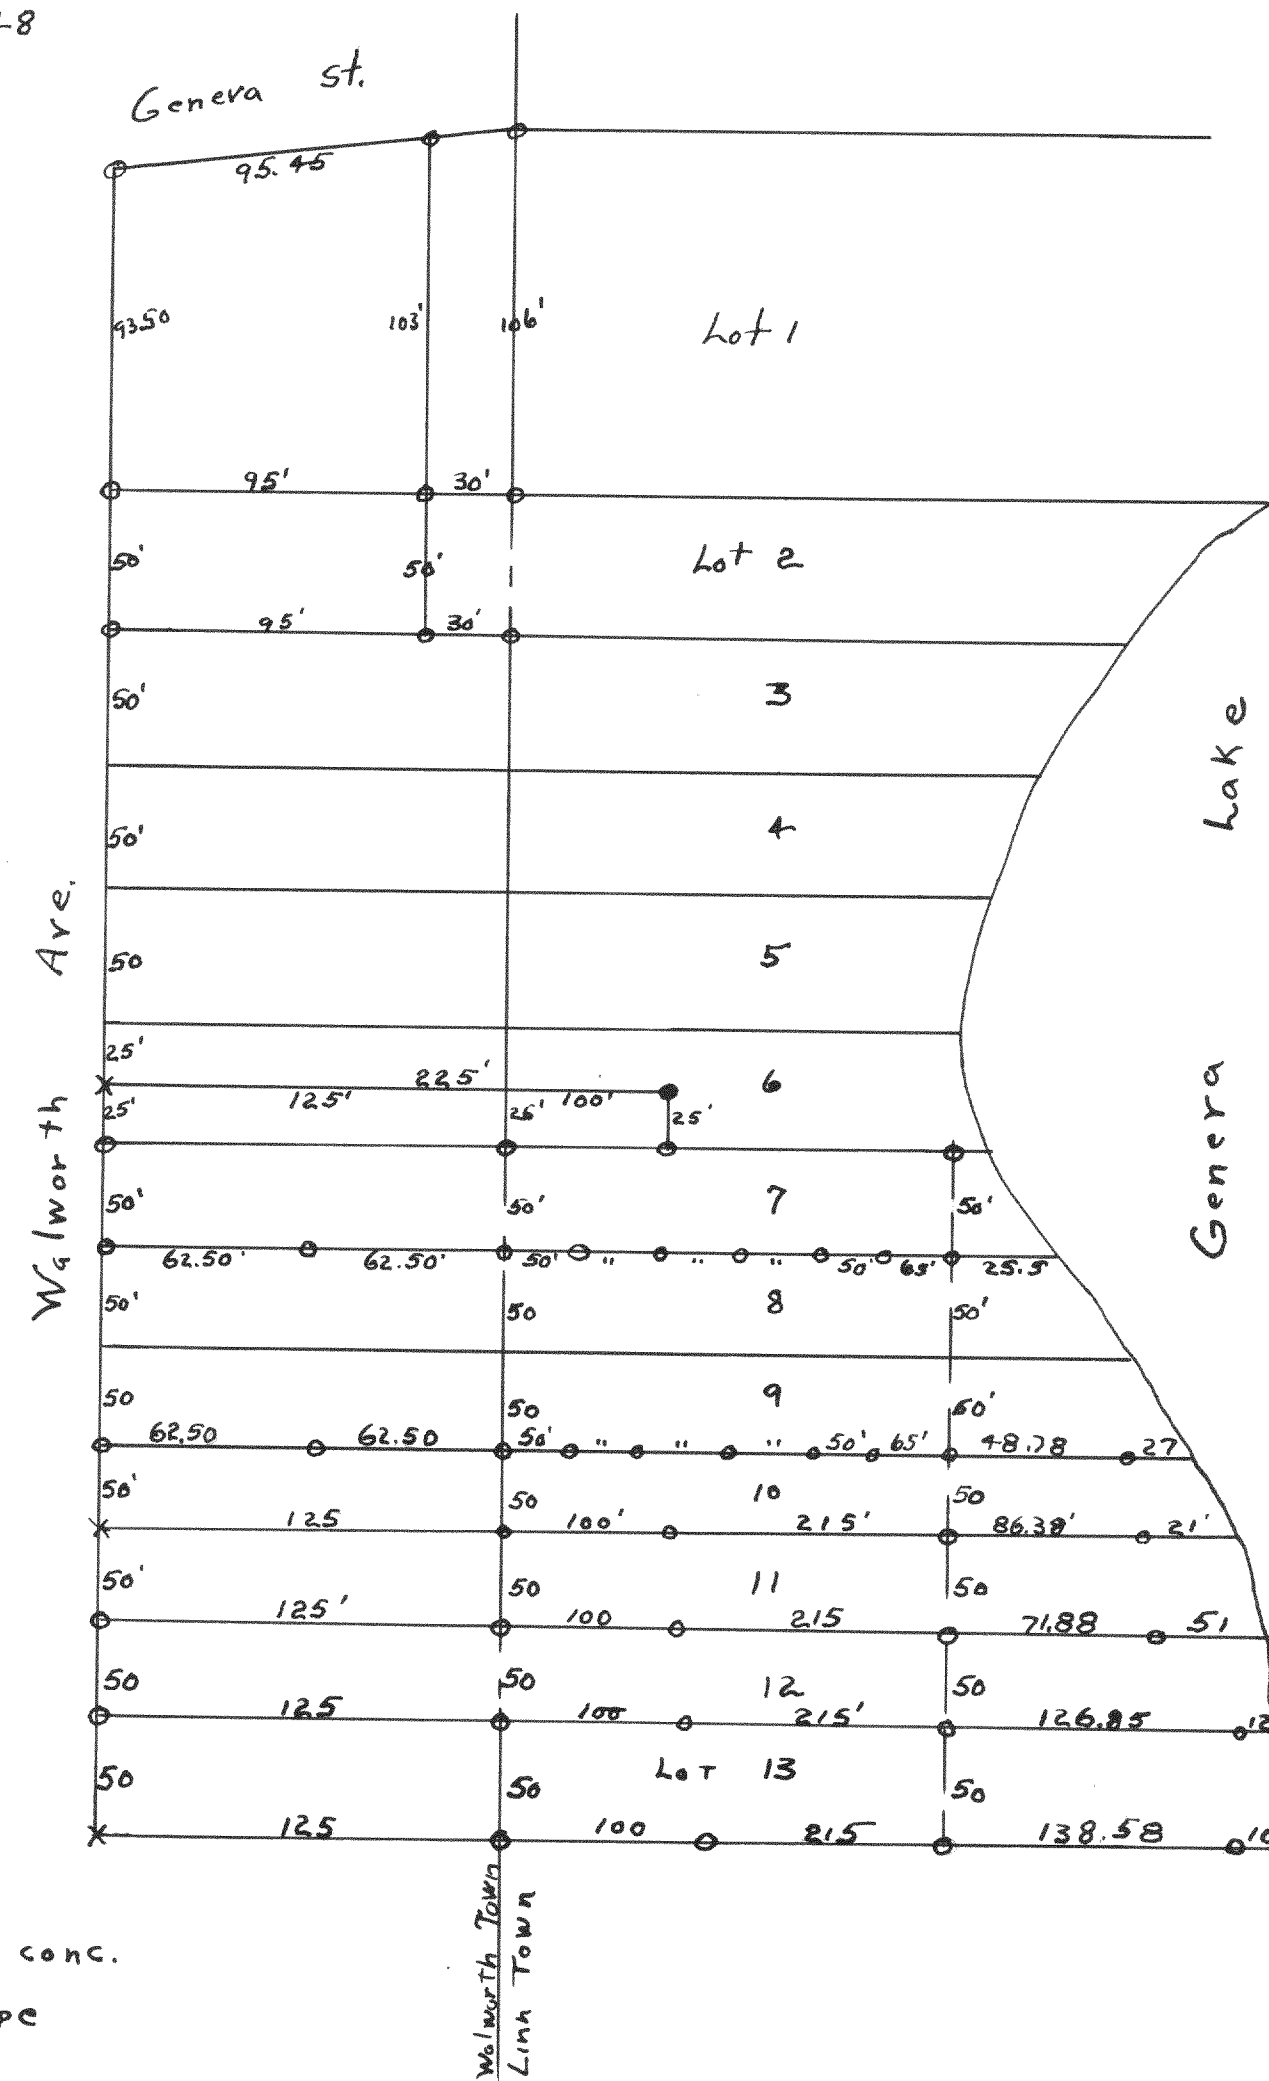

X - Cross in conc.
O - Iron pipe

Plat of survey for several owners in Block 7
of the original plat of the Village of Williams Bay
Walworth County Wisconsin

Dec. 10, 1946

Lloyd L. Jensen
County Surveyor
G.T.D