


#1649

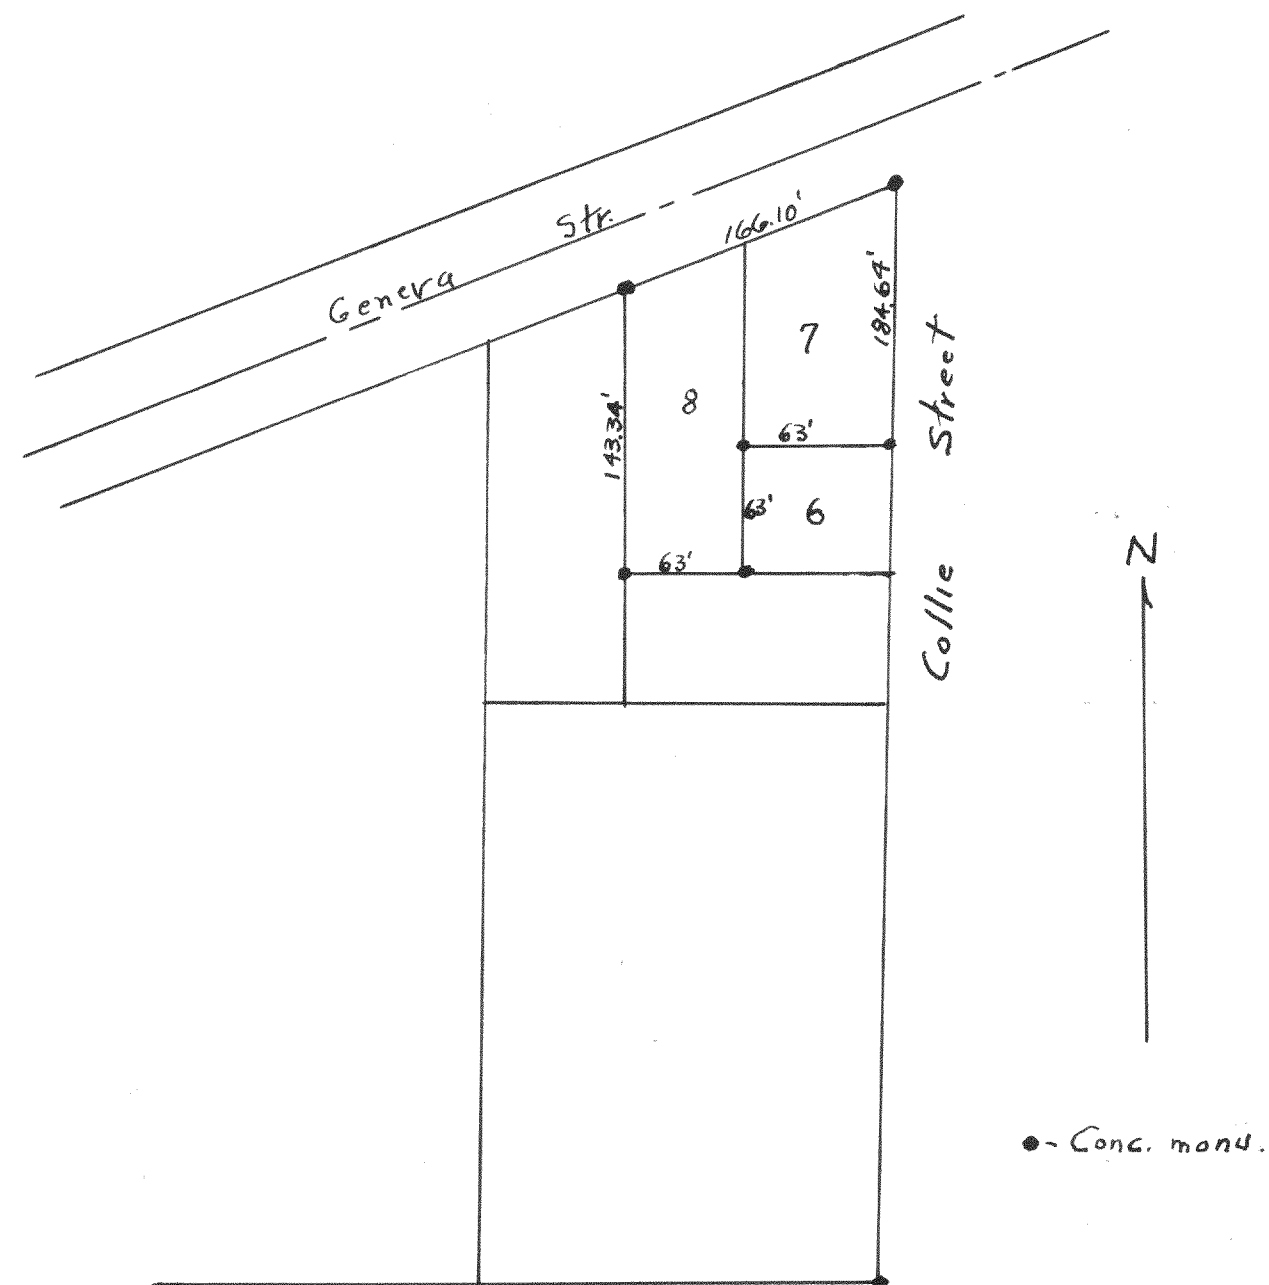


Plat of survey of lots 7 and 8 of Madison
Addition to the Village of Williams Bay, Walworth
County, Wisconsin

Dec 10, 1946

Lloyd I Jensen
County Surveyor
G.T.D

1650

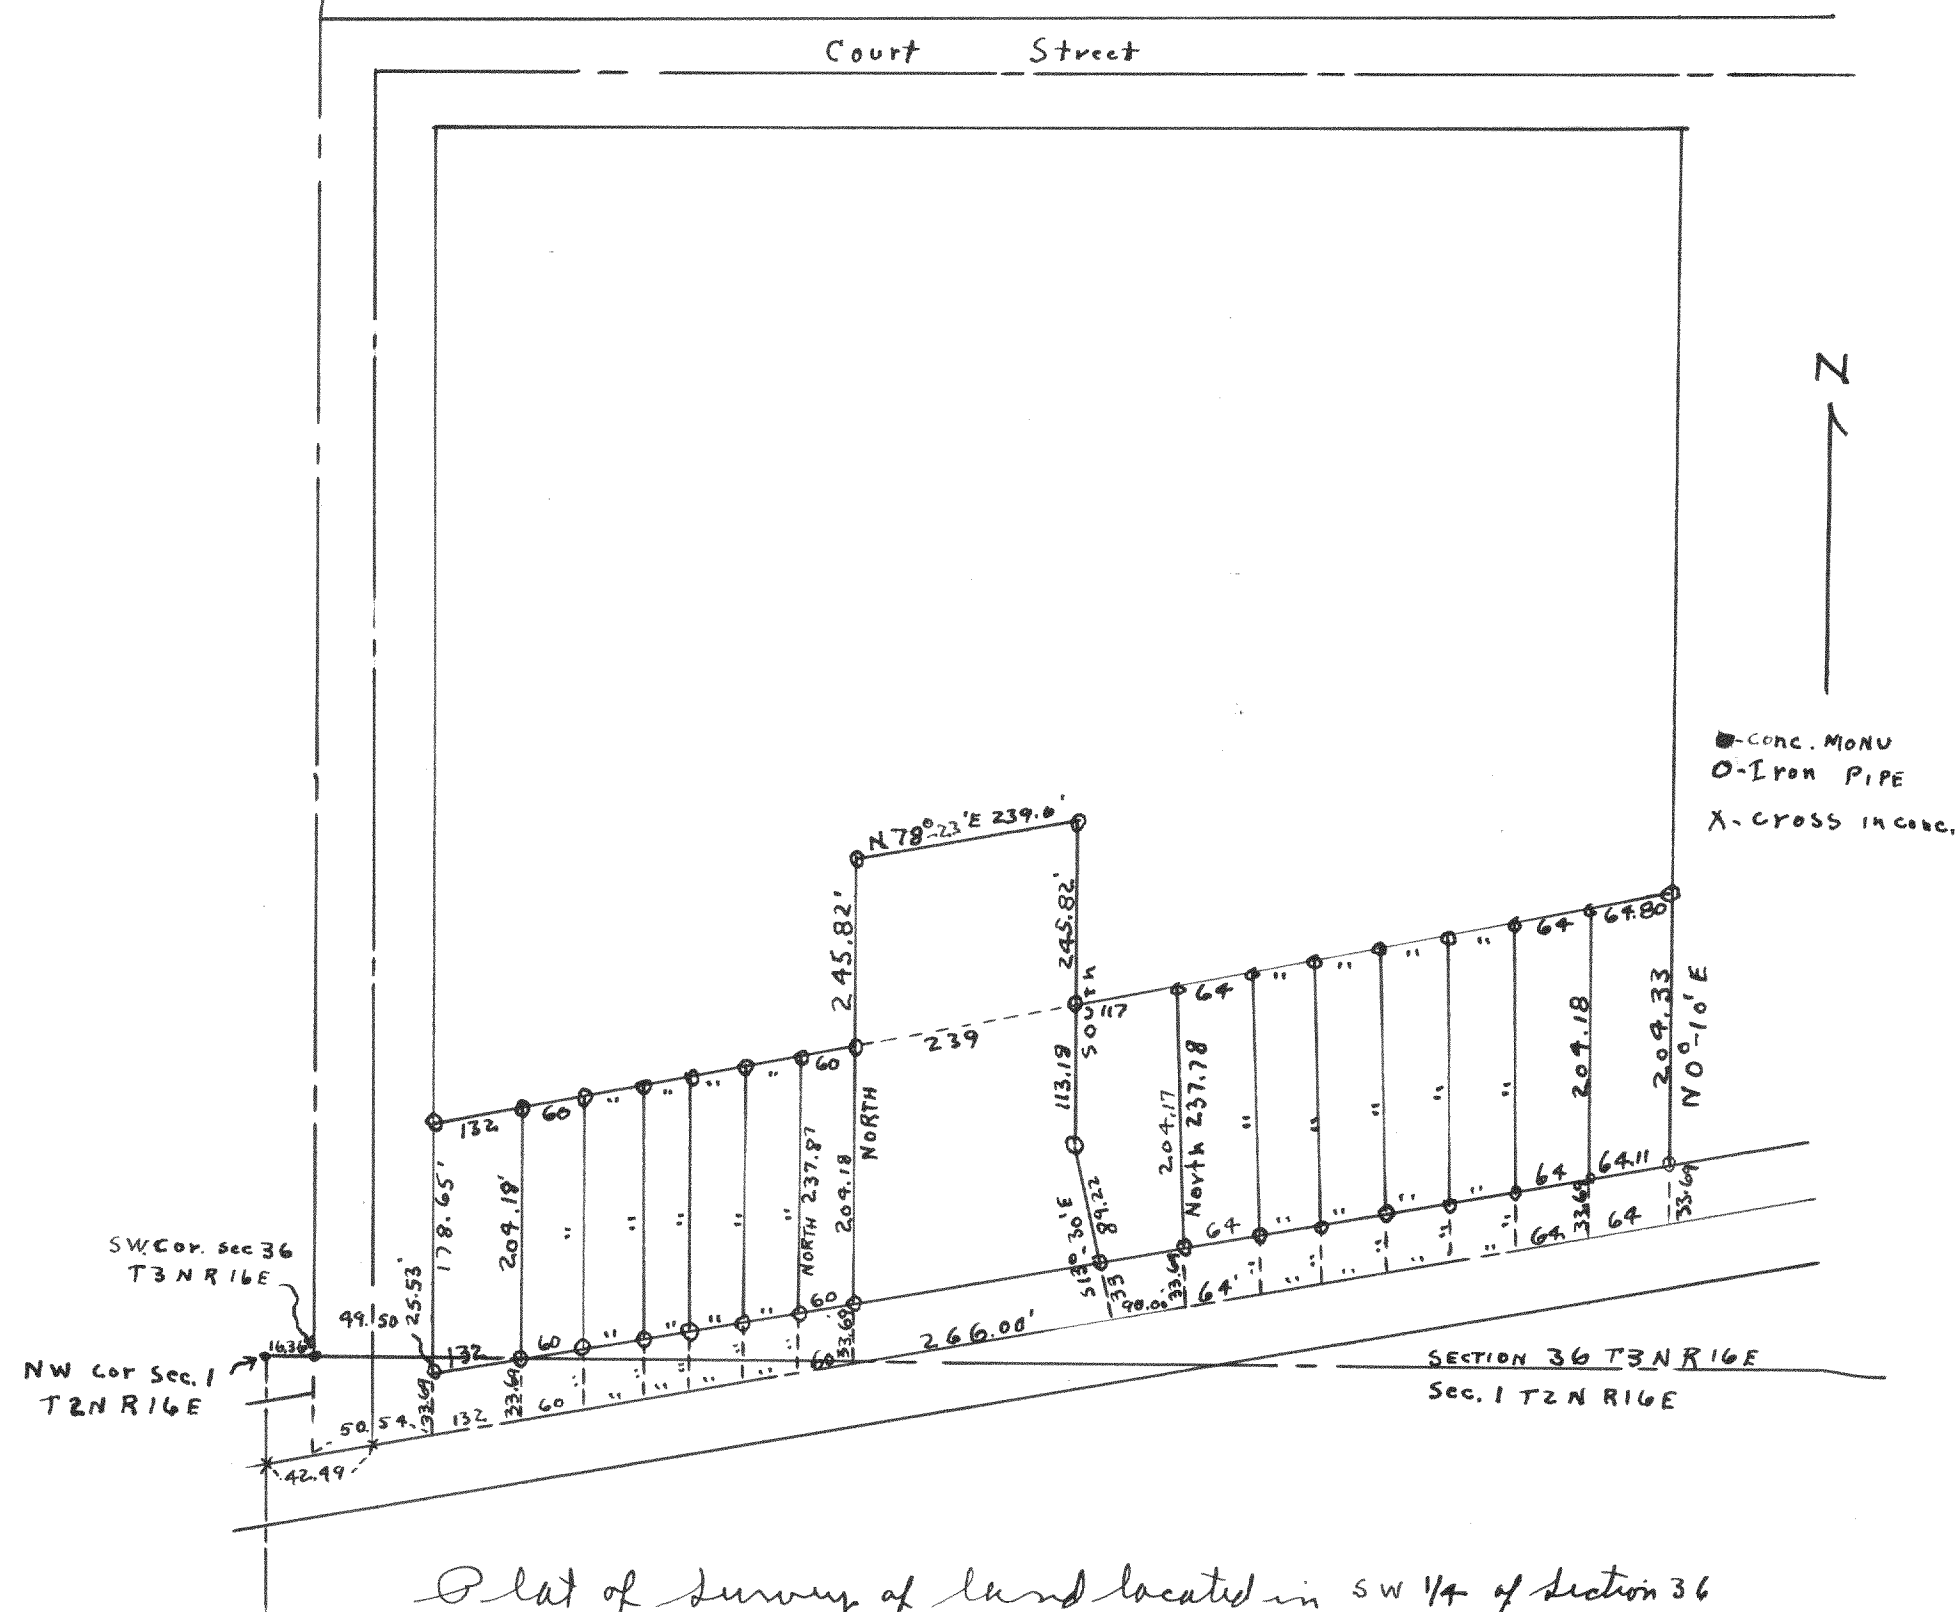

Plot of survey of land located in SW 1/4 of section 36
T 3 N R 16 E and in the NW 1/4 of section 1 T 2 N R 16 E in
the City of Elkhorn, Walworth County, Wisconsin
April 22, 1946 Lloyd L Jensen

April 22, 1946

Lloyd Jensen
County Surveyor
G.T.D.