



1657

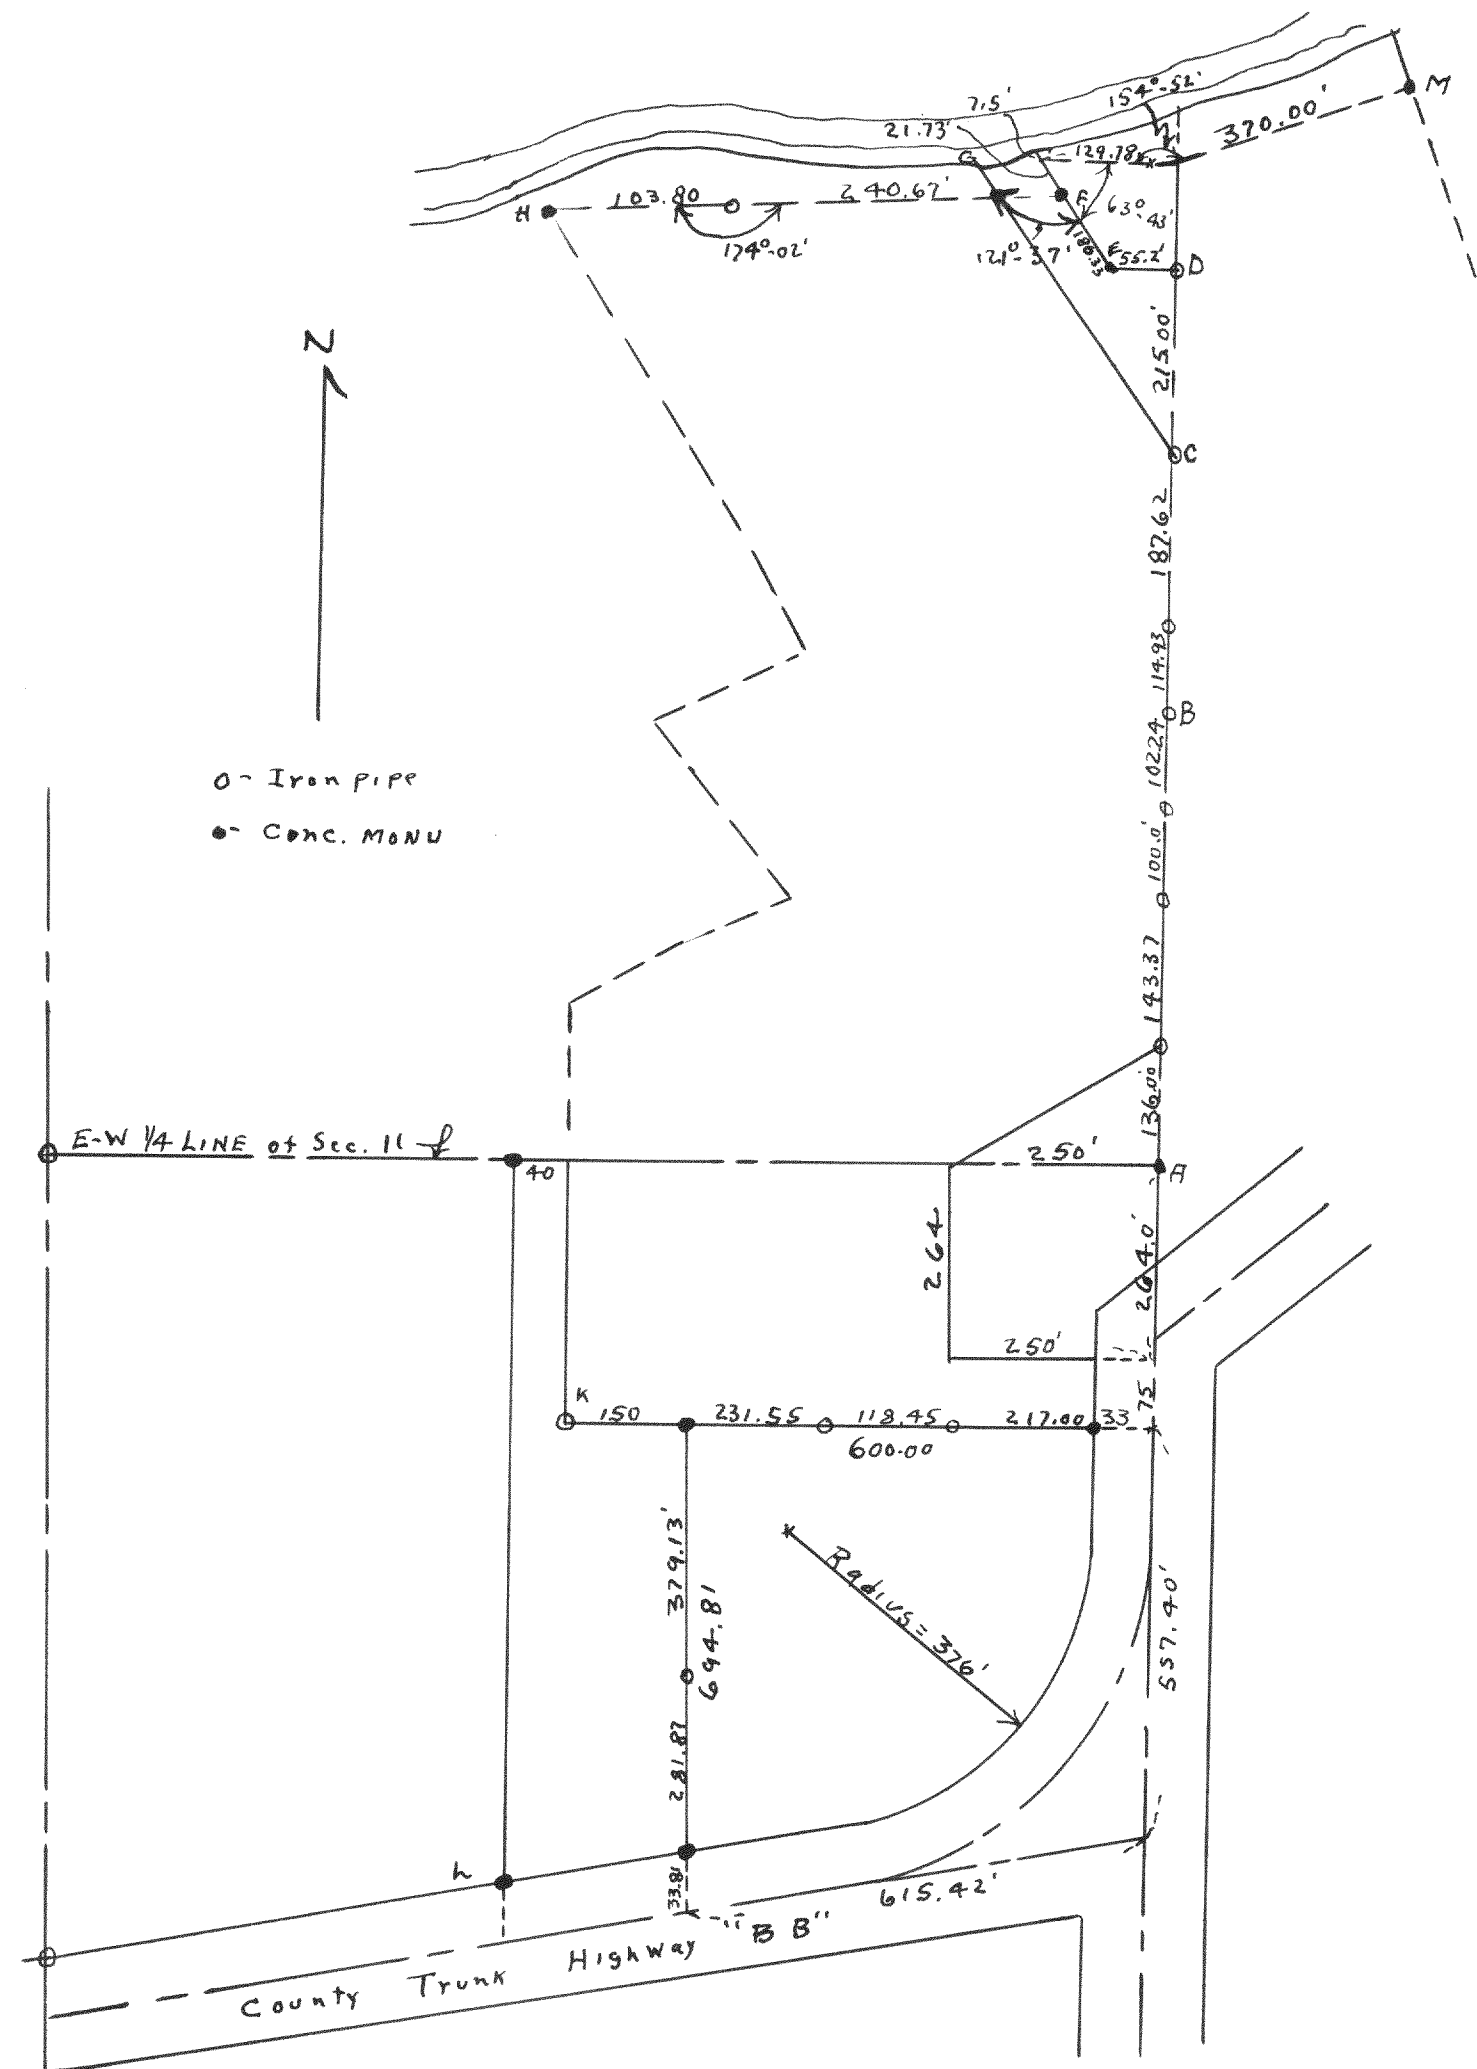

Plat of survey of land located in the SW 1/4
and the NE fractional 1/4 of section 11, T1N R1E of
Walworth County Wisconsin
Dec. 1946
Floyd L Jensen

Floyd L Jensen
County Surveyor
G.T.D

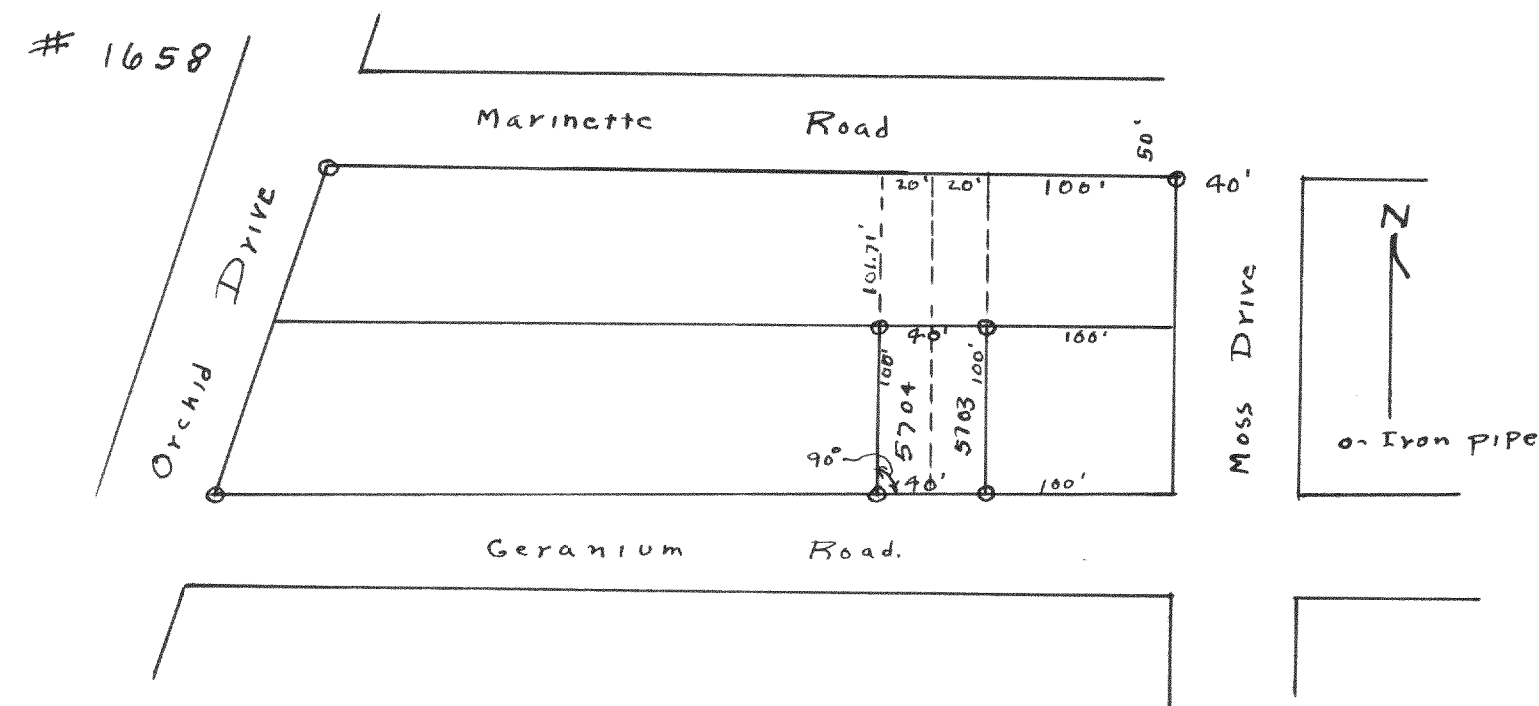


Plot of survey of lots 5703 and 5704 of Block 103
of Section 3 of Bell Lake subdivision T1N, R18E
Mahnorth county, Wisconsin

Aug 1946

Lloyd Jensen
County Surveyor
G.T.D.

1659

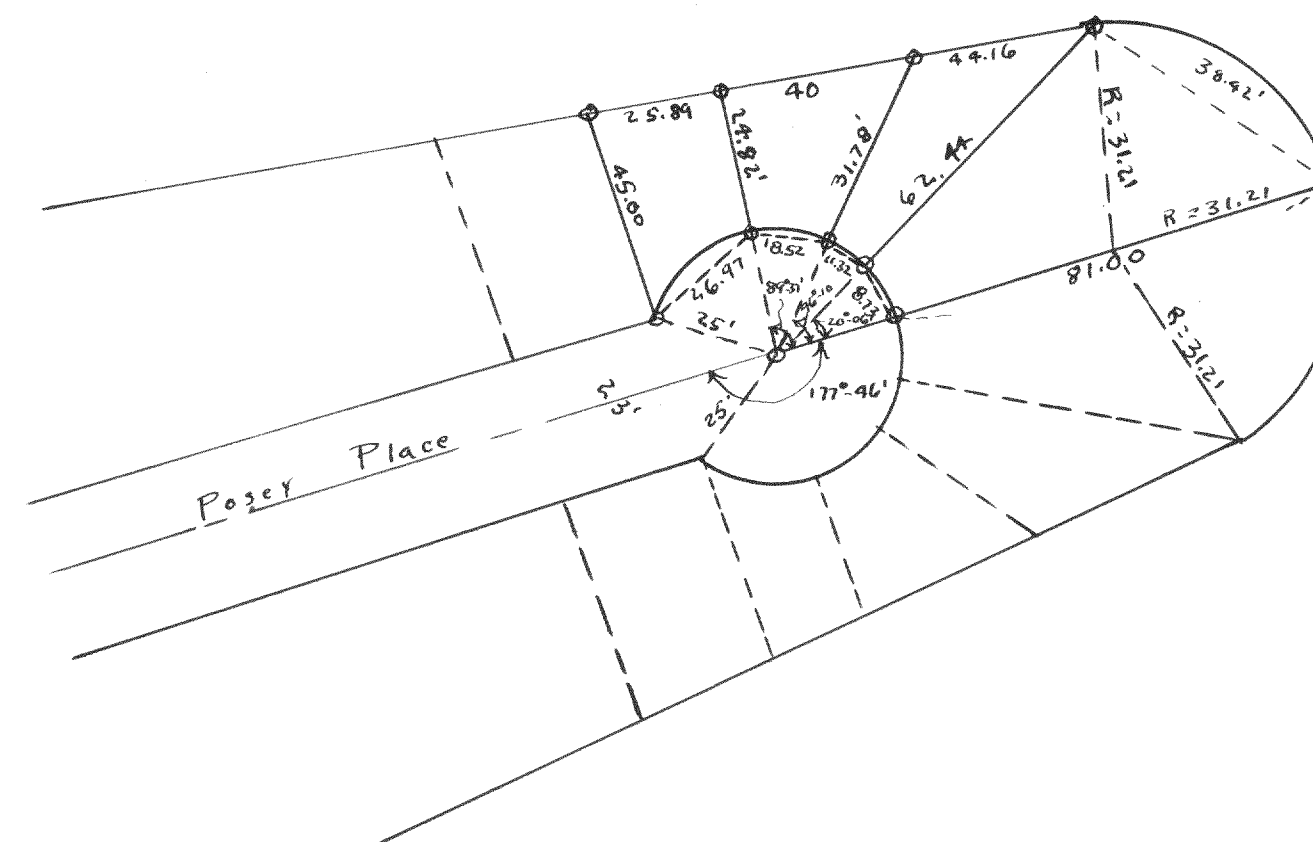

Plat of survey of Lots 9405 to 9408 of Sec. 6 of
Dell Lake, Marathon County Wisconsin

June 16, 1946

Lloyd I. Jensen
County Surveyor
O.T.D.