


#1663

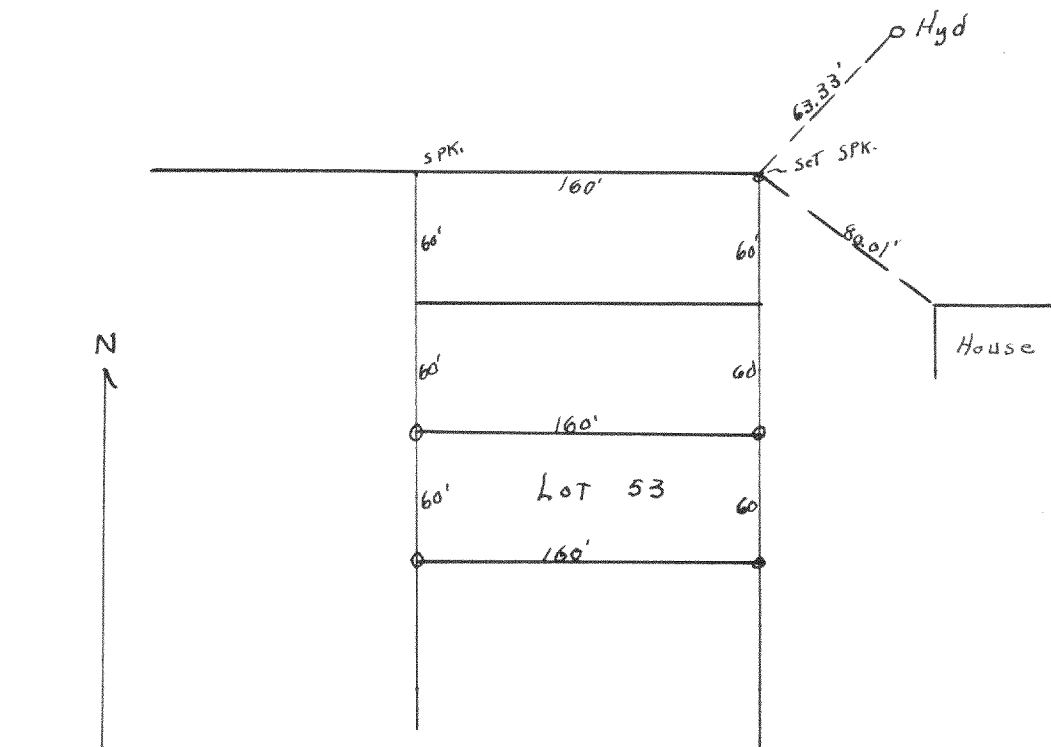


0-Iron Pipe

Plot of survey of lot 53 of Bay View
Subdivisions located in the Village of Milham

Bay, Walworth County, Wisconsin
March 1946

Lloyd L. Jensen
County Surveyor
G.T.D.

#1664

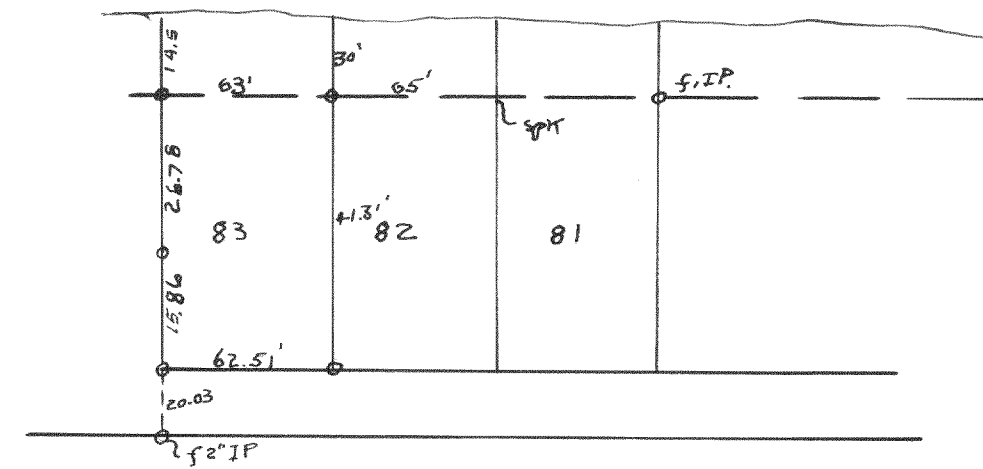


0-Iron Pipe

Plot of survey of lot 83 of the
Consumers Co. Subdivision located in
Sections 32 and 33, T2N R17E of Walworth County, Wisconsin

June 1946

Lloyd L. Jensen
County Surveyor
G.T.D.

#1665

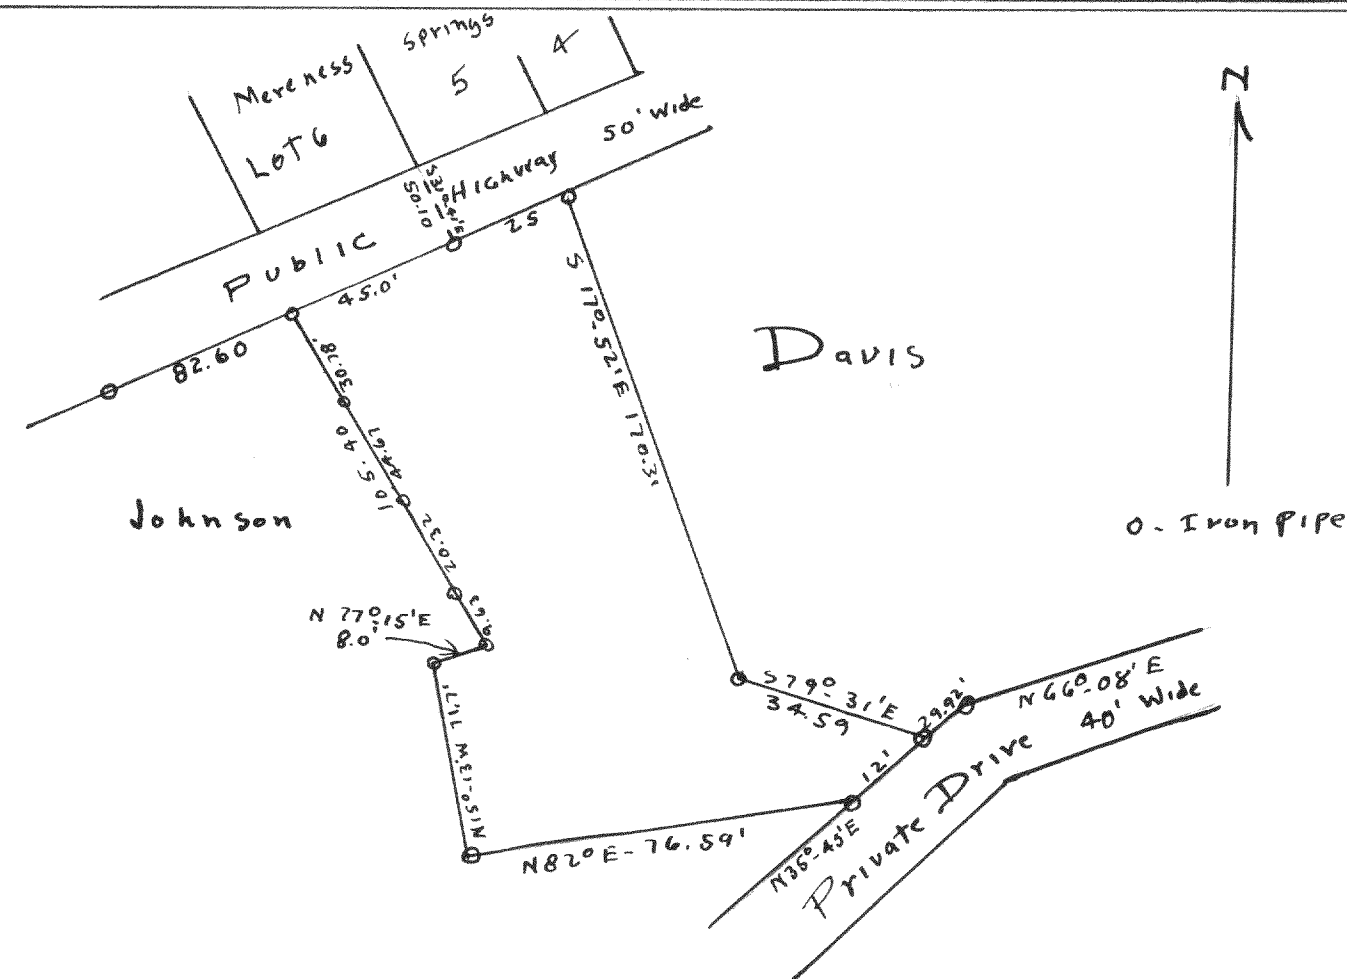


0-Iron Pipe

Plot of survey of a parcel of land located in the SE
fractional 1/4 of Section 22, T2N R17E of Walworth County,
Wisconsin

Sept 1945

Lloyd L. Jensen
Walworth County Surveyor
G.T.D.

#1666

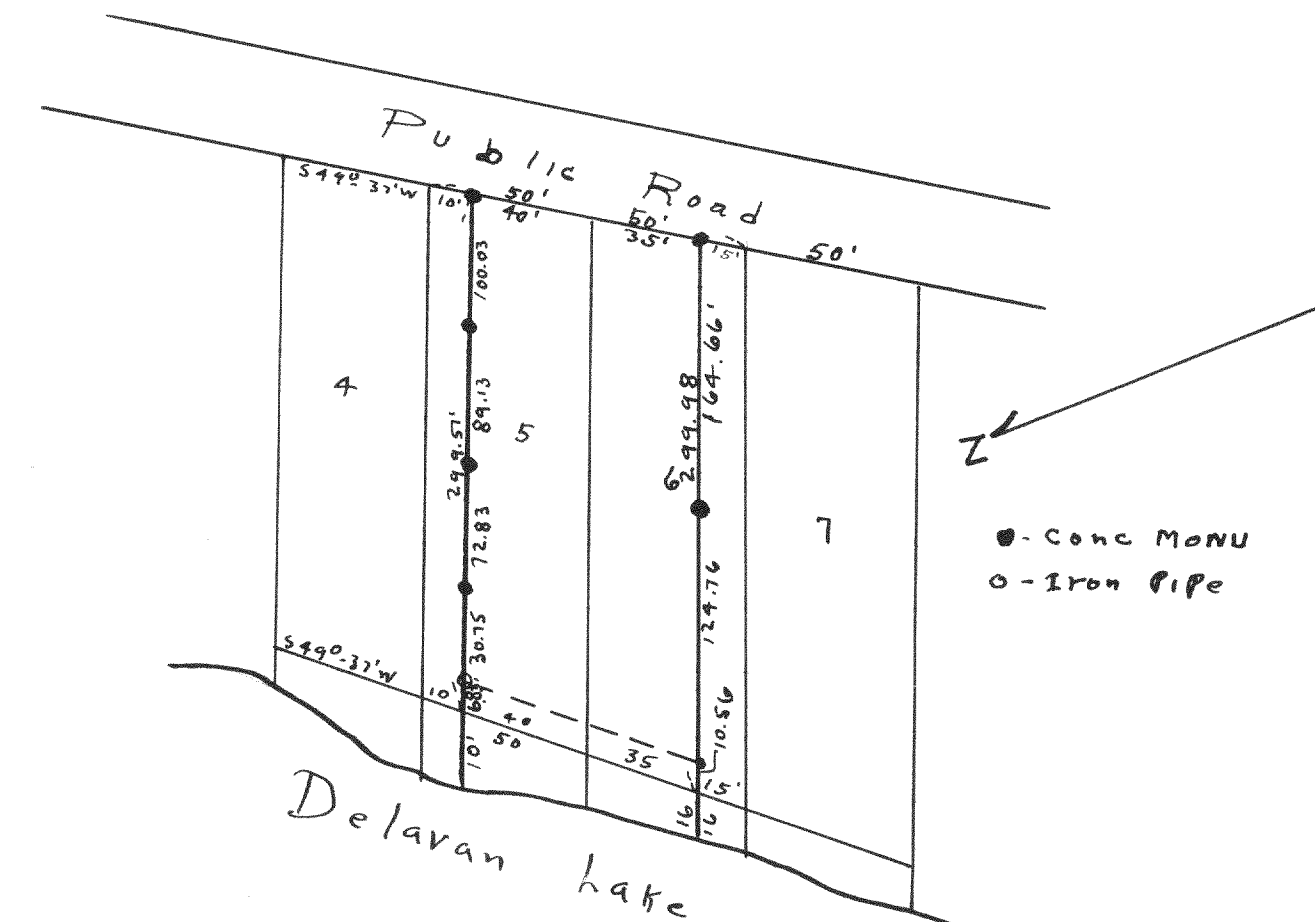

0-Conc Monu
0-Iron Pipe

Plot of survey of part of Lots 5 and 6 of Bailey Subdivision
located in the West fractional 1/2 of Section 22, T2N R17E
of Walworth County, Wisconsin

Sept. 1946

Lloyd L. Jensen
County Surveyor
G.T.D.