



#1667

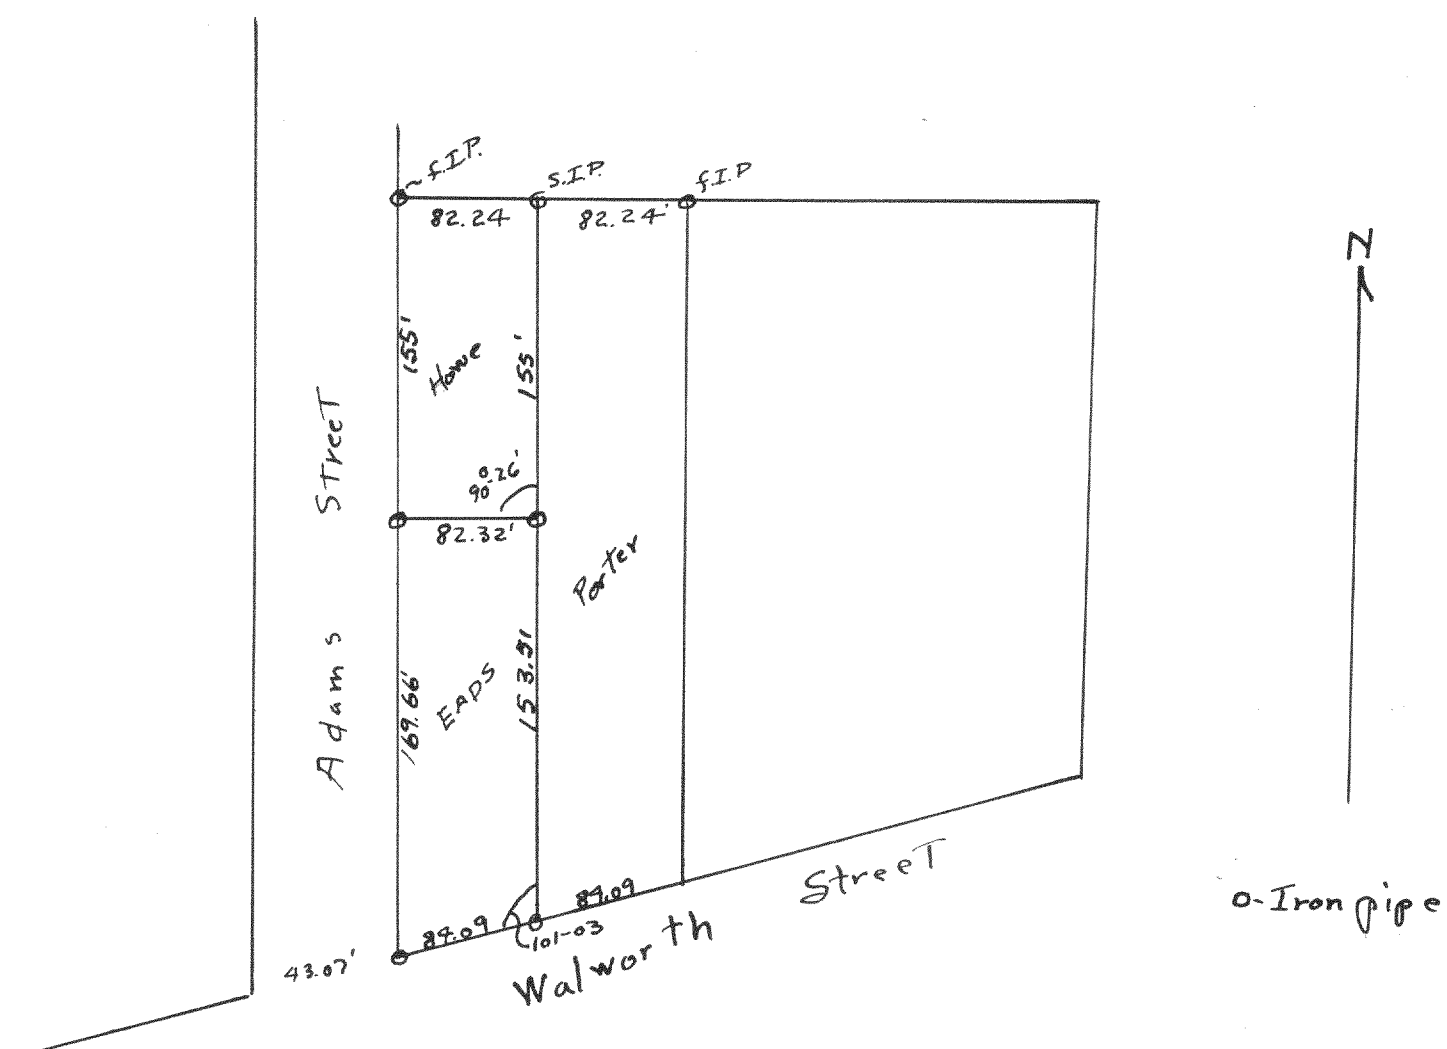

Plot of a survey of land located at the
corners of Adams and Walworth streets
in the city of Elkhorn, Walworth County, Wisconsin
April 6, 1946
Lloyd I. Jensen

Lloyd L. Jensen
County Surveyor
G.T.D

1668

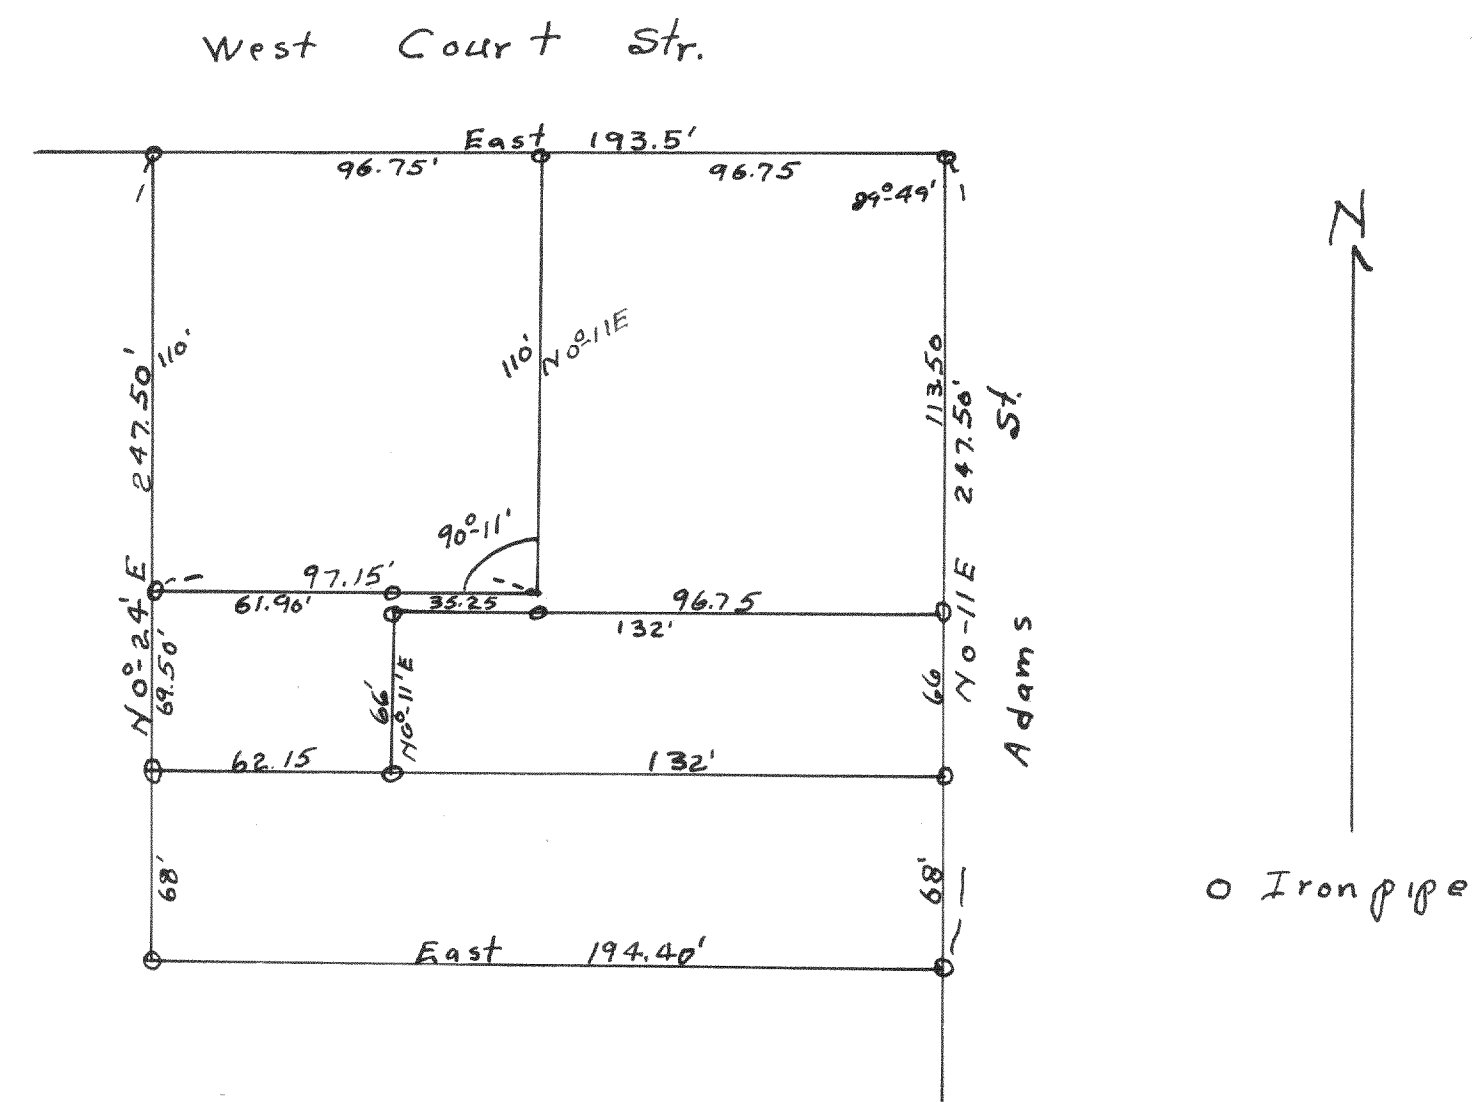

Plot of survey of land located at the corner of West Court
and Adams streets in the city of Elkhorn, Malwaukee County, Wisconsin
May 3, 1946 Lloyd L. Jensen

Lloyd L. Jensen
County Surveyor