


#1668 $\frac{1}{2}$

Plot of Demes Subdivision in the City
of Elkhorn, Section 36, T37N R16E, Wal.
County Wis., see recorded plat on file
in the Register of Deeds office at the
County Court House.

May 1946

Lloyd L. Jensen
County Surveyor


#1669

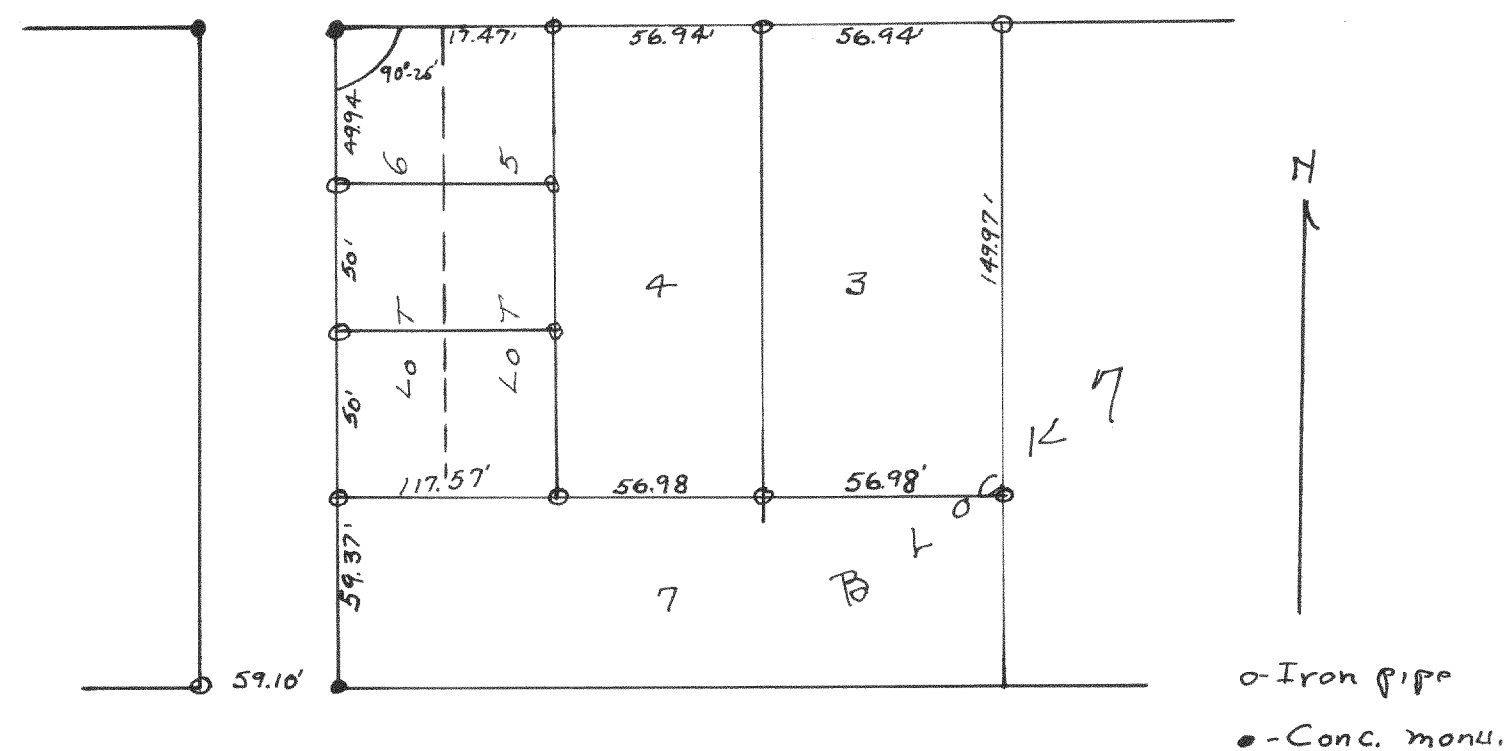

Plot of survey of lots 3, 4, 5, and 6 of Block 7 of
Fairview Heights in the City of Delavan, Walworth County, Wis.
June 1946

Lloyd L. Jensen
County Surveyor
G.T.T.

#1670

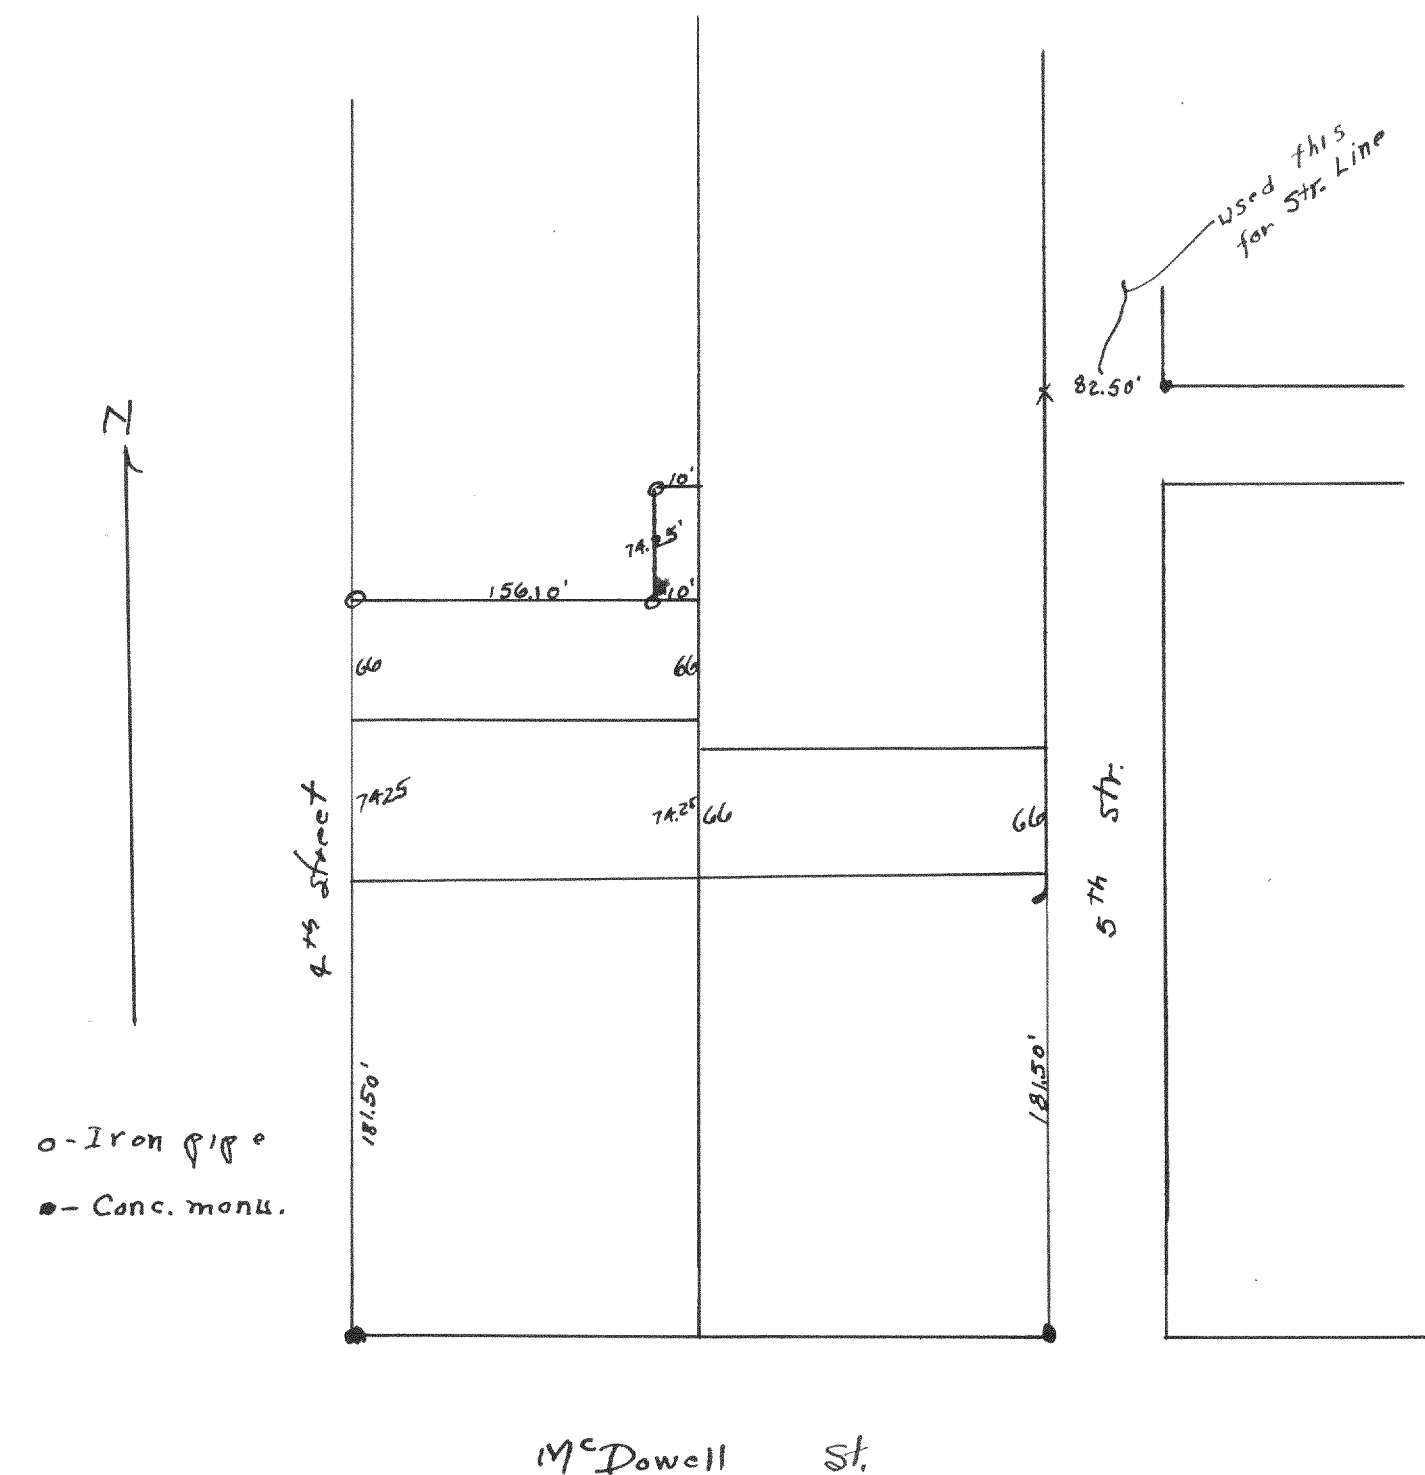

Plot of survey of land located between 4th and 5th
streets in the City of Delavan, Walworth County Wisconsin,
December 1946

Lloyd L. Jensen
County Surveyor
G.T.T.