


1673

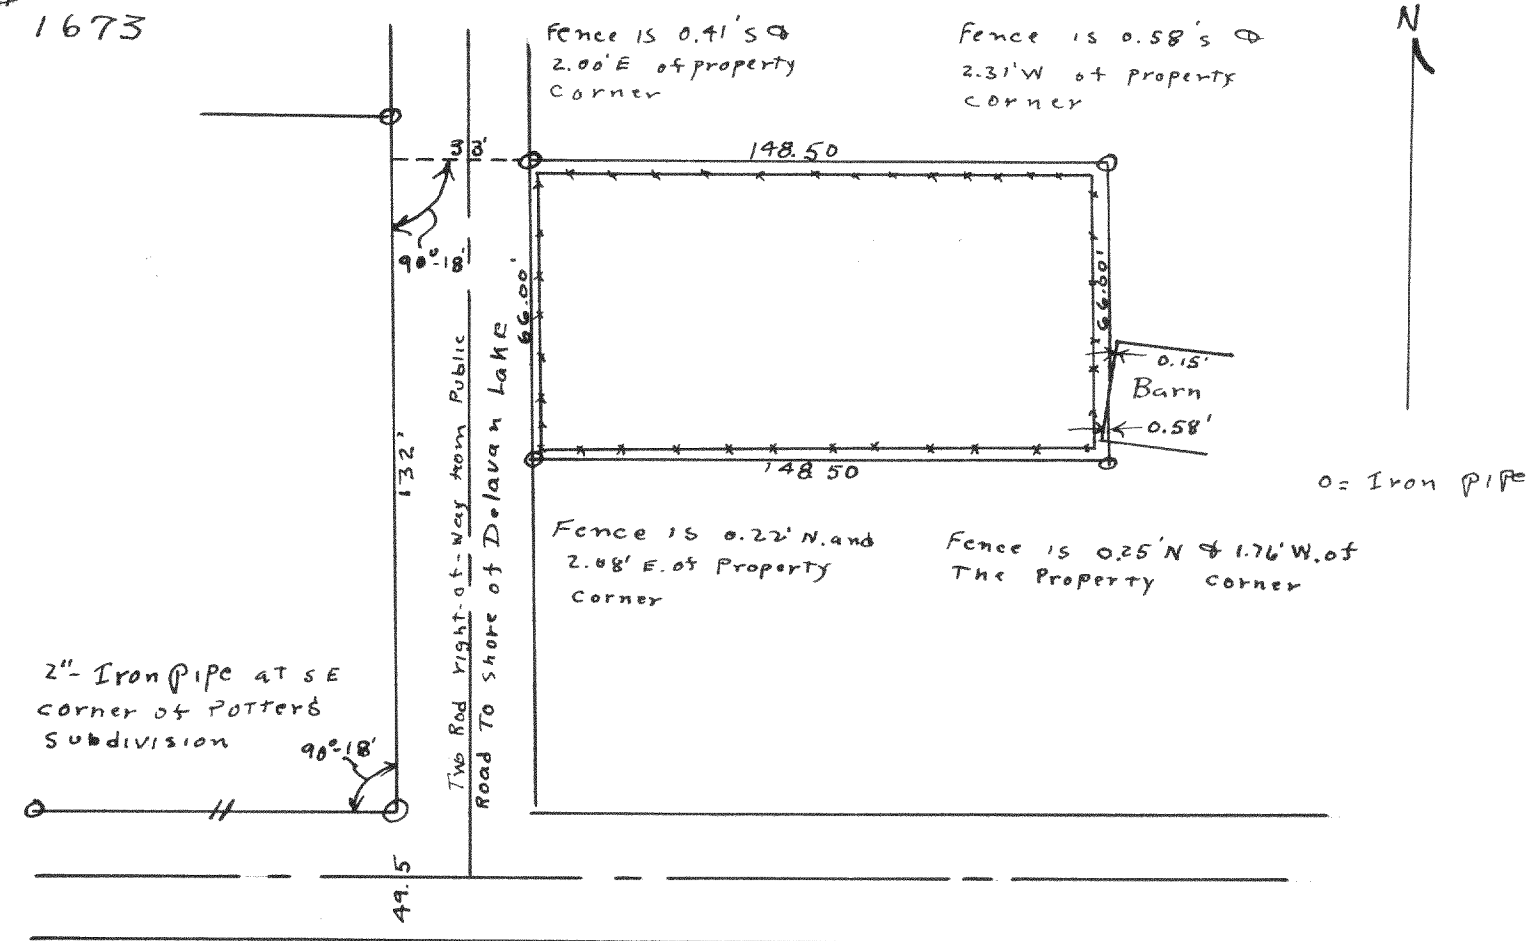

Plot of survey of a parcel of land located in Section 32
T 2 N R 14 E in Walworth County Wisconsin
Sept 1946
Lloyd L. Jensen
Walworth County Surveyor
G.T.D.

1674

