



#1677

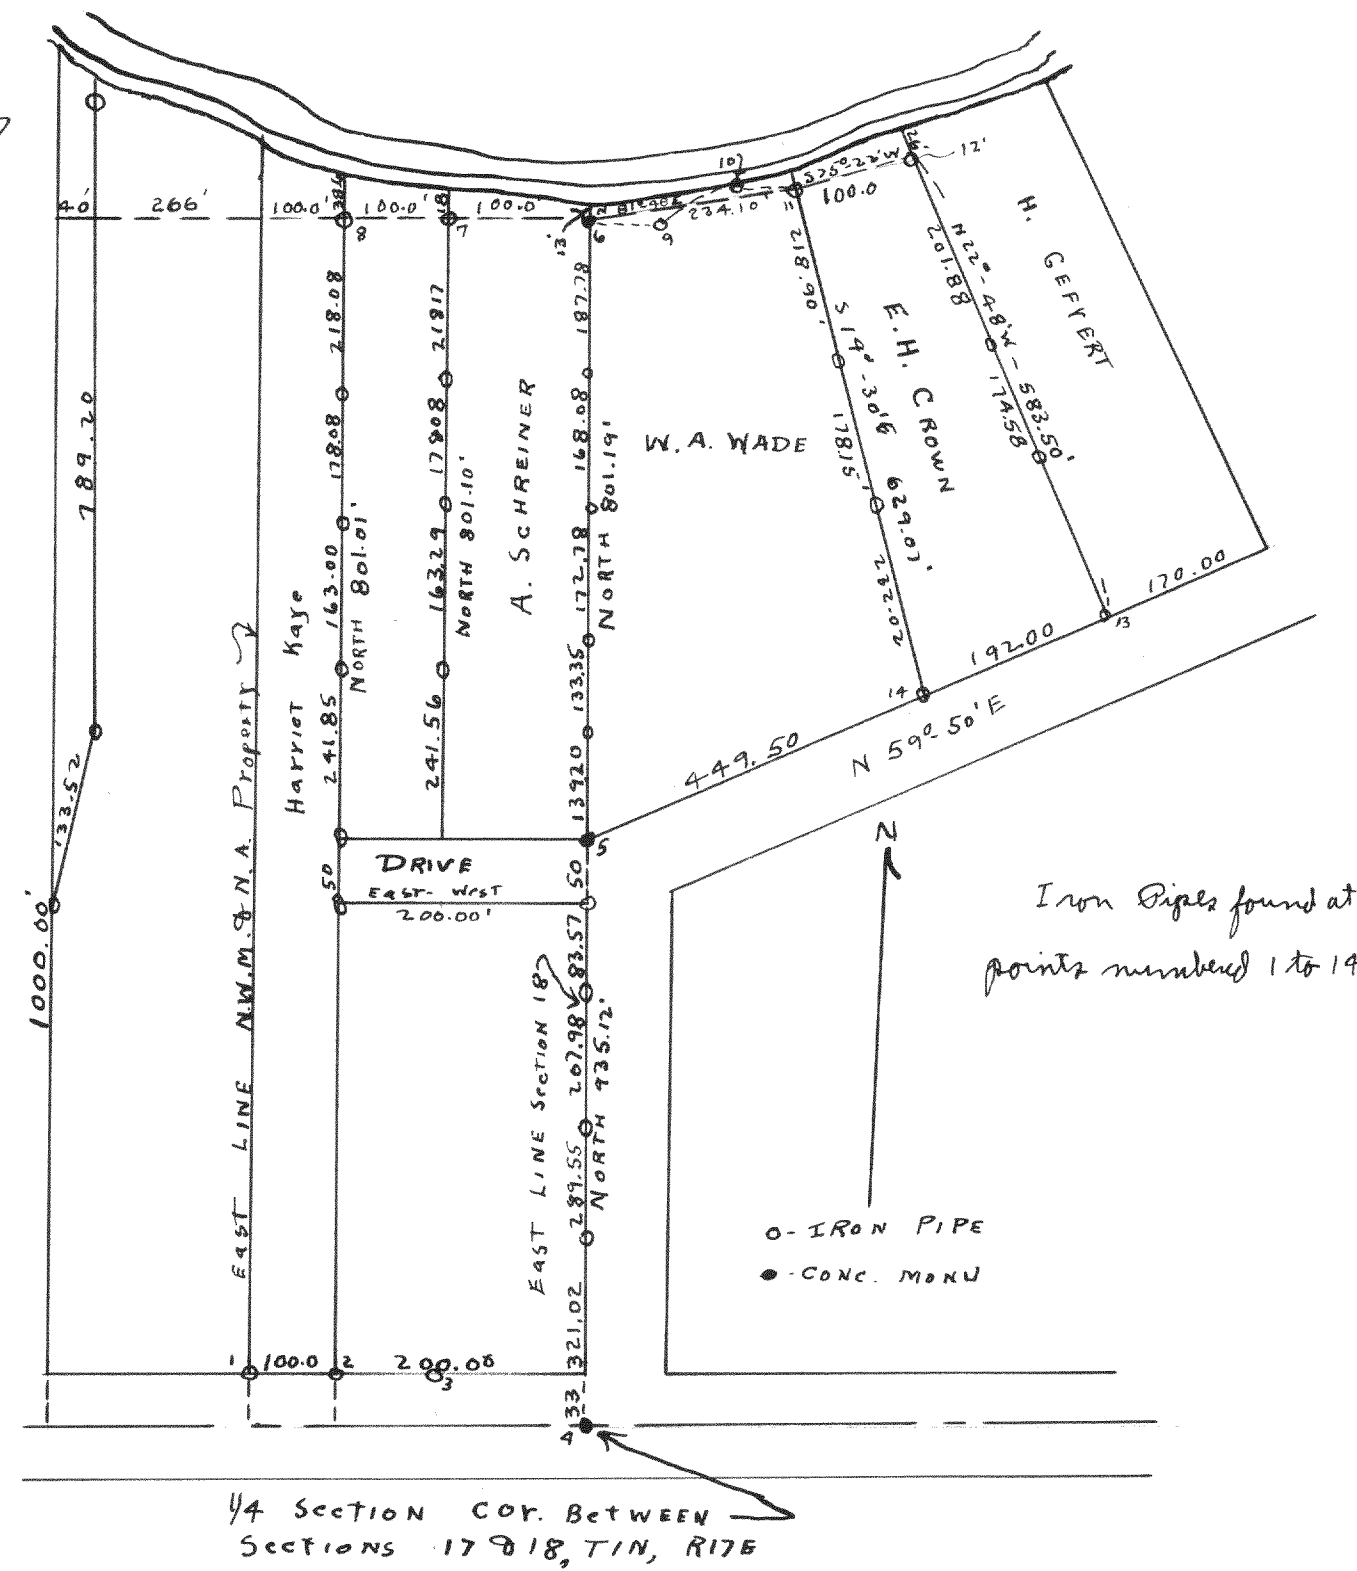

Plat of survey of lands located in the NW fractional 1/4 of section 17 and NE fractional 1/4 of section 18, T1N, R17E Walworth County Wisconsin
Nov. 18, 1946

Lloyd I. Jensen
County Surveyor
G.T.D

#1678

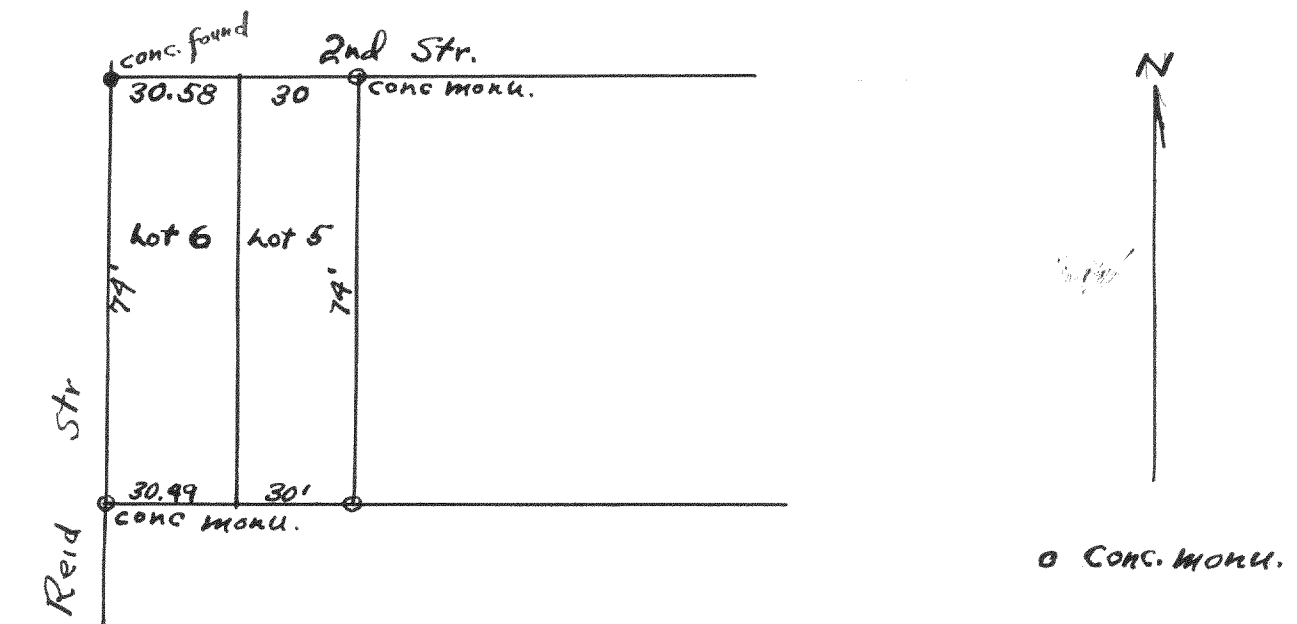

PLAT OF SURVEY OF LOTS 5 & 6 of block 5 of D.G. REIDS
ADD. TO THE VILLAGE OF FOUNTANA
MARCH 1946

Lloyd I. Jensen
Co. Sur.

#1679

Plat of survey of Mc Kenna Addition to the City of Lake Geneva and the Town of Geneva - see recorded plat in the Register of Deeds office at the County Court House.

Mar. 1947

Lloyd I. Jensen
County Surveyor