


#1687

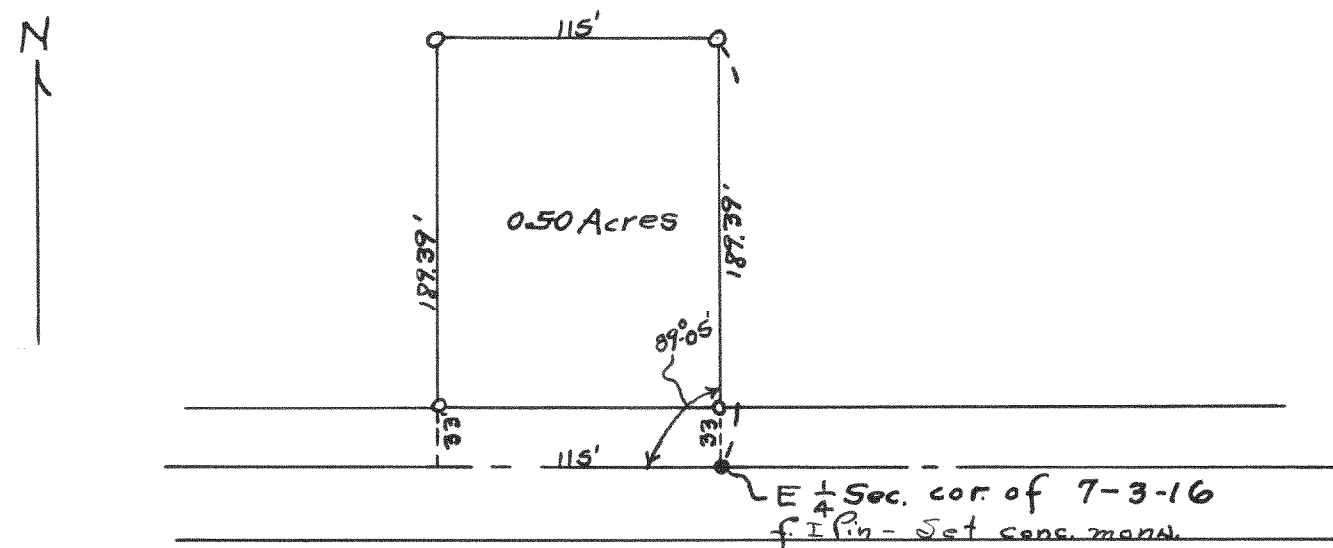


Plot of a survey of a parcel of land located in the Northeast $\frac{1}{4}$ of Section 7, T37N R16E of Walworth County Wisconsin. Used Subd. stakes for N-S line for E. ln. of Section and the centerline of the road as fenced $\frac{1}{2}$ mile West for East-west line.

May 6, 1946

Lloyd L. Jensen
County Surveyor

#1688

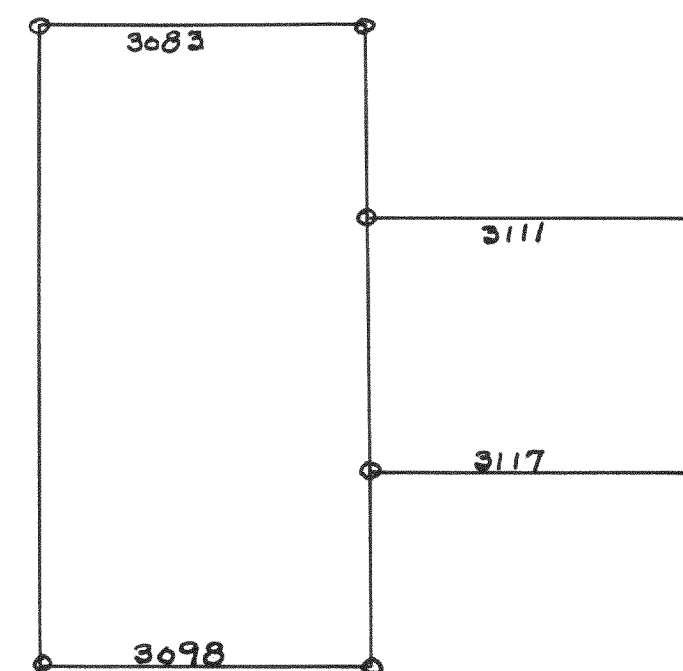

Survey of lots at Lake Como Beach Subdivision in T37N R17E of Walworth County Wisconsin.

May 11, 1946

Lloyd L. Jensen
County Surveyor