



#1697

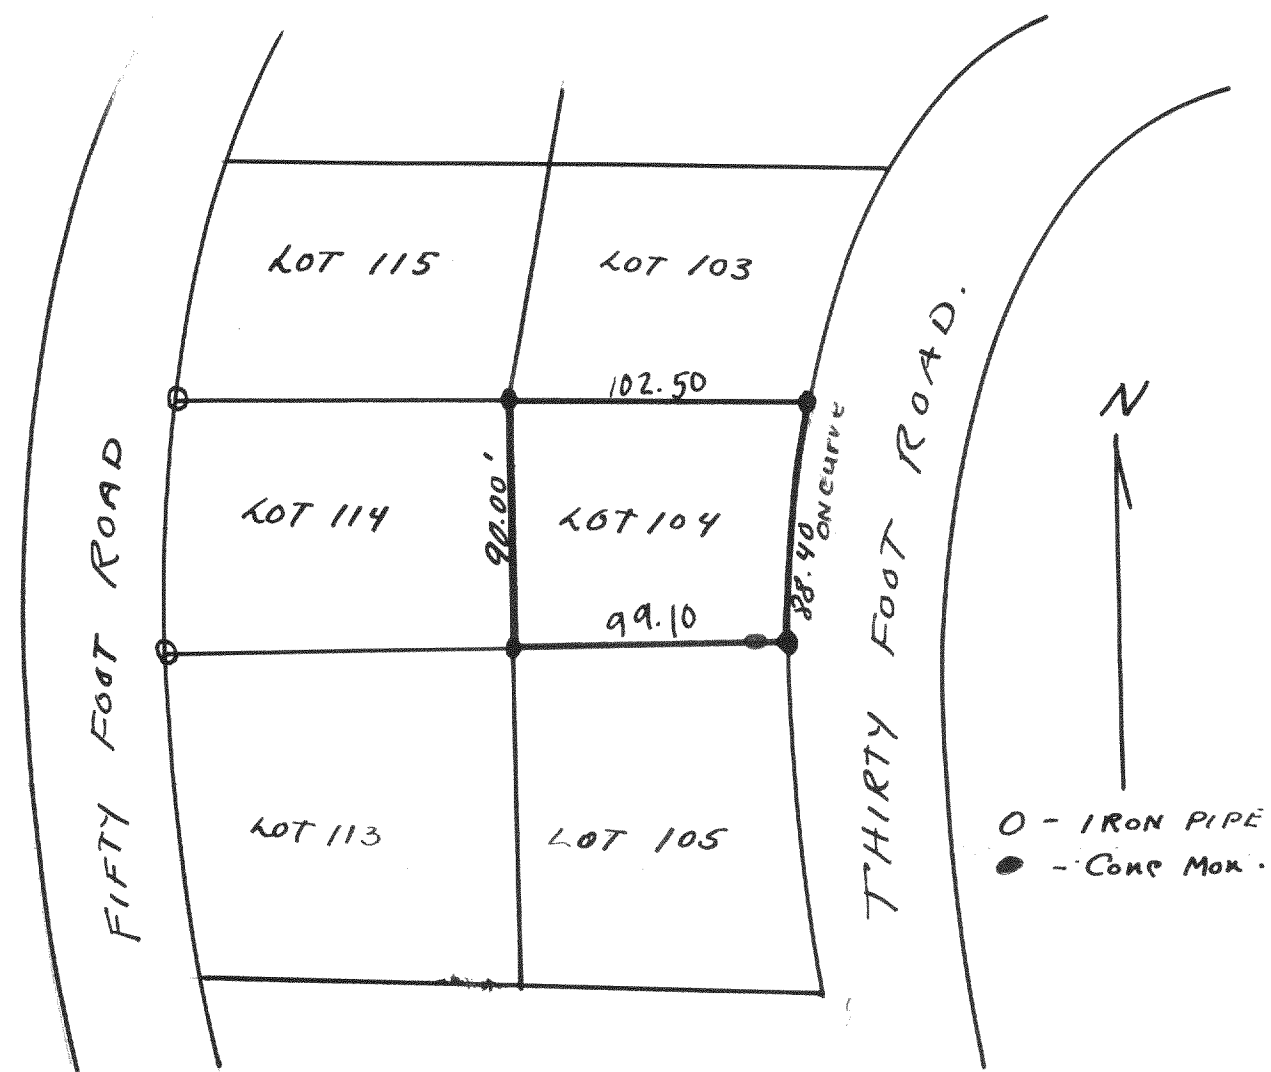

Plat of survey of lot 104 of Unit 2 of
Country Club Estates, A subdivision located in
Sections 14 + 23 T1N, R16E of Wal. Co. Wis.
Sept 1946 Lloyd L. Jensen
Co. Sur.

#1698.

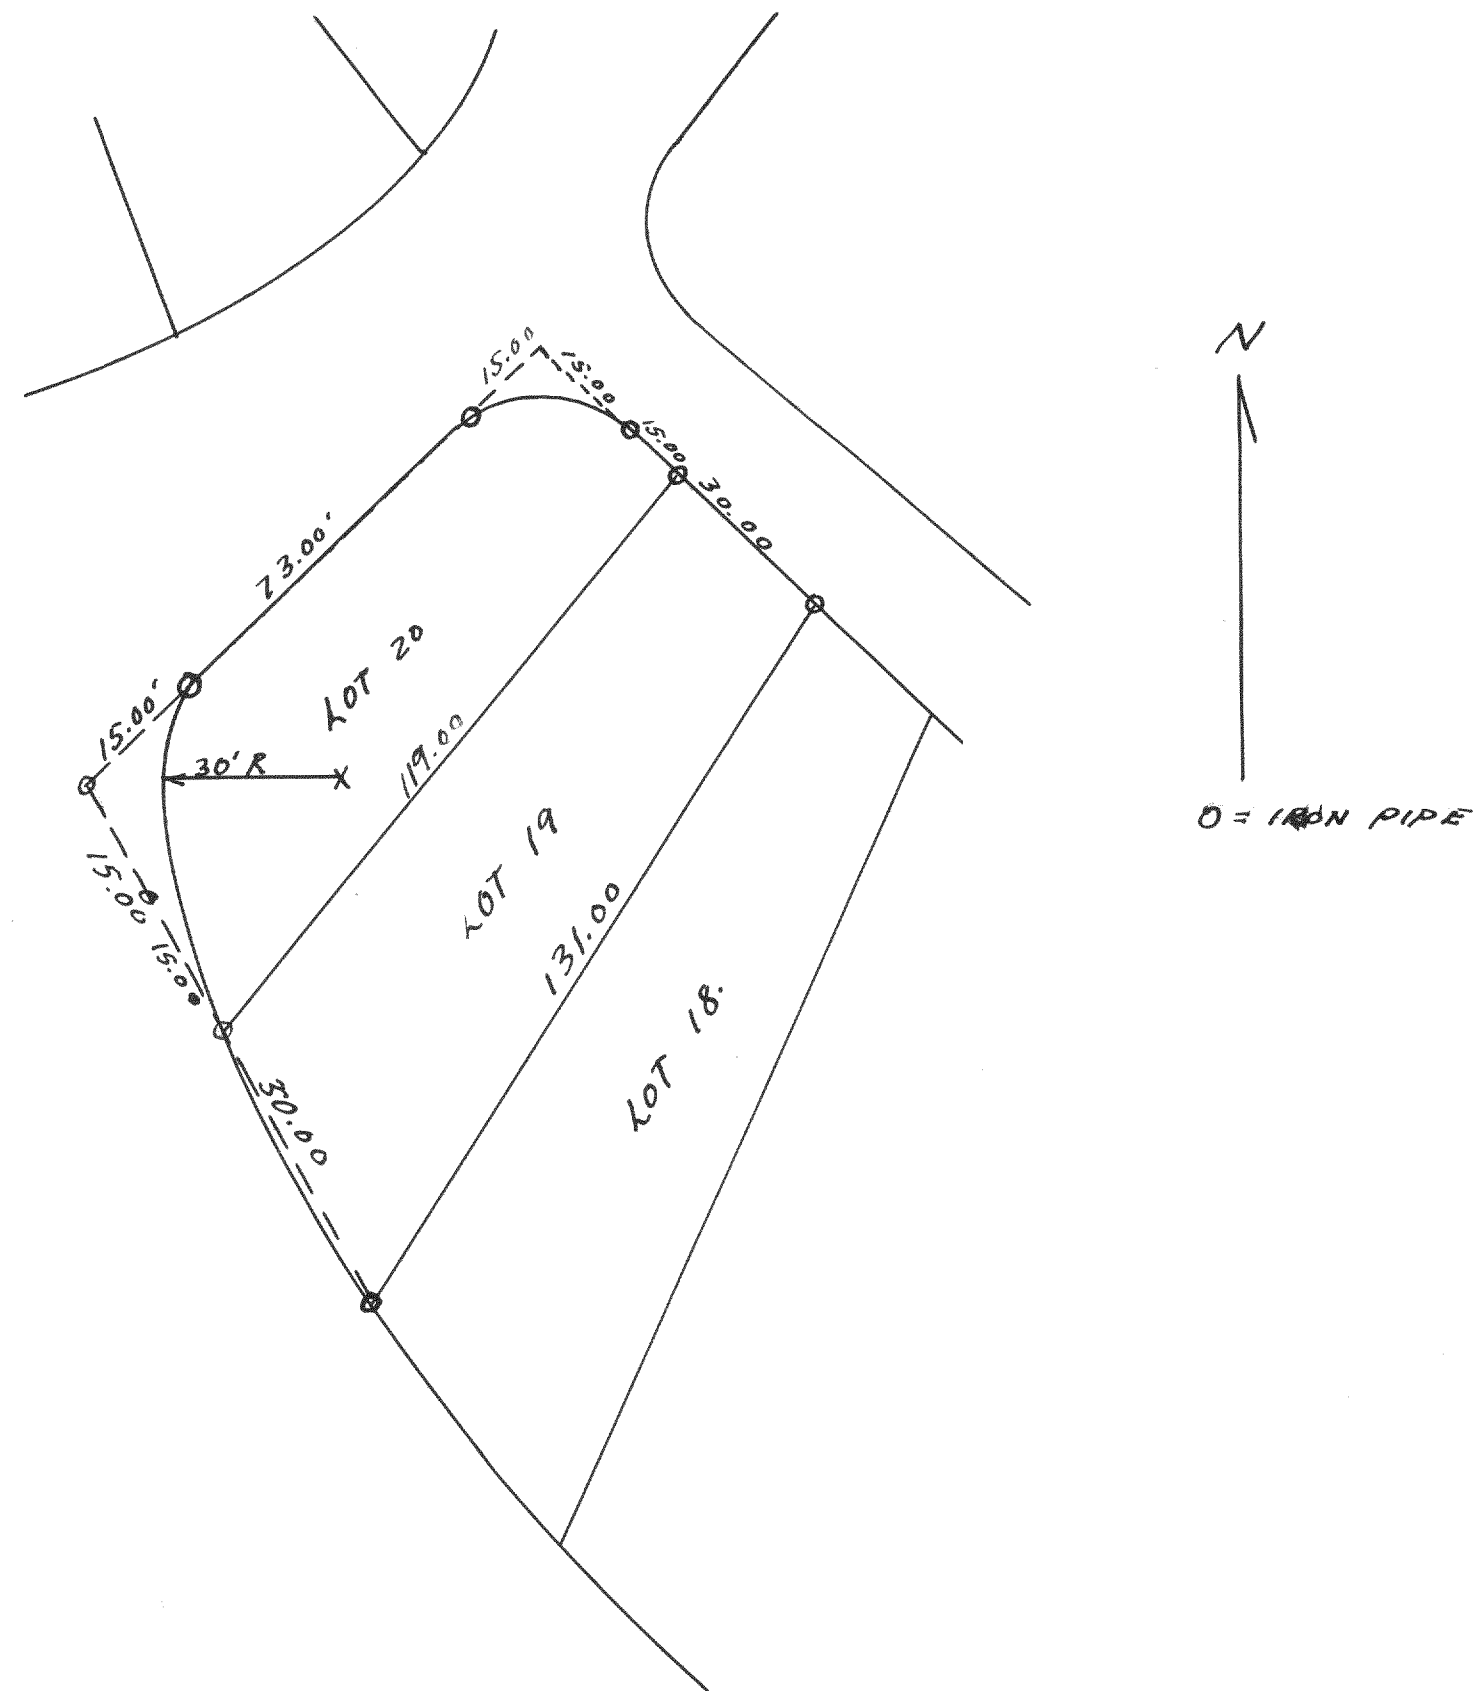

Plat of survey of lots 19 + 20 of Buena Vista Subd.
located in the Village of Fontana - ON - Geneva Lake
Wal. Co., Wis.

Sept 1946 Lloyd L. Jensen
Co. Sur.