



#1699

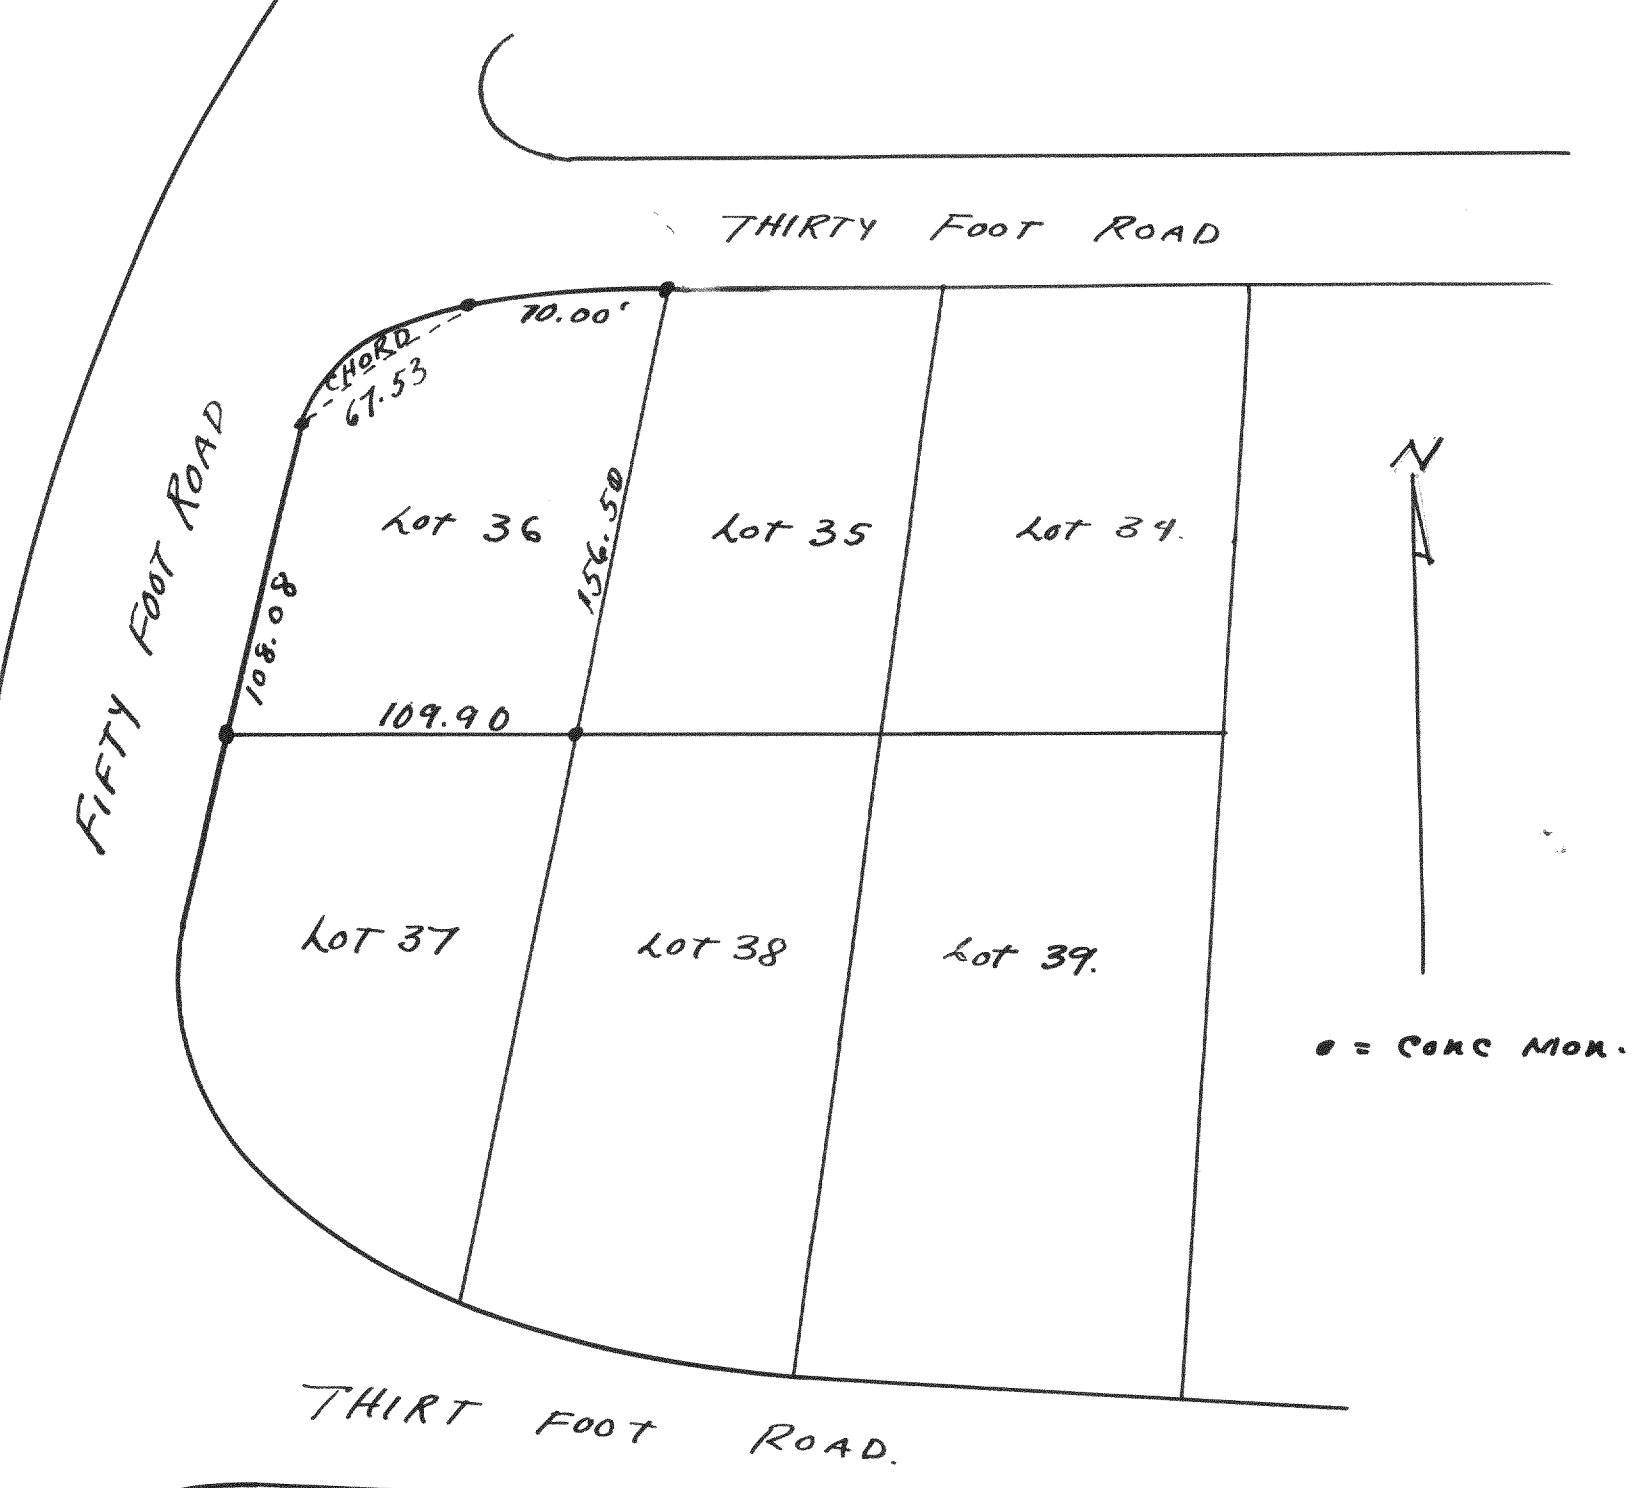

Plat of survey of lot 36. of unit 2 of
Country Club Estates a subd located in Sec's
14 & 23 T1N, R16E Wal. Co., Wis.

Sept 1946 Lloyd D. Jensen
Co. Sur.

#1700

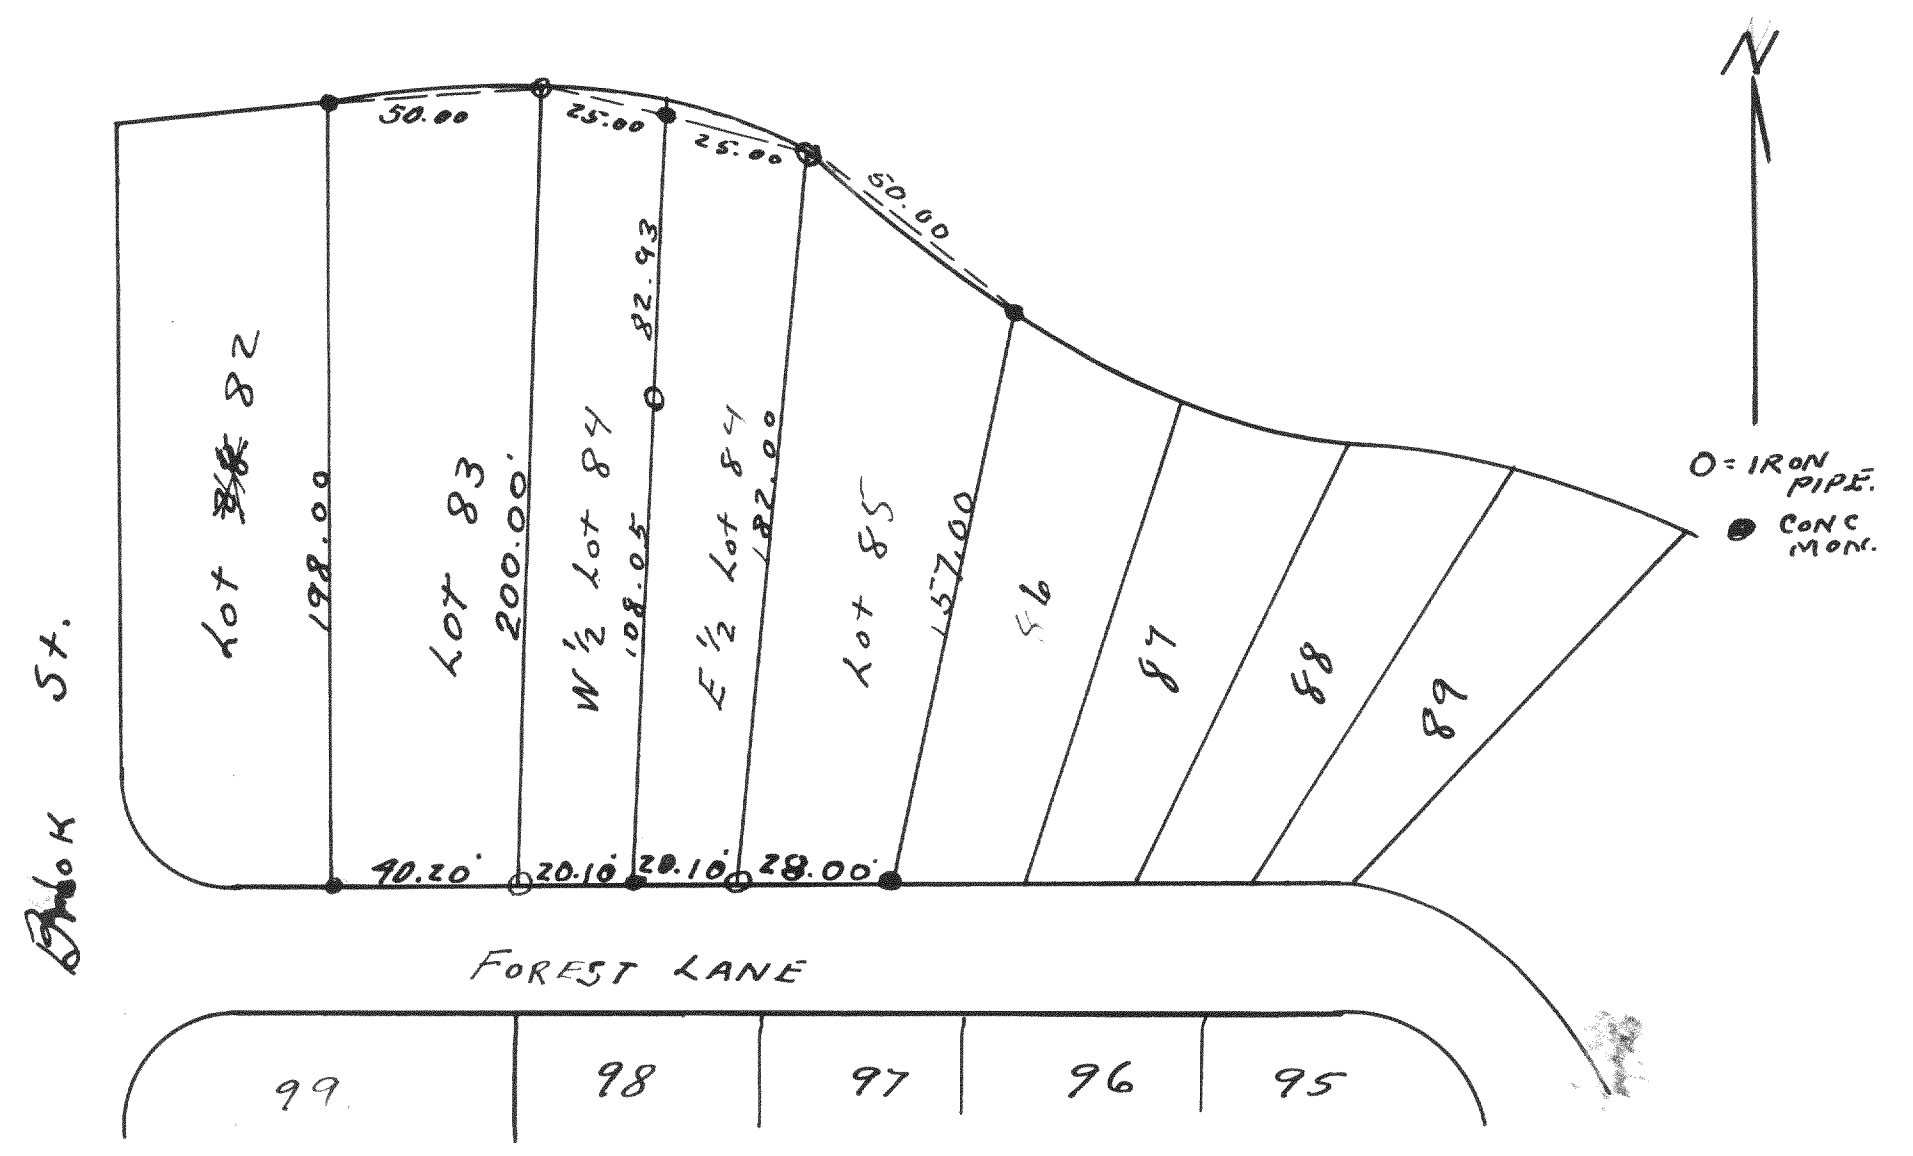

Plat of Survey of lots 83, 84 & 85 of
Buena Vista Subd. in the Village of FONTANA
ON Geneva Lake

MAY 14 1946 Lloyd D. Jensen
Co. Sr.