


#1705

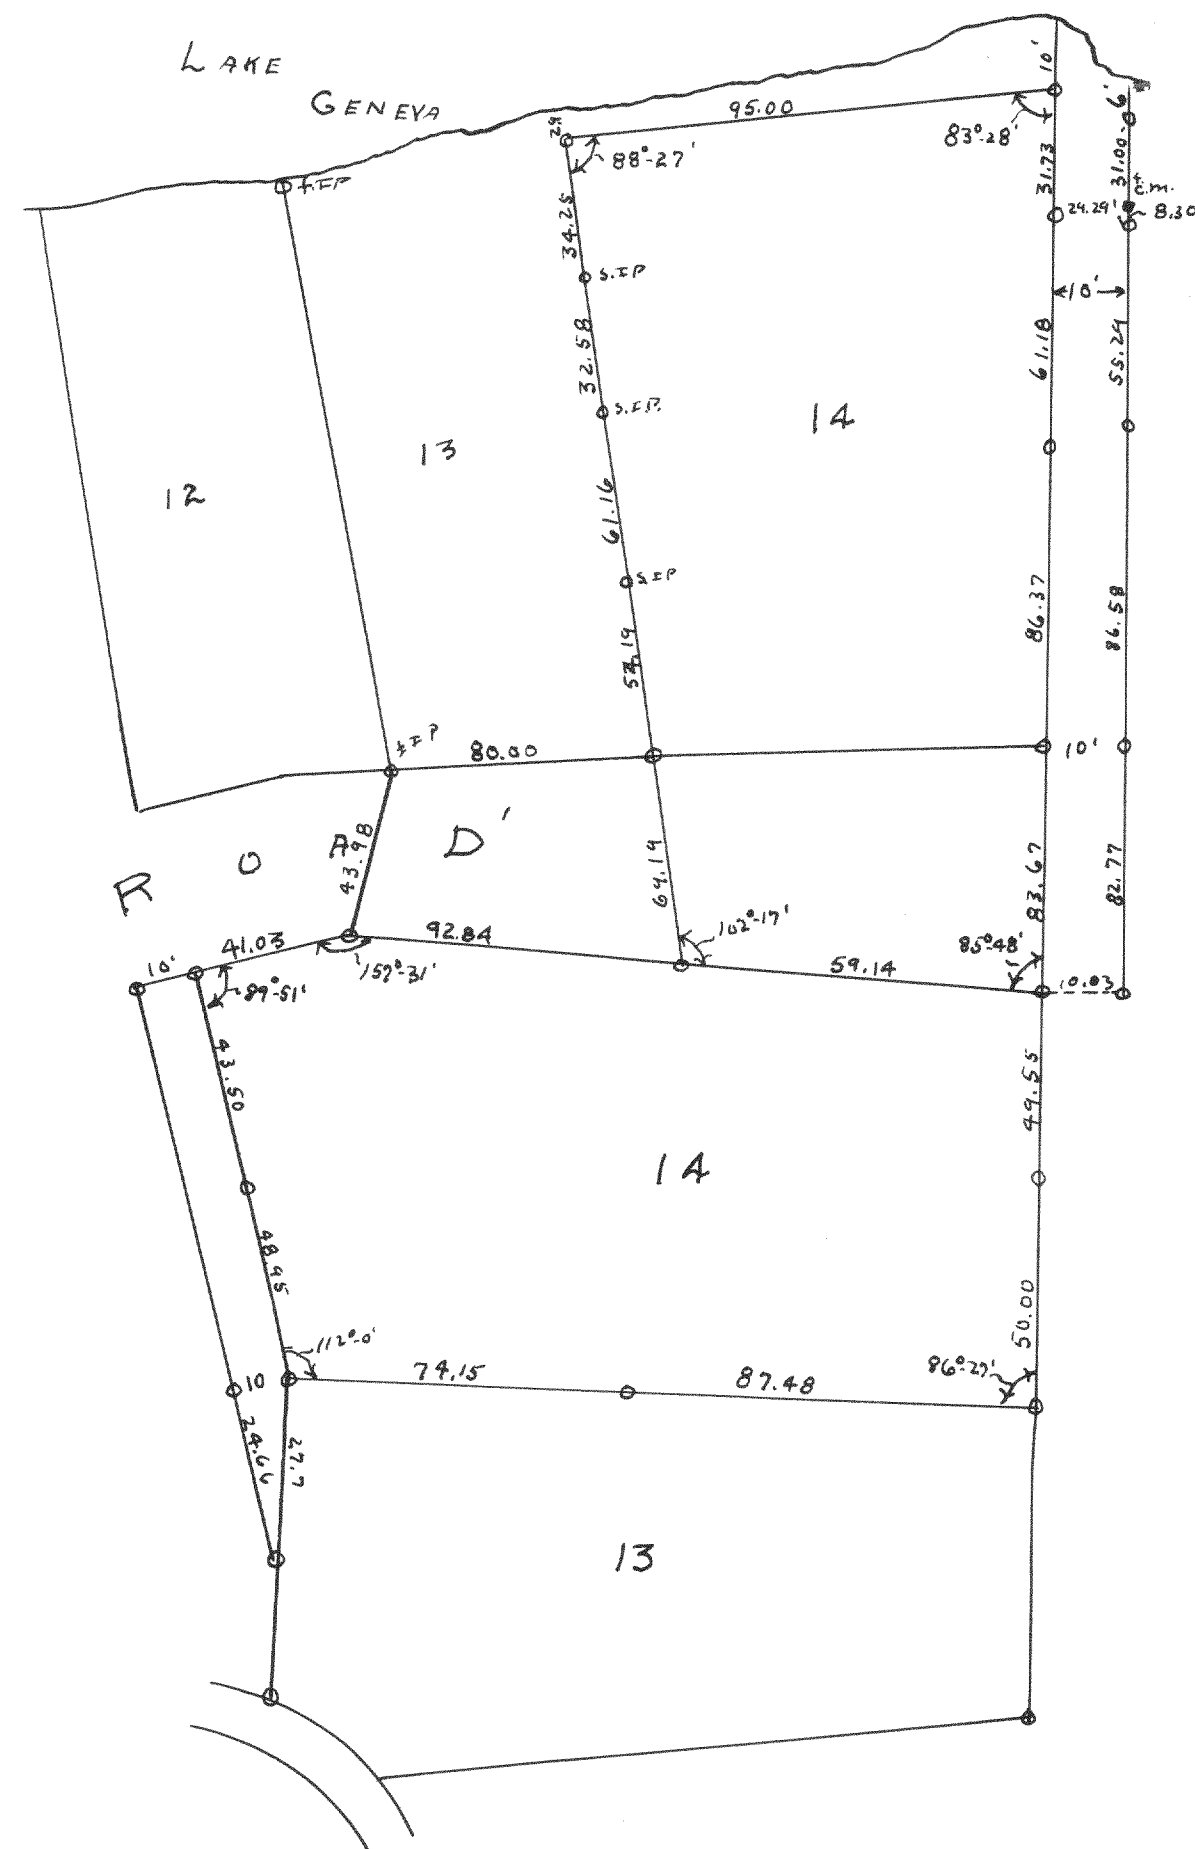


Plot of survey of LOT 14 BLK 3 and of LOT 14 BLK 1
Woodale Subdivision, south of Lake Geneva Walworth
County Wisconsin

September 8, 1947

Lloyd L. Jensen
County Surveyor
[Signature]

#1706

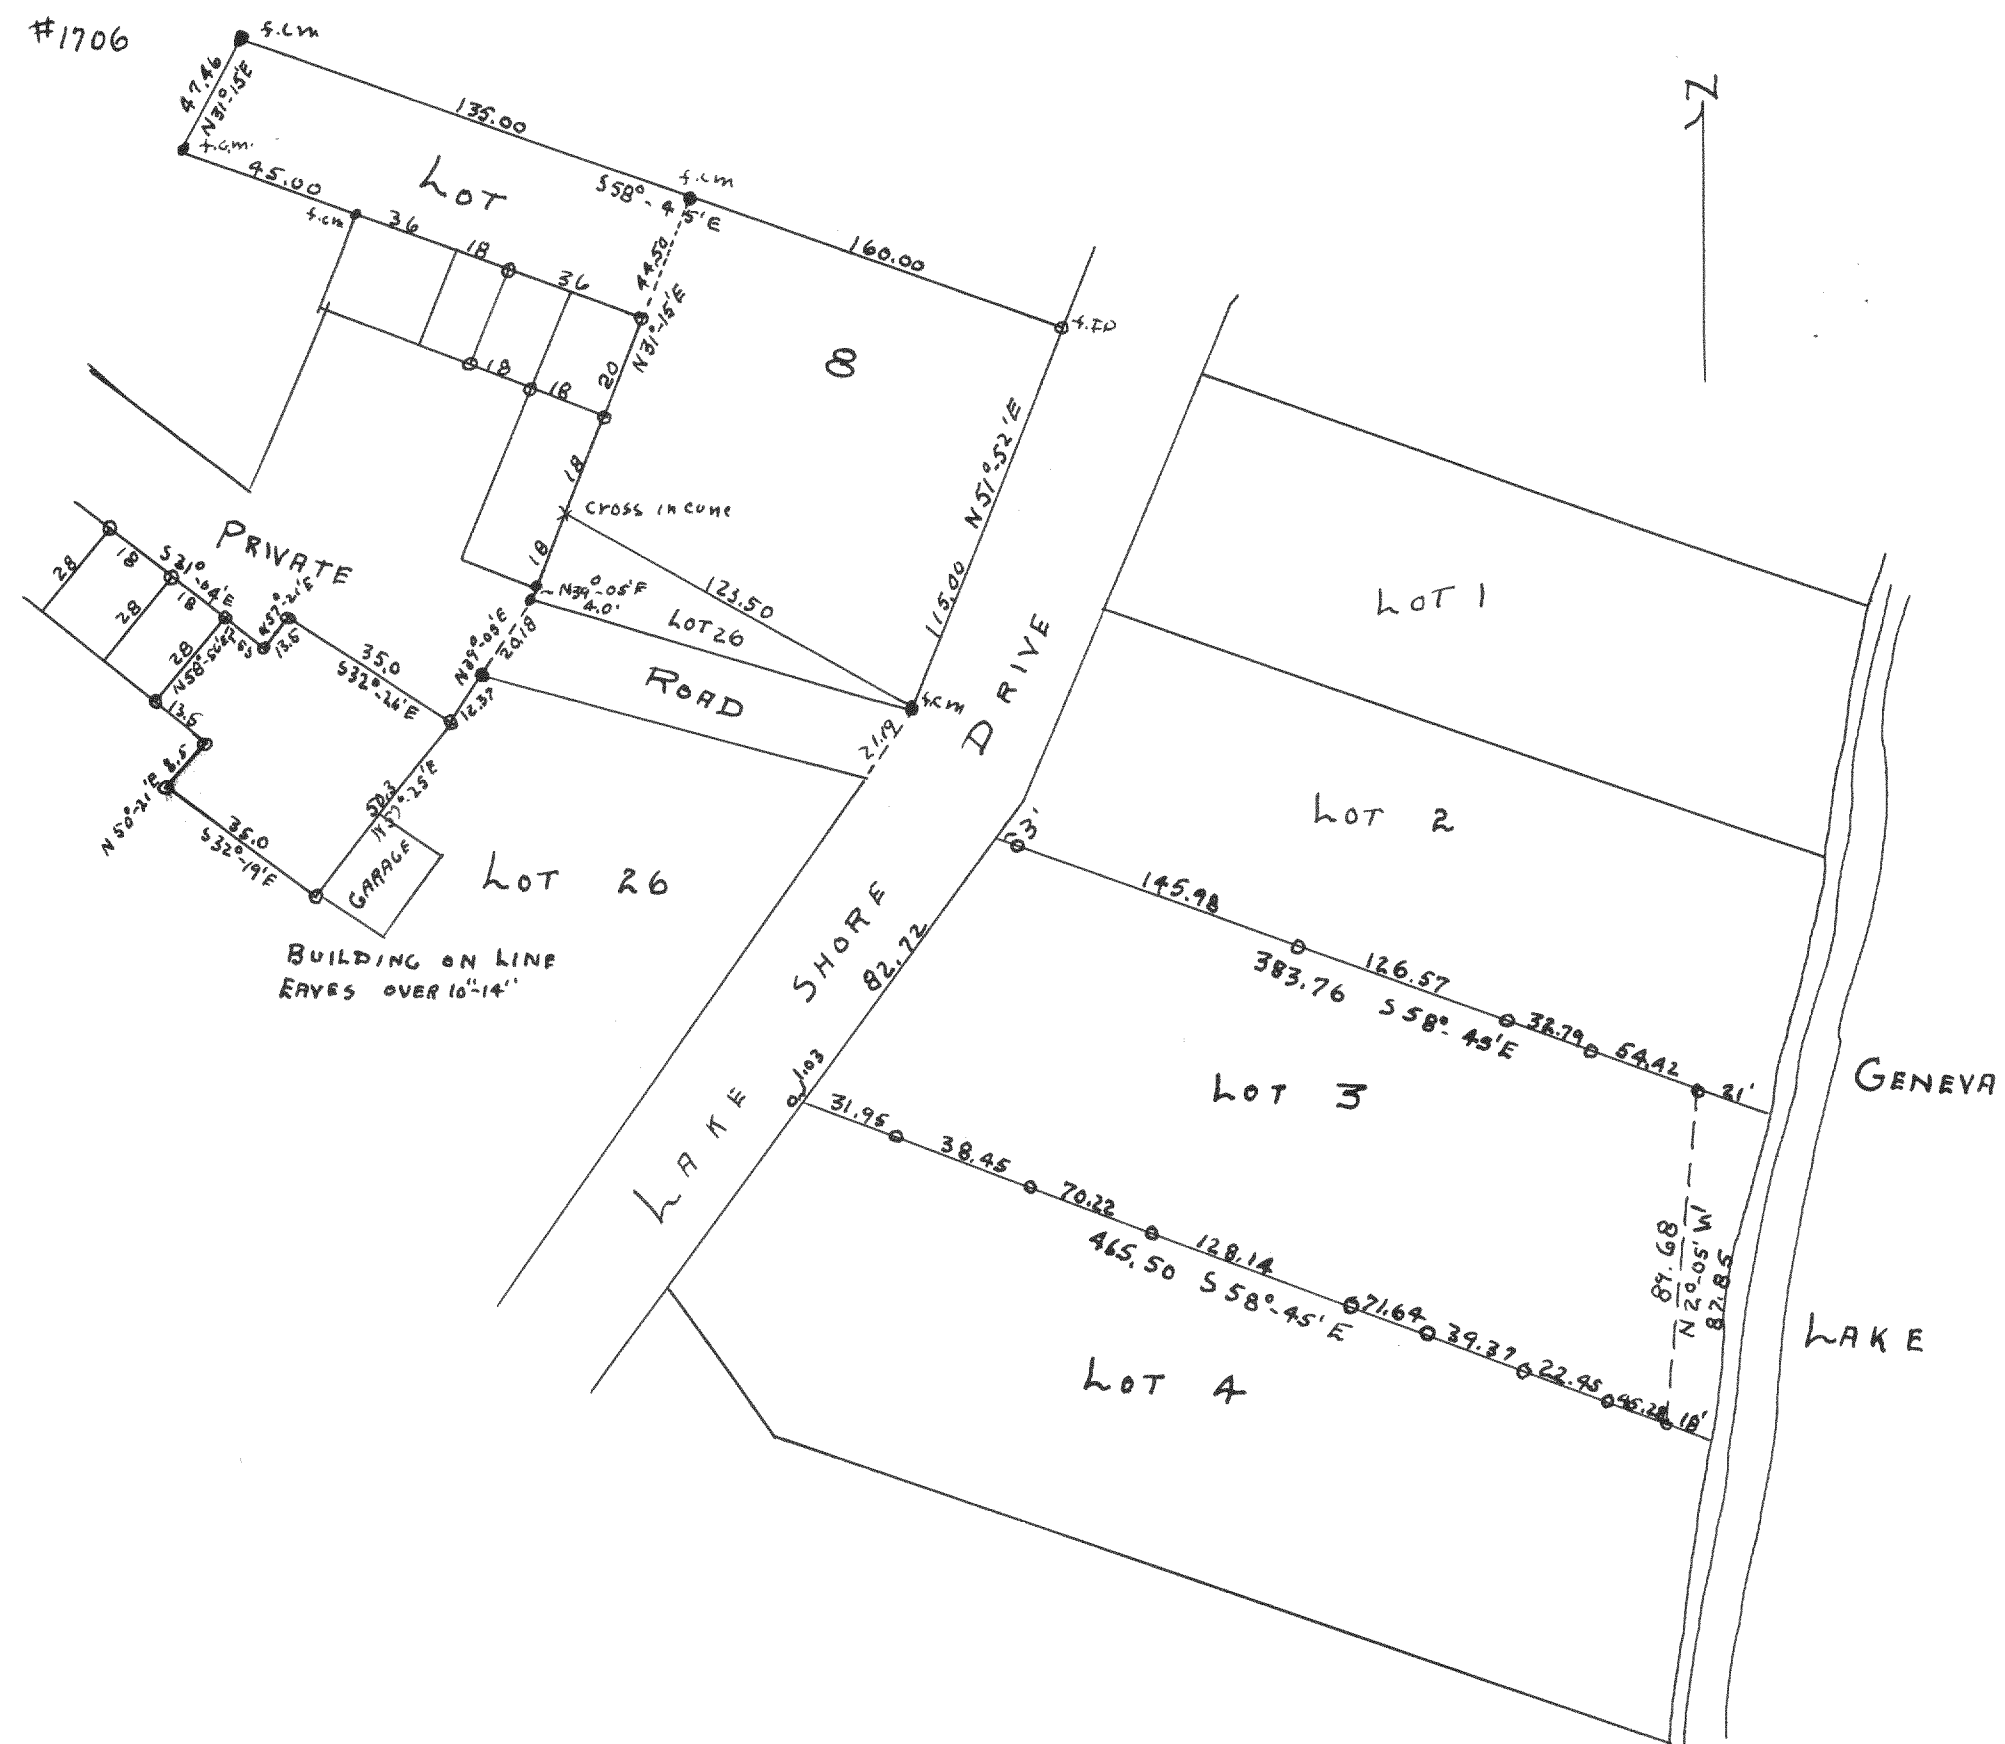

Plot of survey of Lots 3, 8, and part of 26 in The Gardens located in
Fontana - Walworth County Wisconsin

October 1947

Lloyd L. Jensen
County Surveyor
[Signature]