


1707

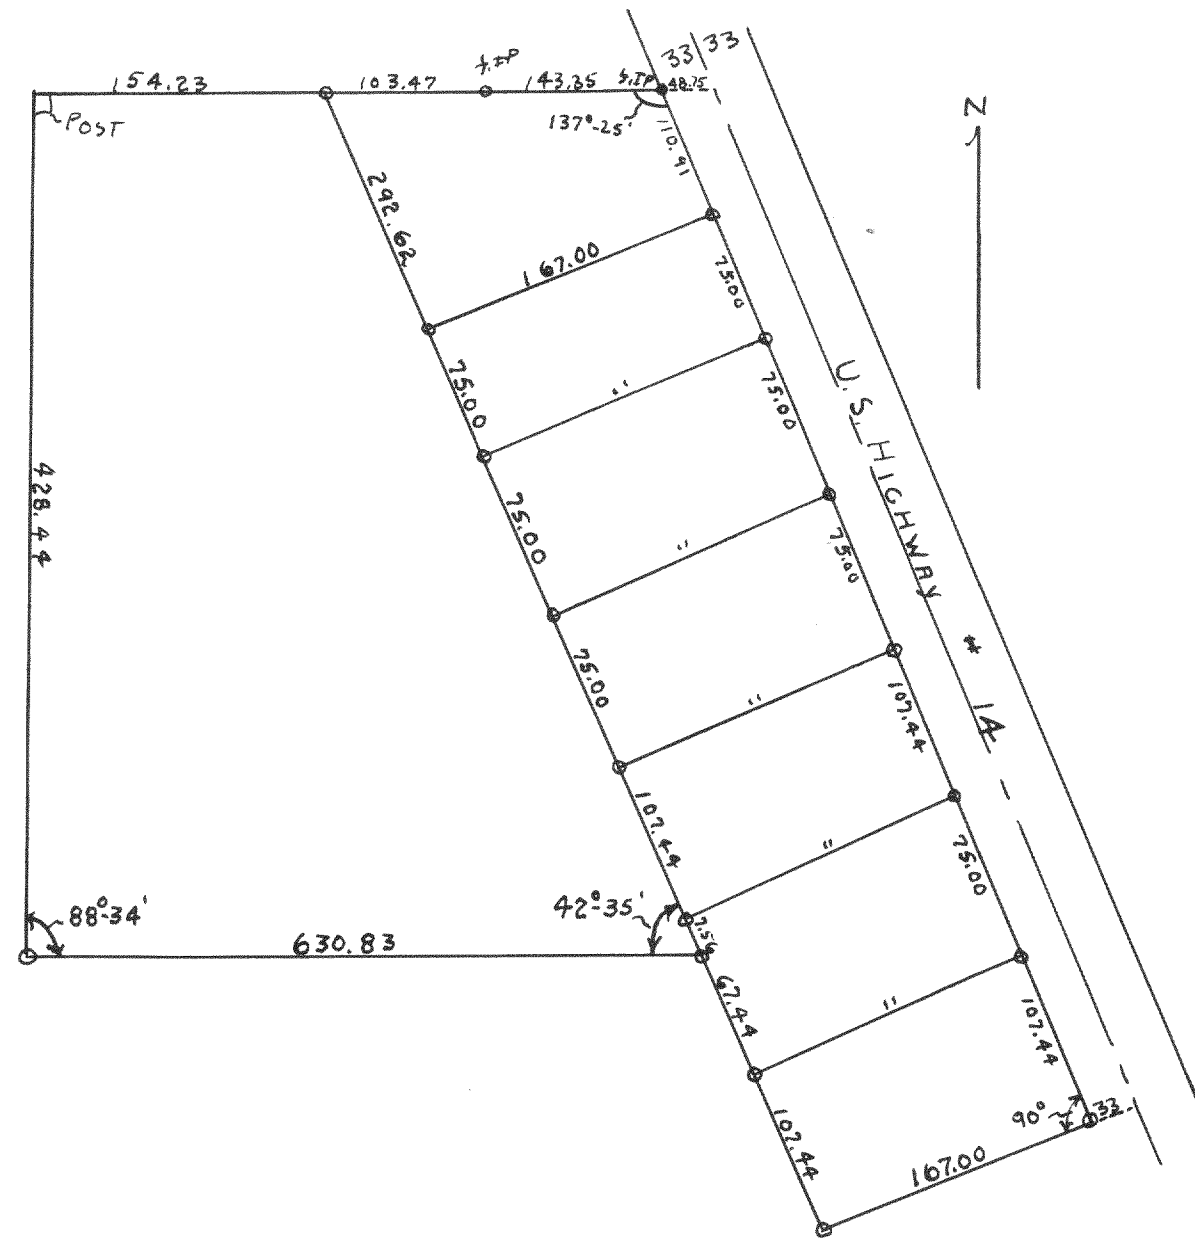


Plot of survey on the Tiele Steens Farm located in section 34-2-15 Walworth County Wisconsin

Sept 26, 1947

Lloyd S Jensen
County Surveyor
LSD

1708

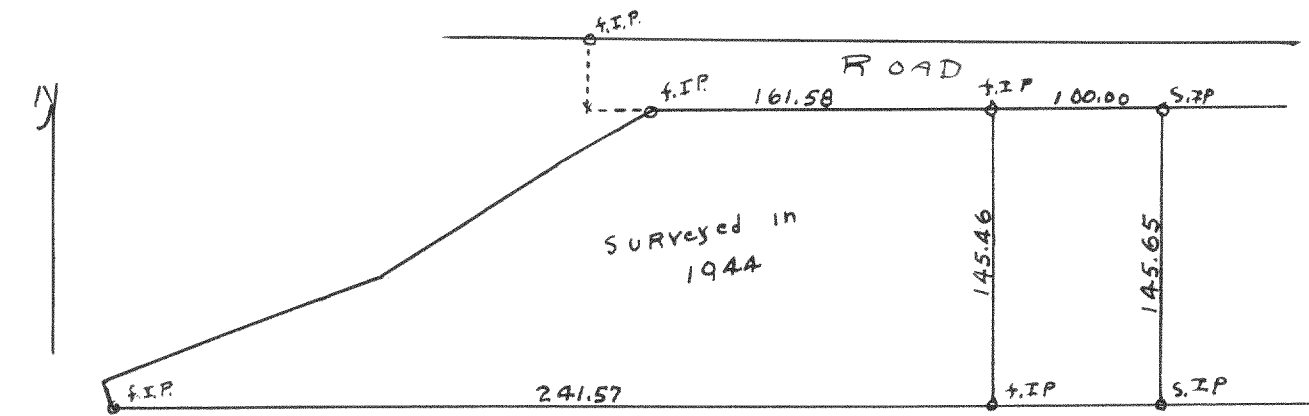


Plot of survey of 100 parcel of land located in Jewels subdivision Village of Williams Bay, Walworth County, Wisconsin

September 27, 1947

Lloyd S Jensen
County Surveyor
LSD

1709

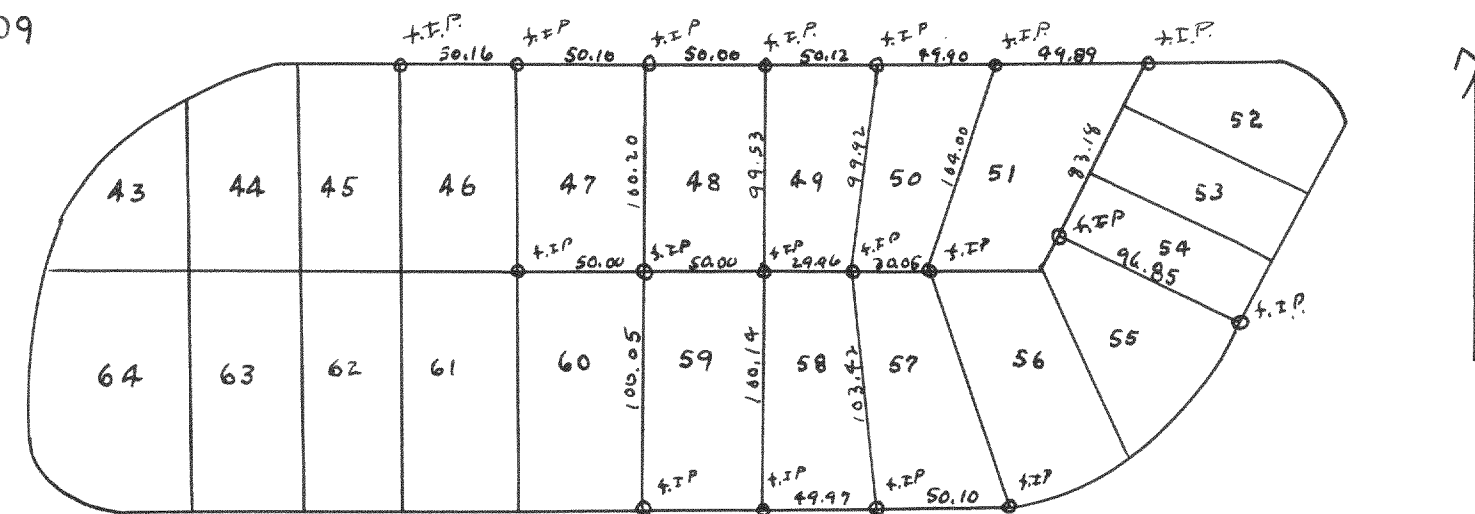

Plot of survey of Lots 49-51, 55-58 Buena Vista in Fontana, Walworth County, Wisconsin

1947

Lloyd S Jensen
County Surveyor
LSD