


NOV. 17, 1947

Lloyd L. Jensen  
County Surveyor  
225

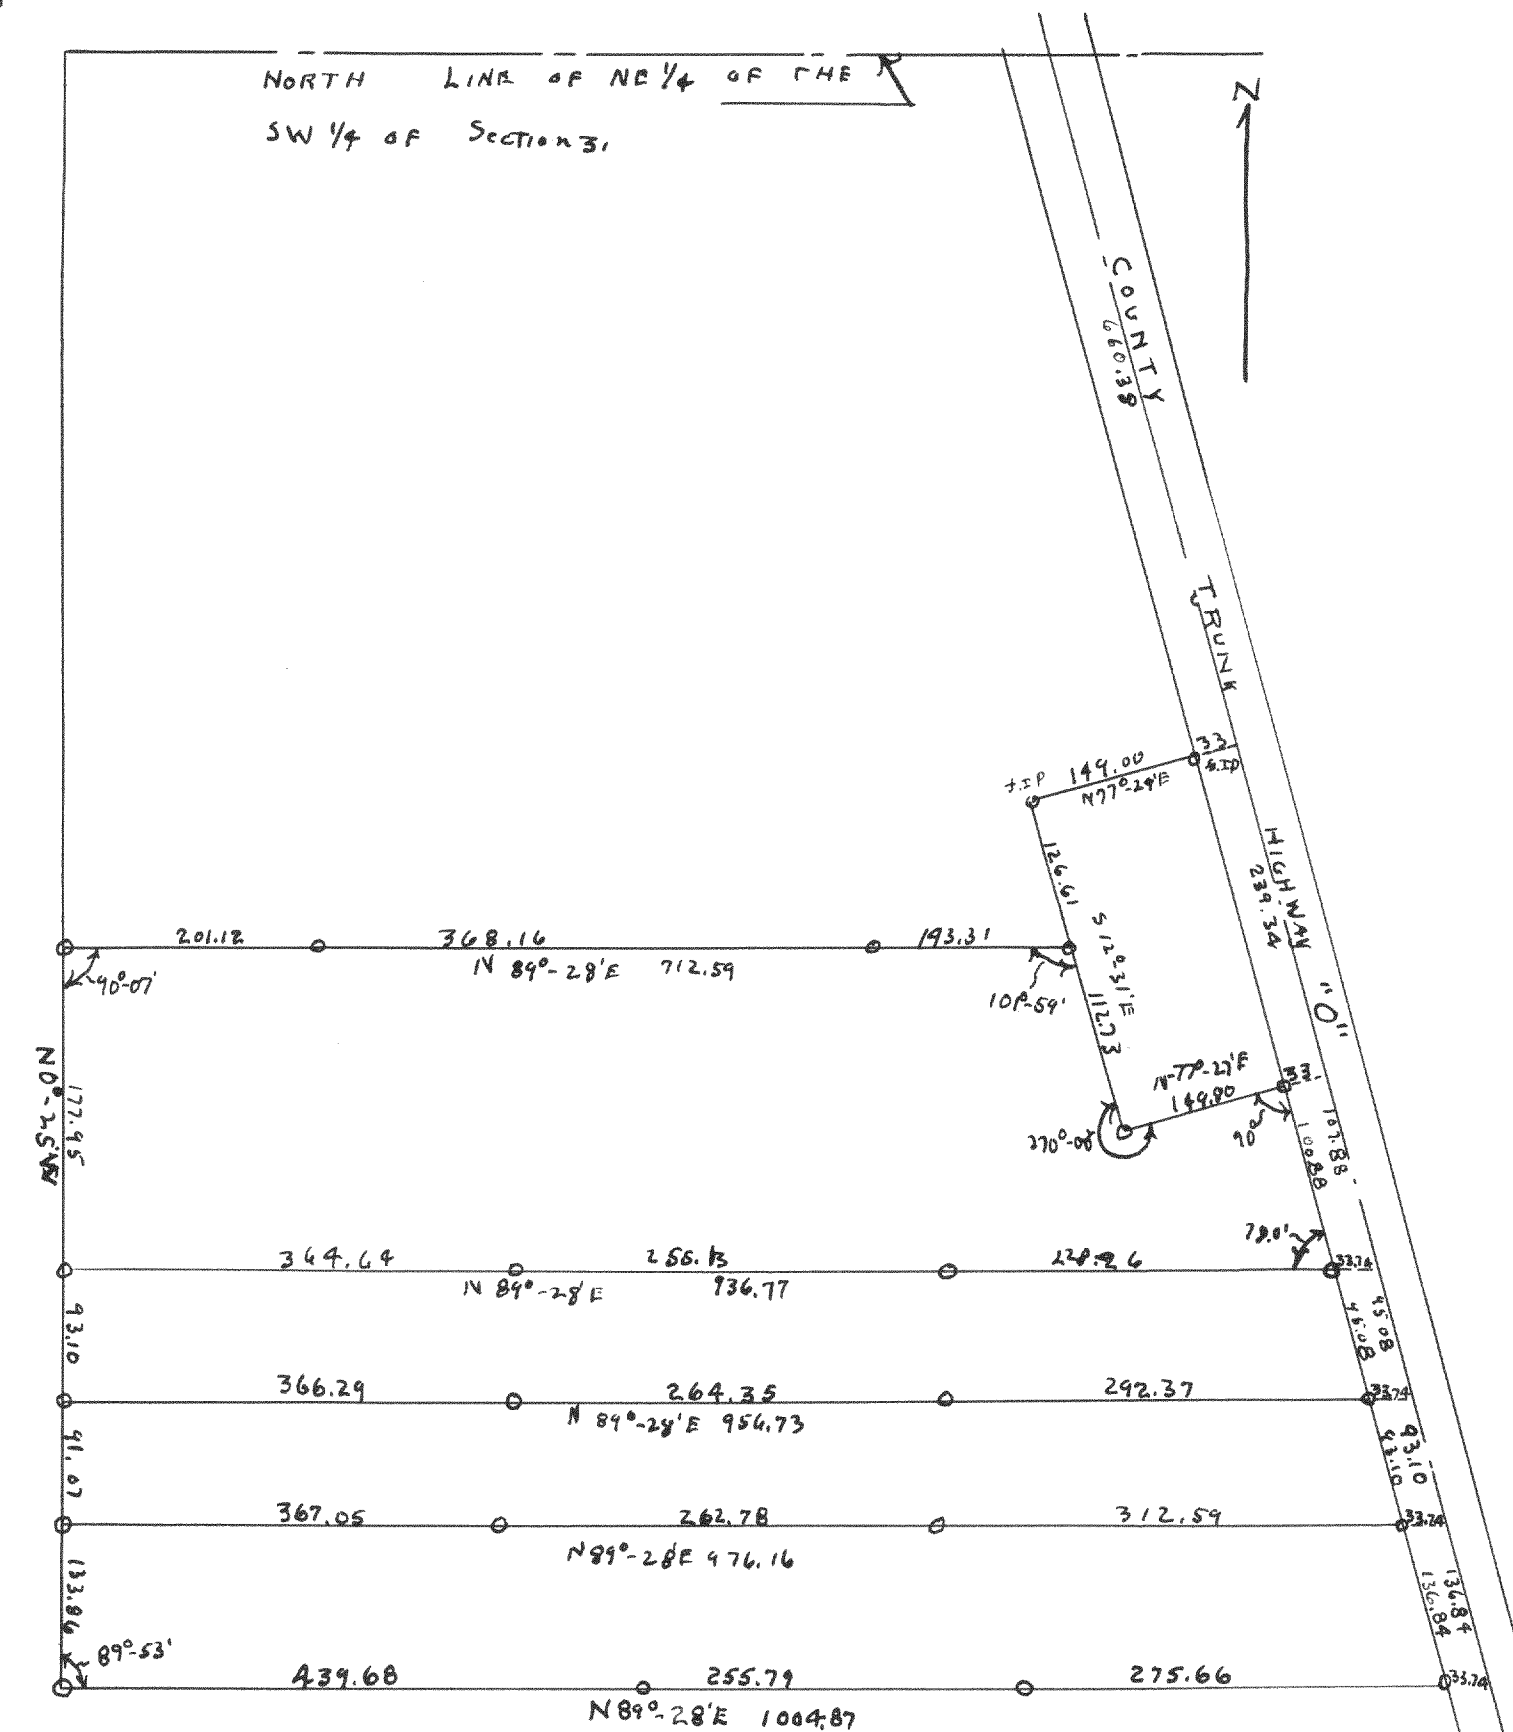

Plot of survey on the Dischner Property located in Section  
31, T2N, R. 14E of Malheur county, Oregon

Aug. 1947

Elroy L. Jensen  
County Surveyor  
220