
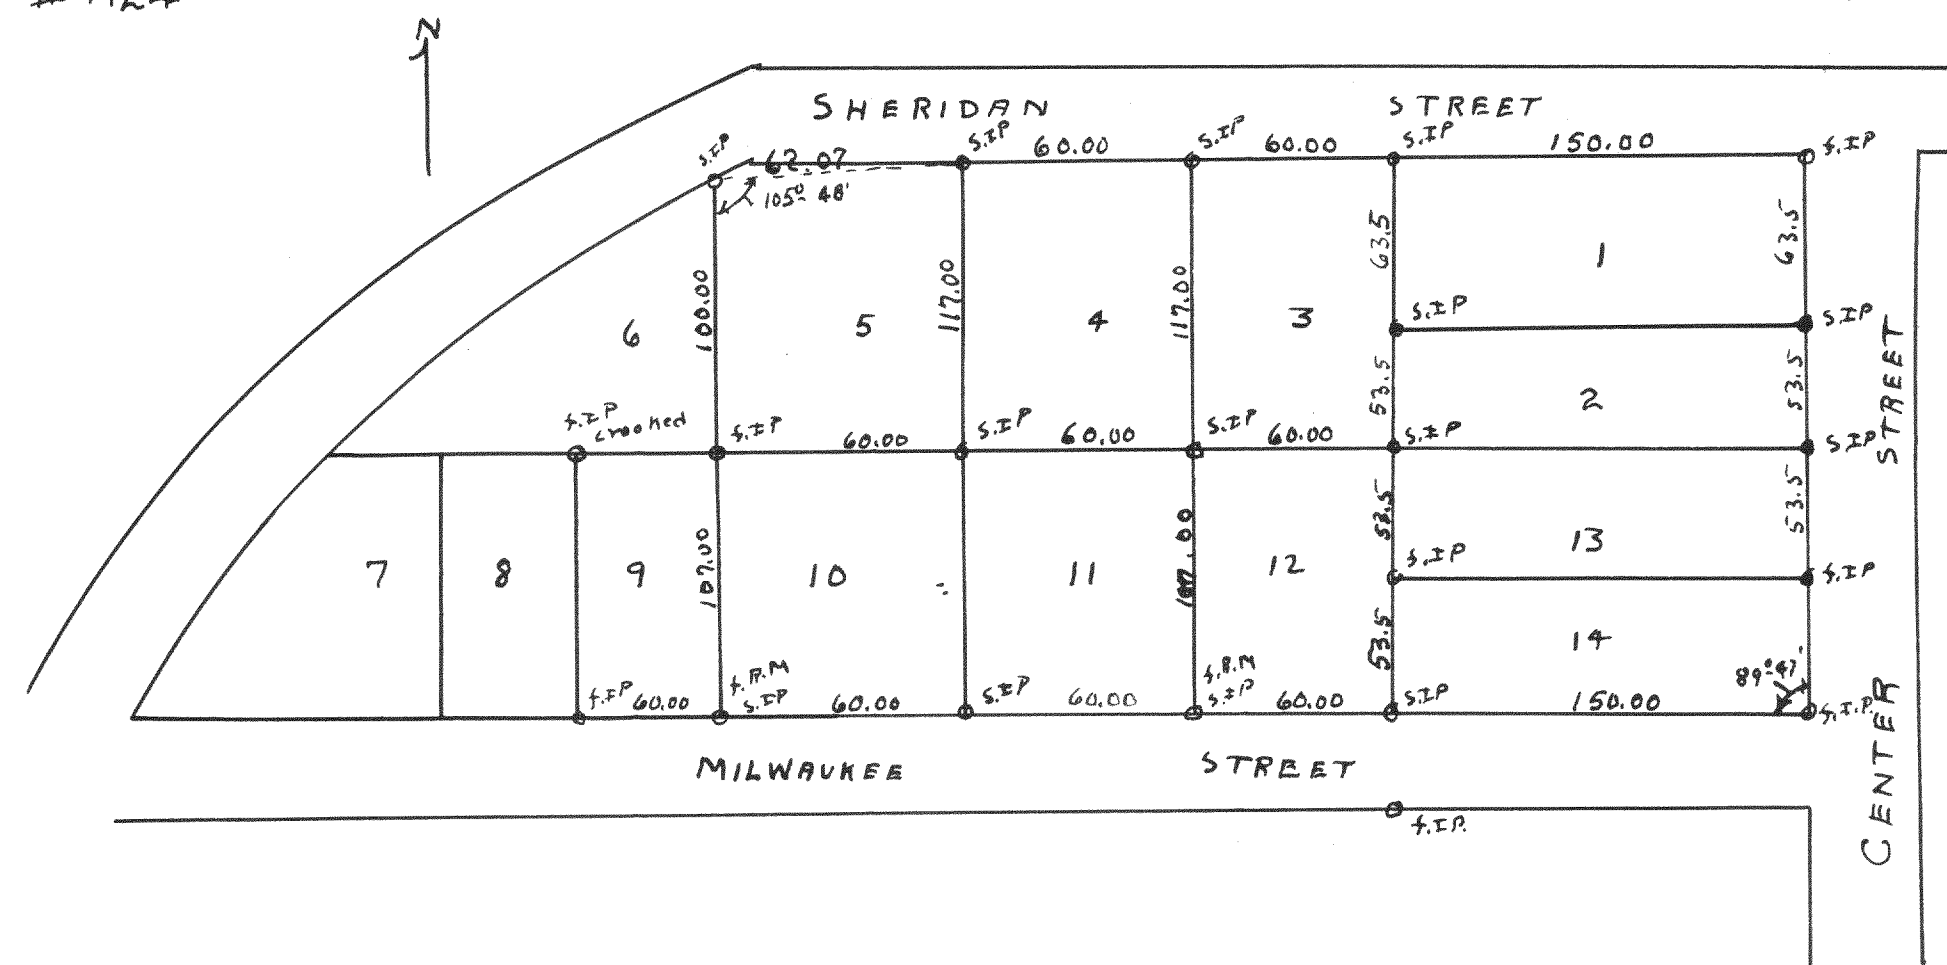


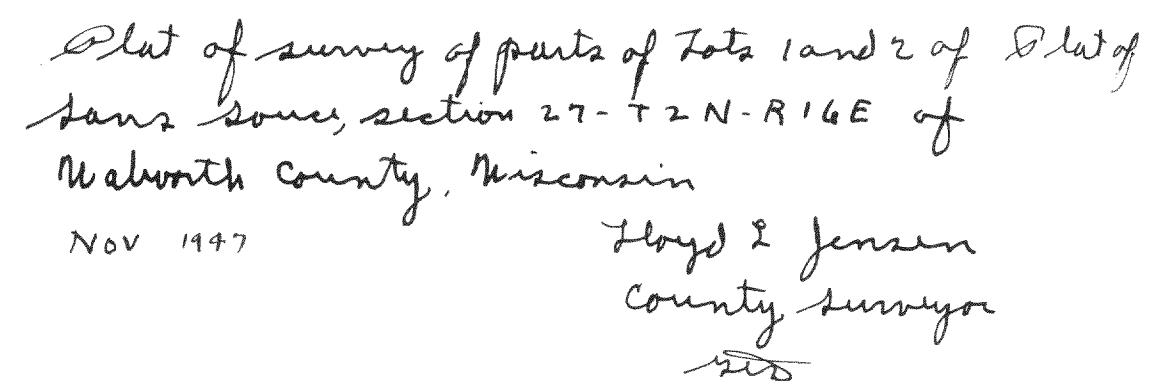

Plot of Survey of Lots 1-9, 10-14 in Markham's subdivision
in city of Lake Geneva, Mahoning County, Ohio

December 5, 1947

Floyd E Jensen
County Surveyor
213