



#1725

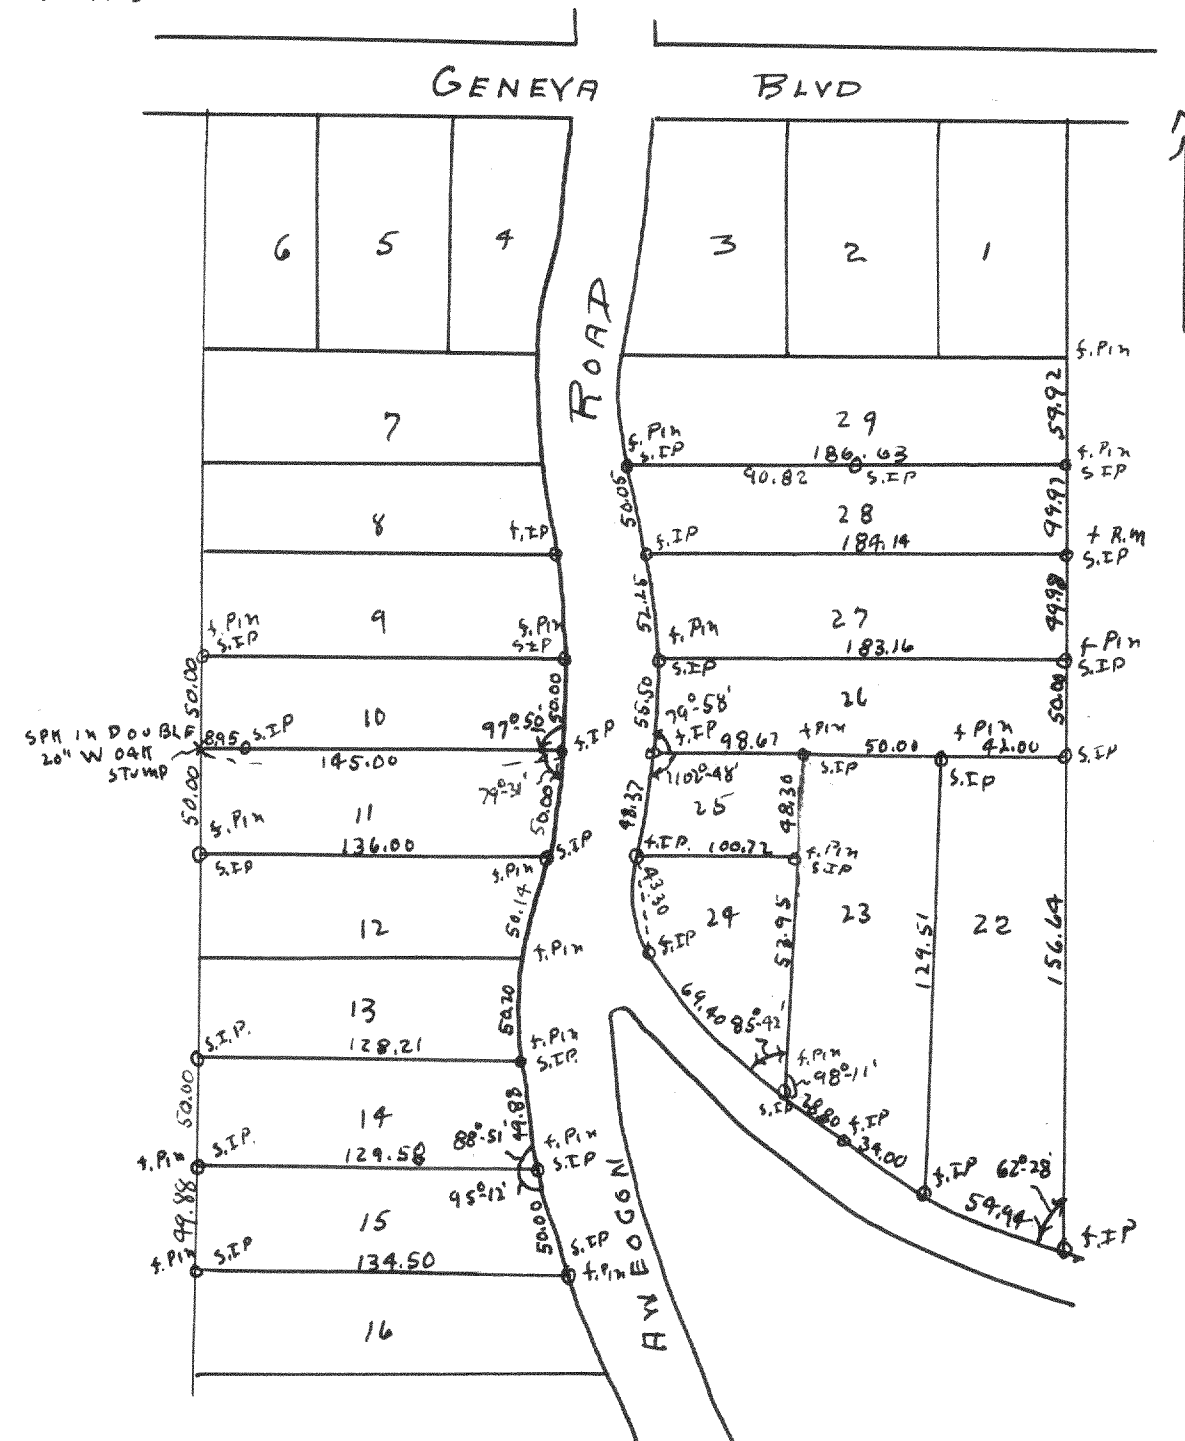

Plat of survey of lots 10, 11, 14, 15, 22-28 of
Block 6 Indian Hills in Montana, Malworth
County, Wisconsin
Dec. 1947
Lloyd I Jensen

Lloyd I Jensen
County Surveyor
RIS

1726

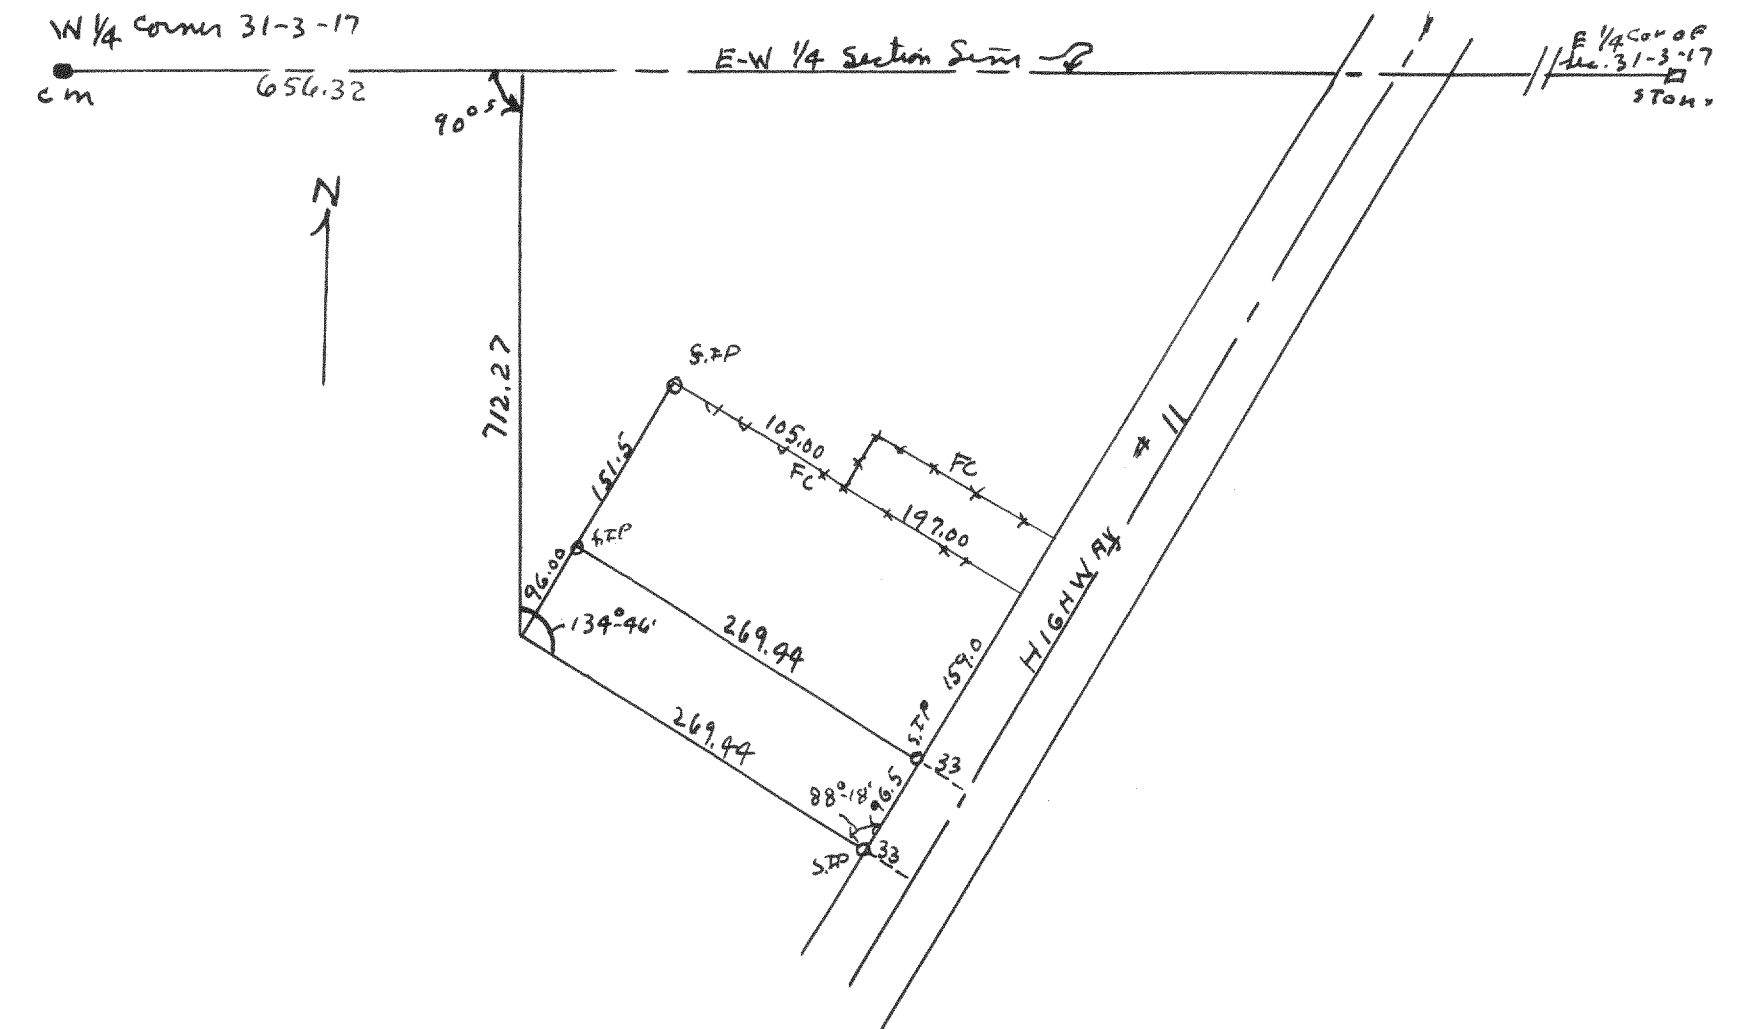

Plot of survey of parcel of land owned by Z Stearns and
located in the City of Elkhorn, Walworth County Wisconsin

Dec 10, 1947

Floyd S. Jensen
County Surveyor
SD