



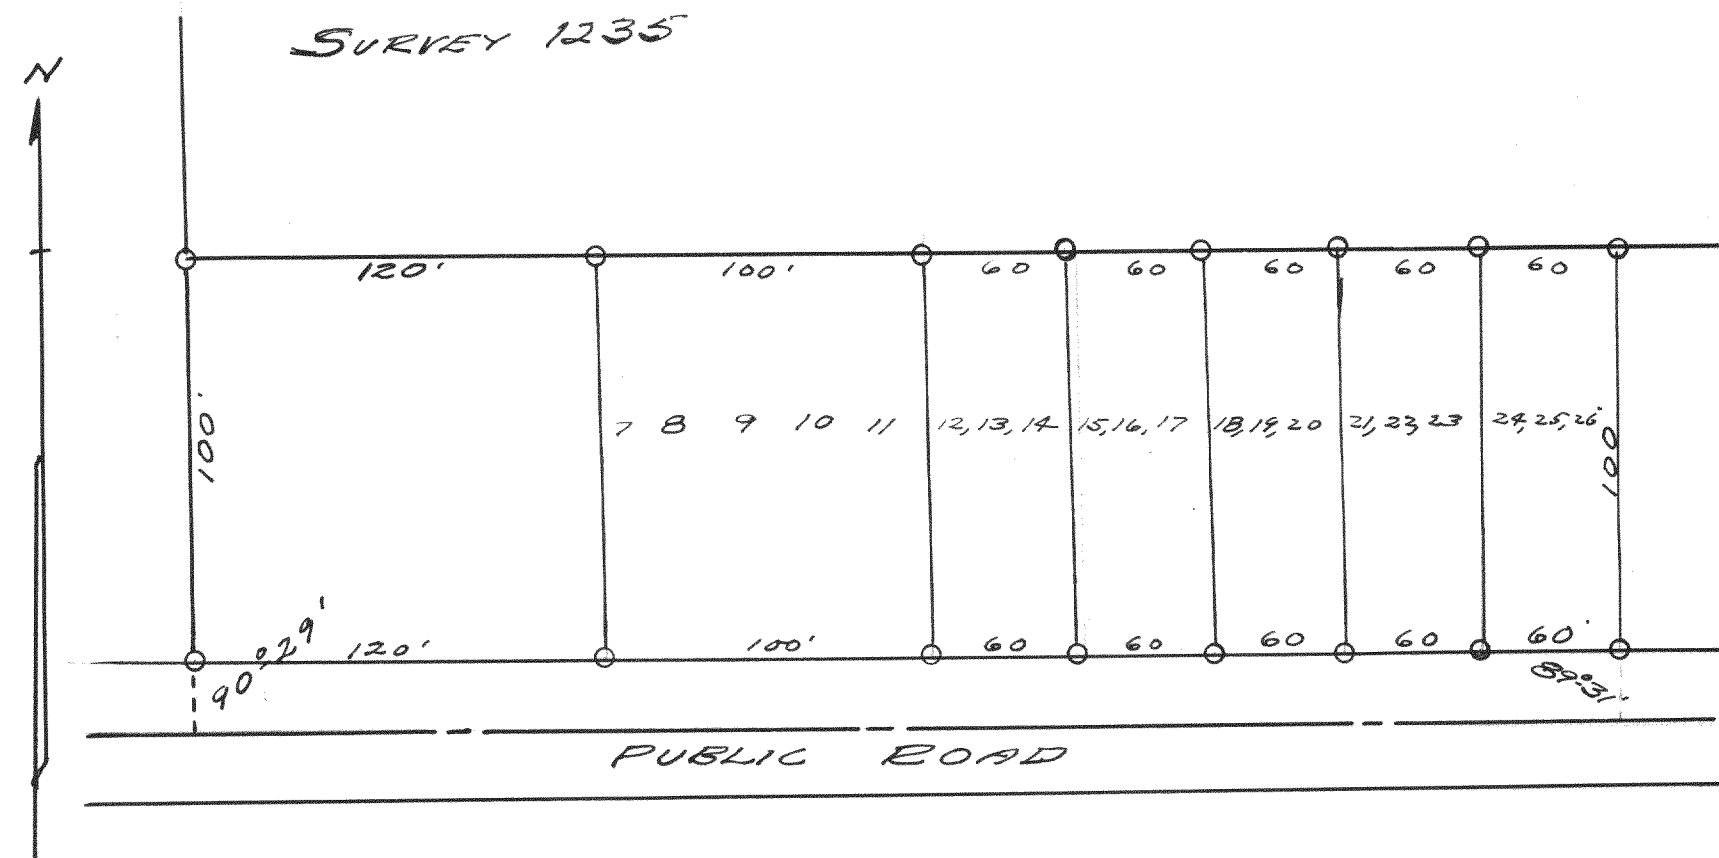

PLAT OF SURVEY OF LOTS 7 TO 26 INC. OF PELL FARM
ANNEX
AUG. 1941

Lloyd L. Jensen
R.E.J.

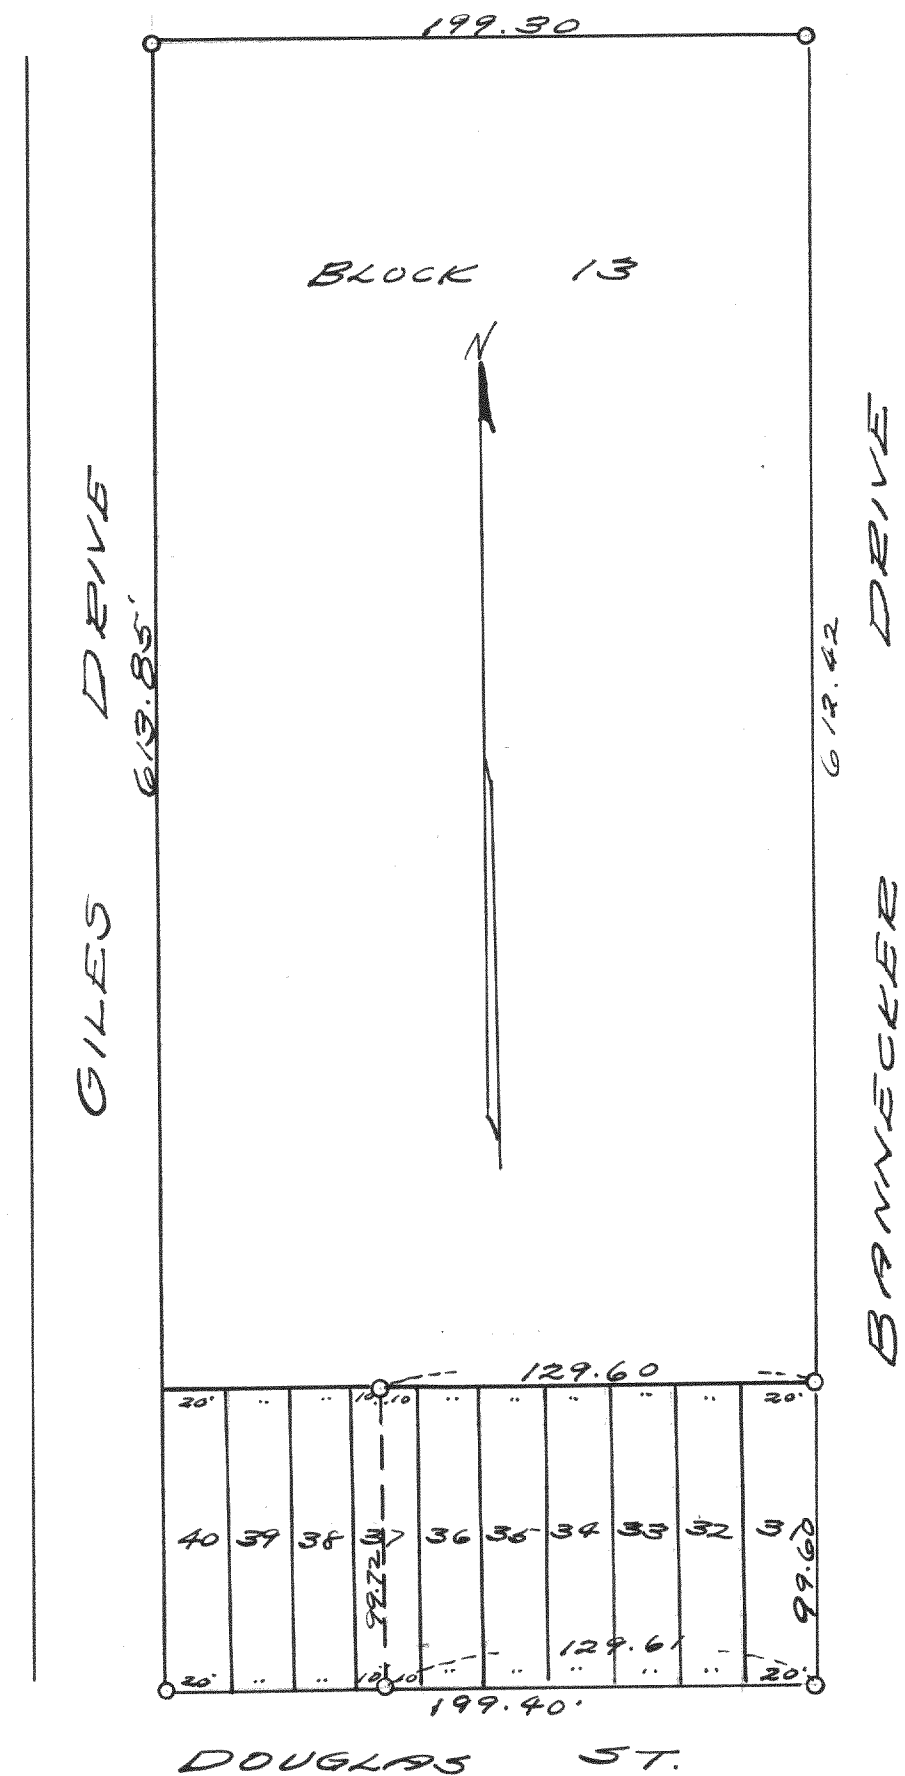

PLAT OF SURVEY OF LOTS 31 TO 36 OF
BLOCK 13, OF LAKE IVANHOE SUBD.,
WALWORTH COUNTY, WISCONSIN.
APRIL, 1941

Lloyd L. Jensen
R.E.J.