


#1727



#1728

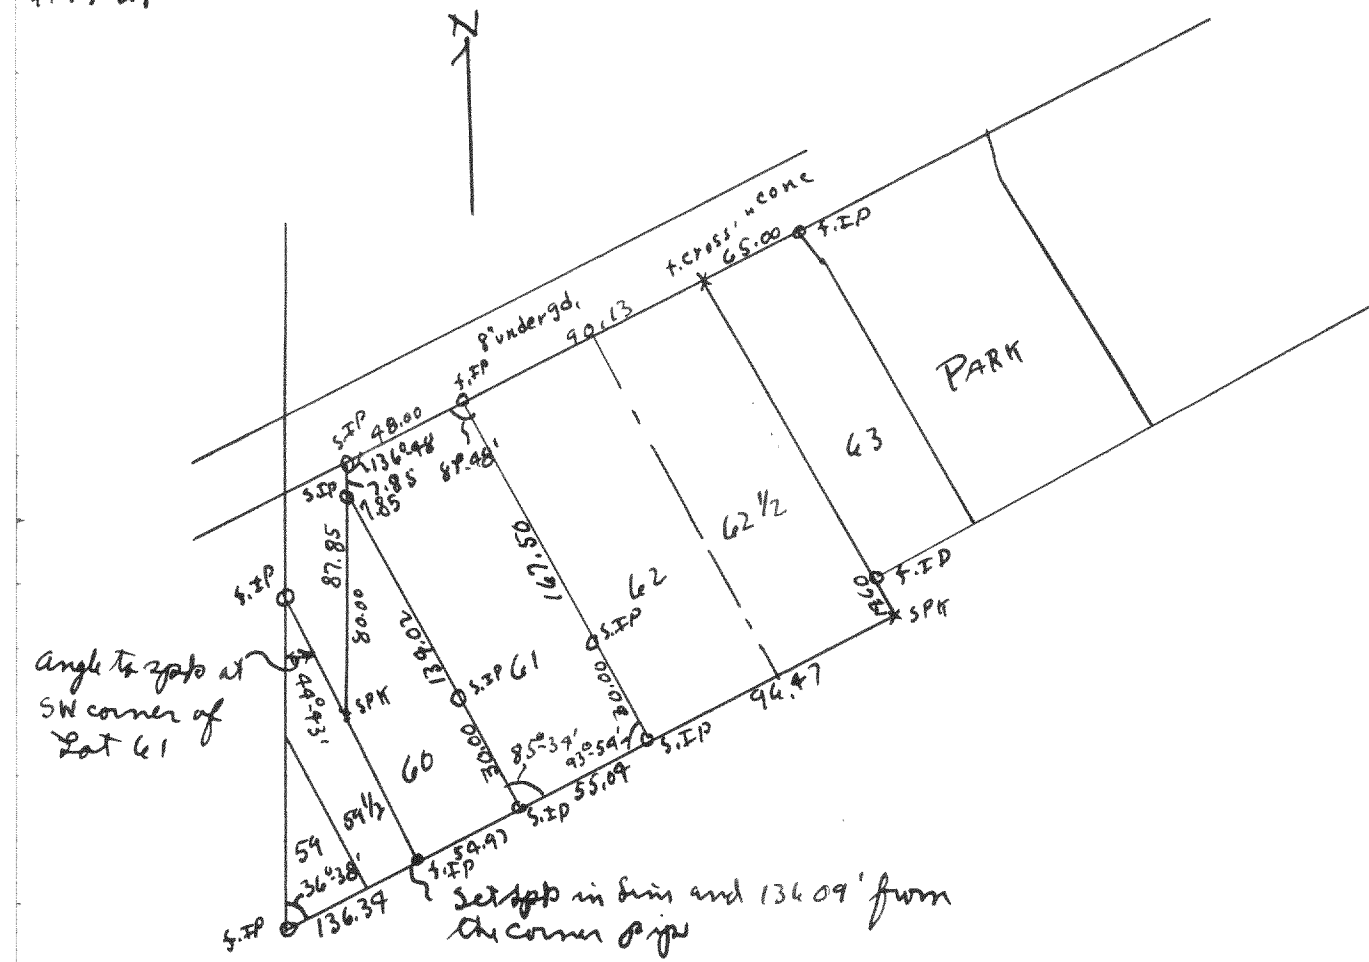