



#1729

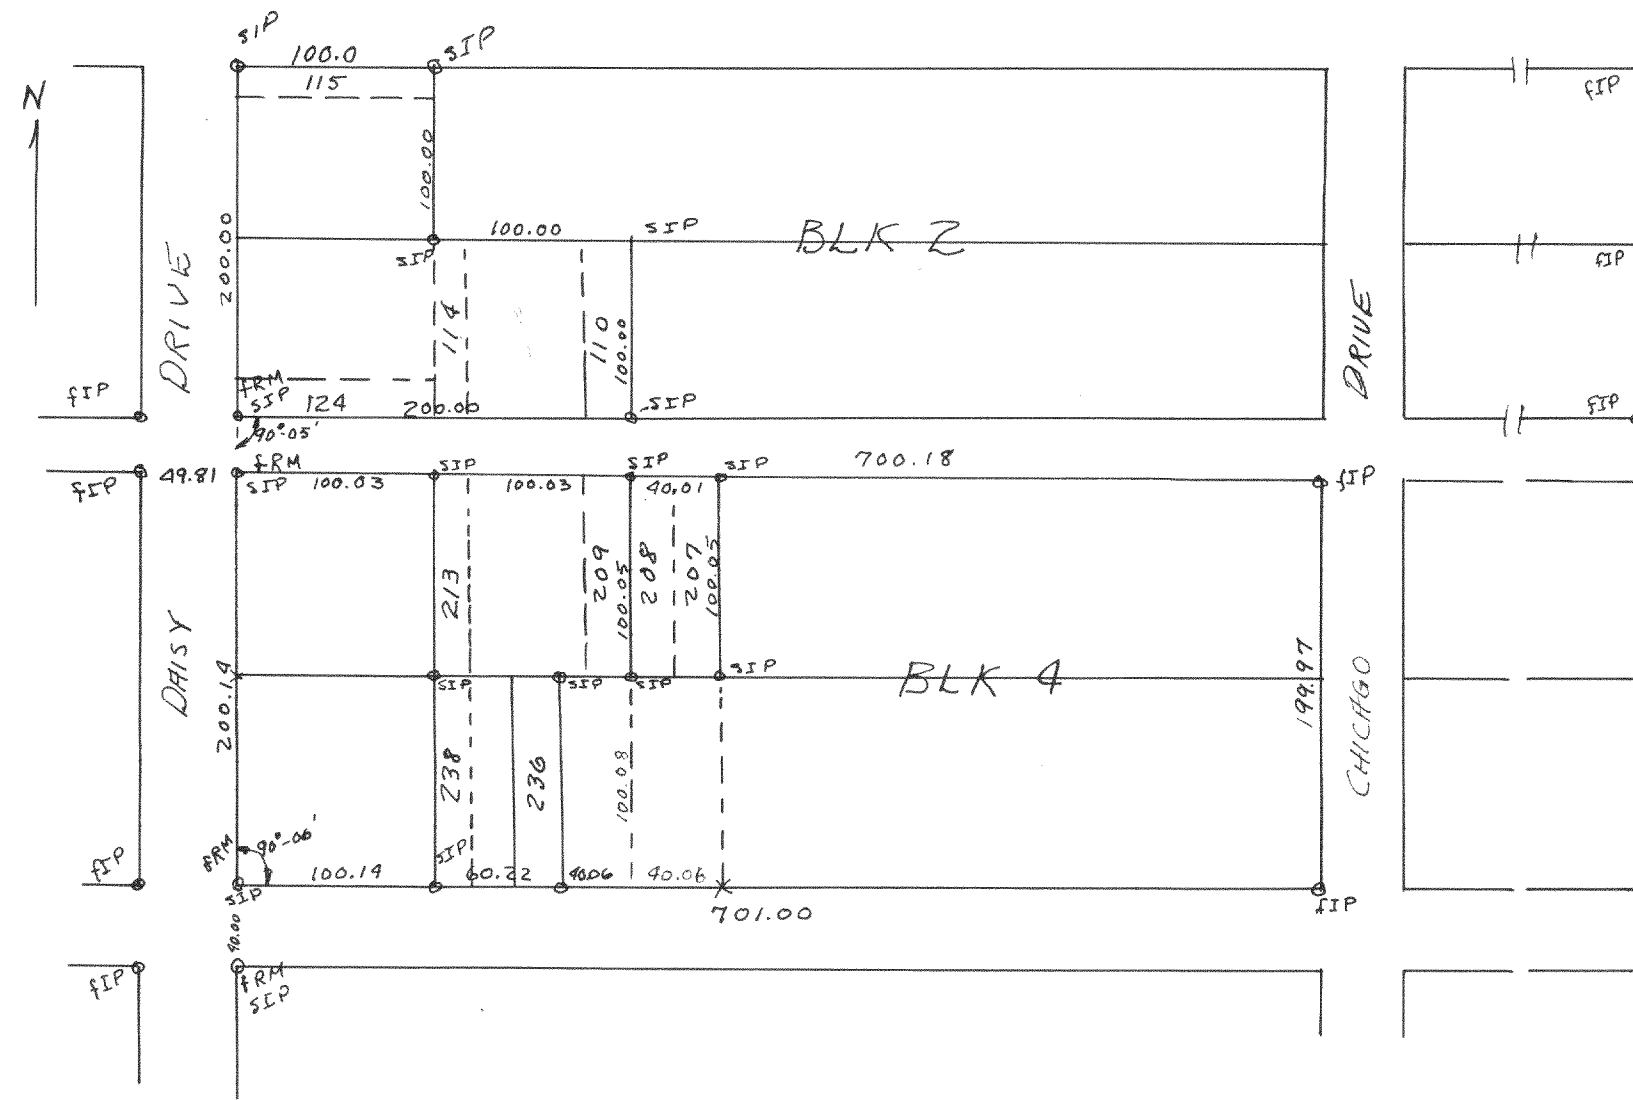

Plot of survey of lots 110-124, 207-213, 236-238 in
Oak Lake Addition Malvorth County, Wisconsin
April 2, 1947

Lloyd L. Jensen
County Surveyor
LSD

#1730

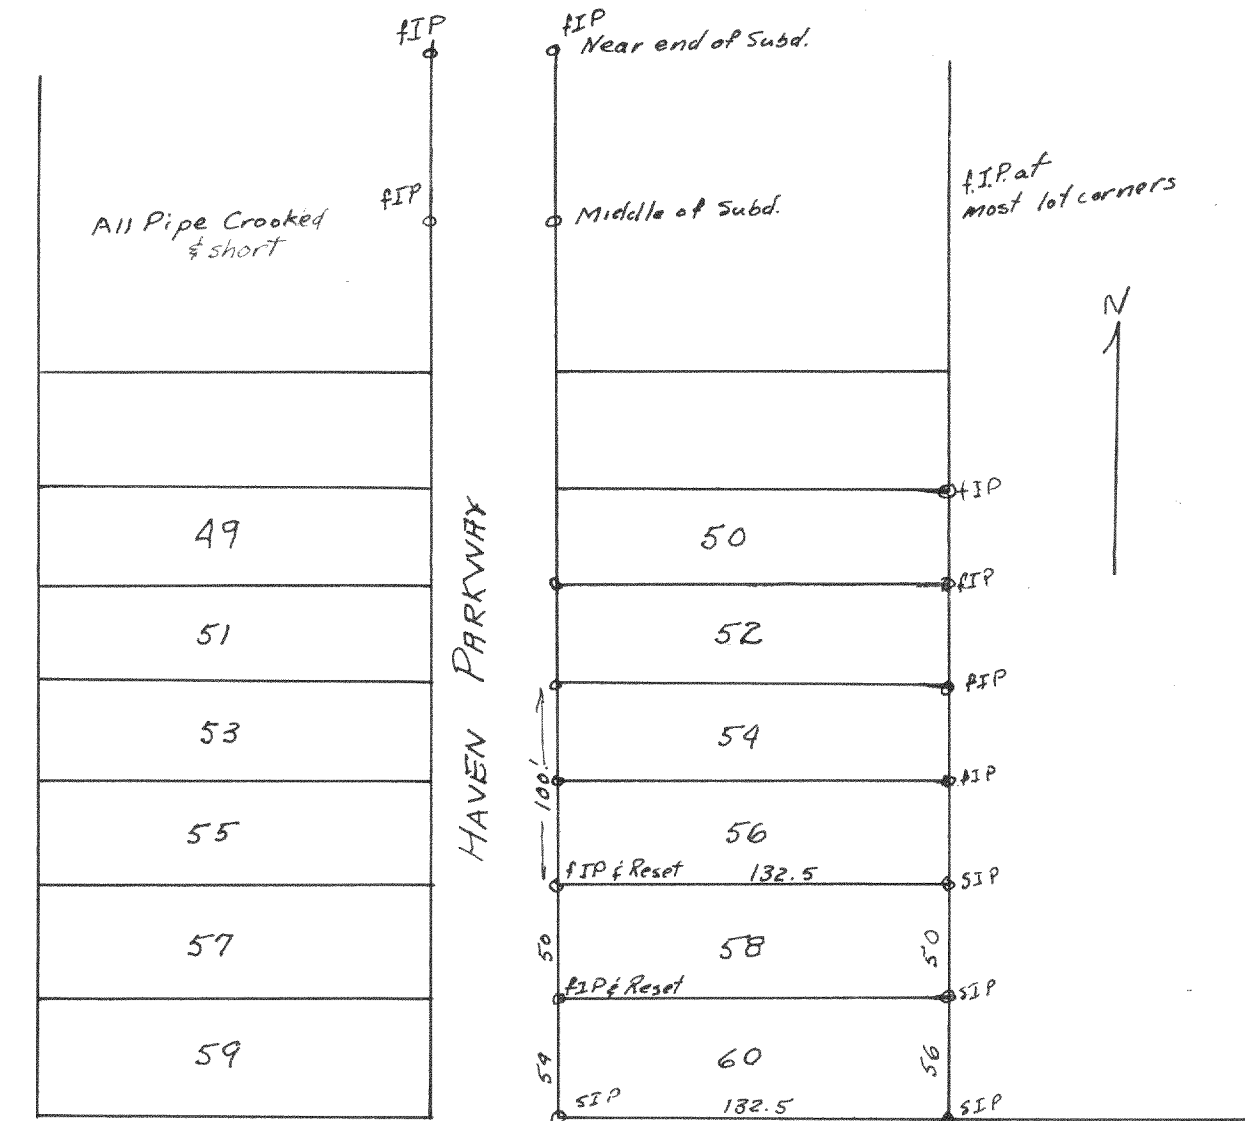

Plot of survey of lots 58 & 60 in Shore Haven Subdivision in
Section 18 T1N R12E of Malvorth County Wisconsin

April 11, 1947

Lloyd L. Jensen
County Surveyor
LSD