



#1731

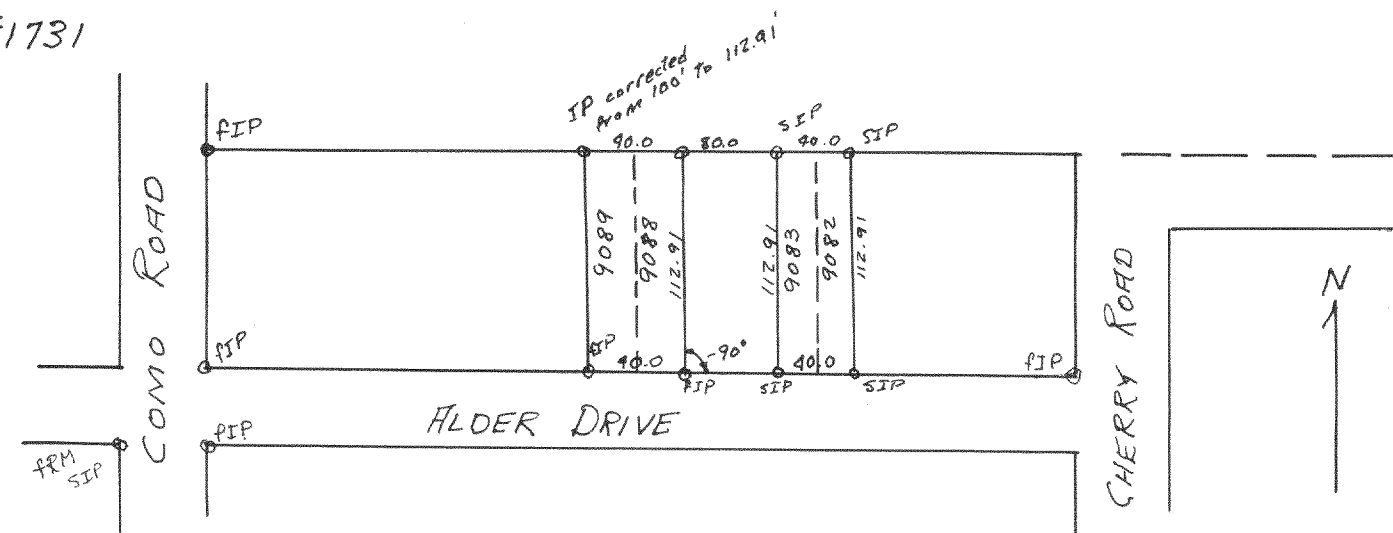

Plot of survey of Lots 9082-9083 of 4th map Lake Como Beach
Subdivision, Walworth County Wisconsin

1947


Lloyd E Jensen
County Surveyor
ES

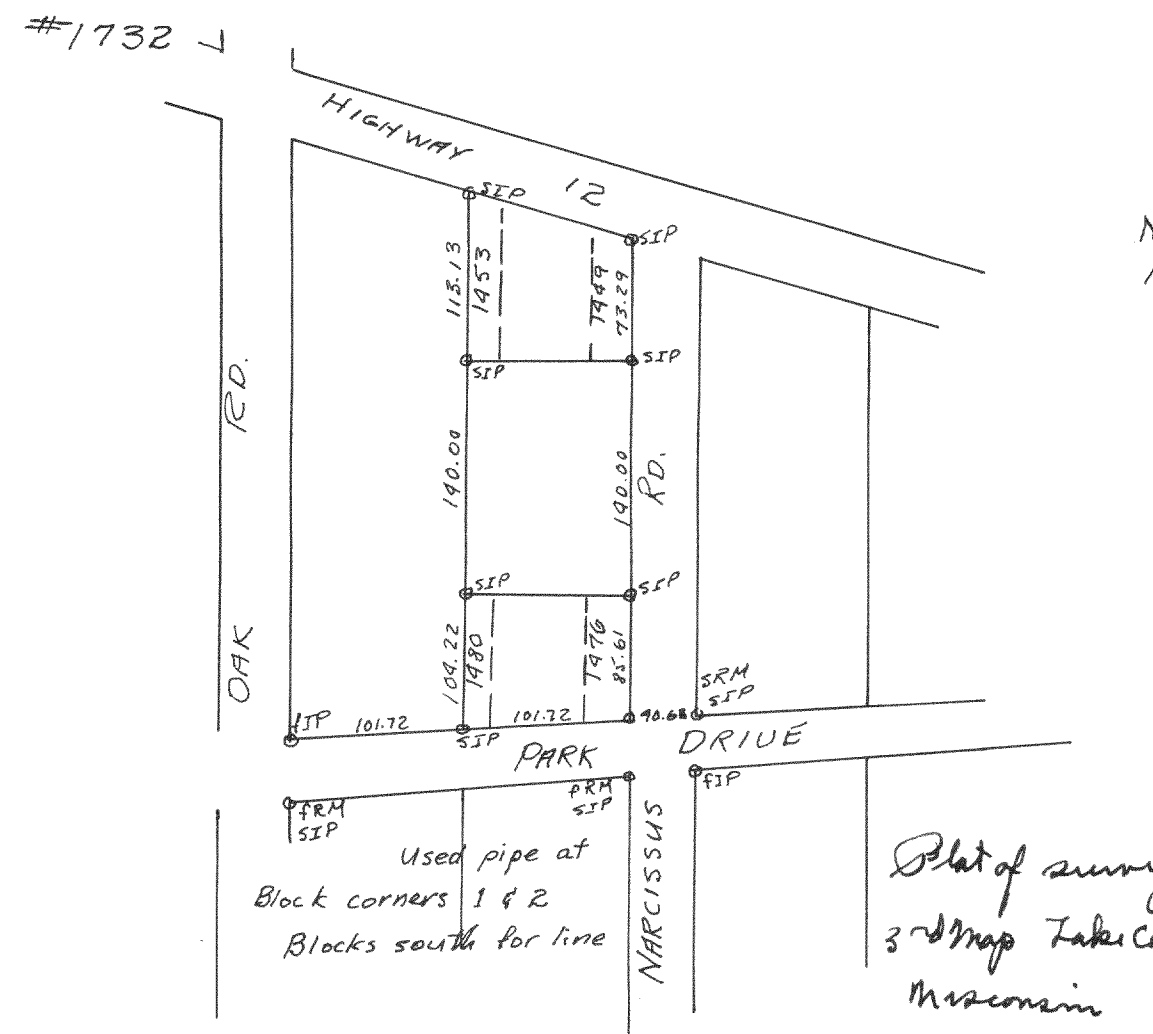

Plot of survey of lots 1449-1453, 1476-1480 of
3-S map Lake Como Beach subdivision, Walworth County,
Wisconsin

1947

Floyd S. Jensen
County Surveyor
125

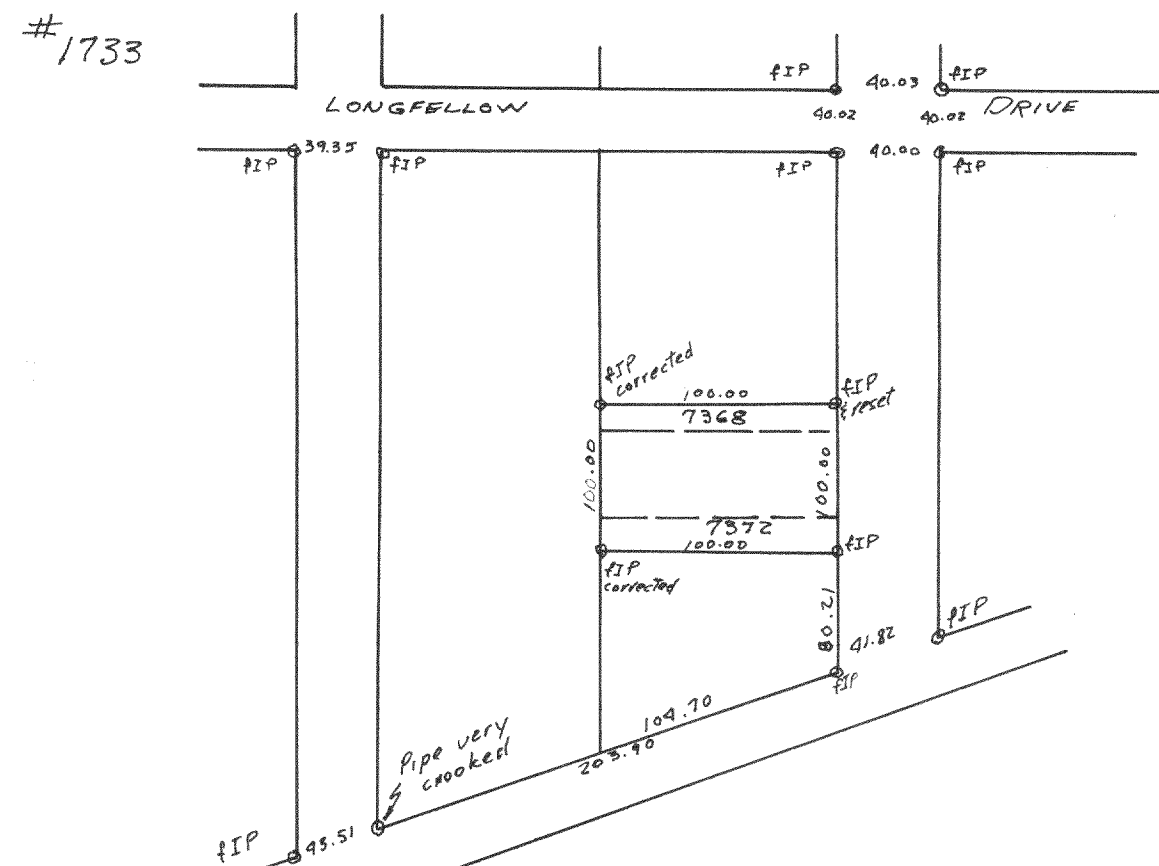


Plot of survey of lots 7368-7372 Lake Como Beach
subdivision Walworth County Wisconsin
April 17, 1977 Lloyd E Jensen

April 14, 1947

Lloyd & Jensen
County Surveyor
etc

1734

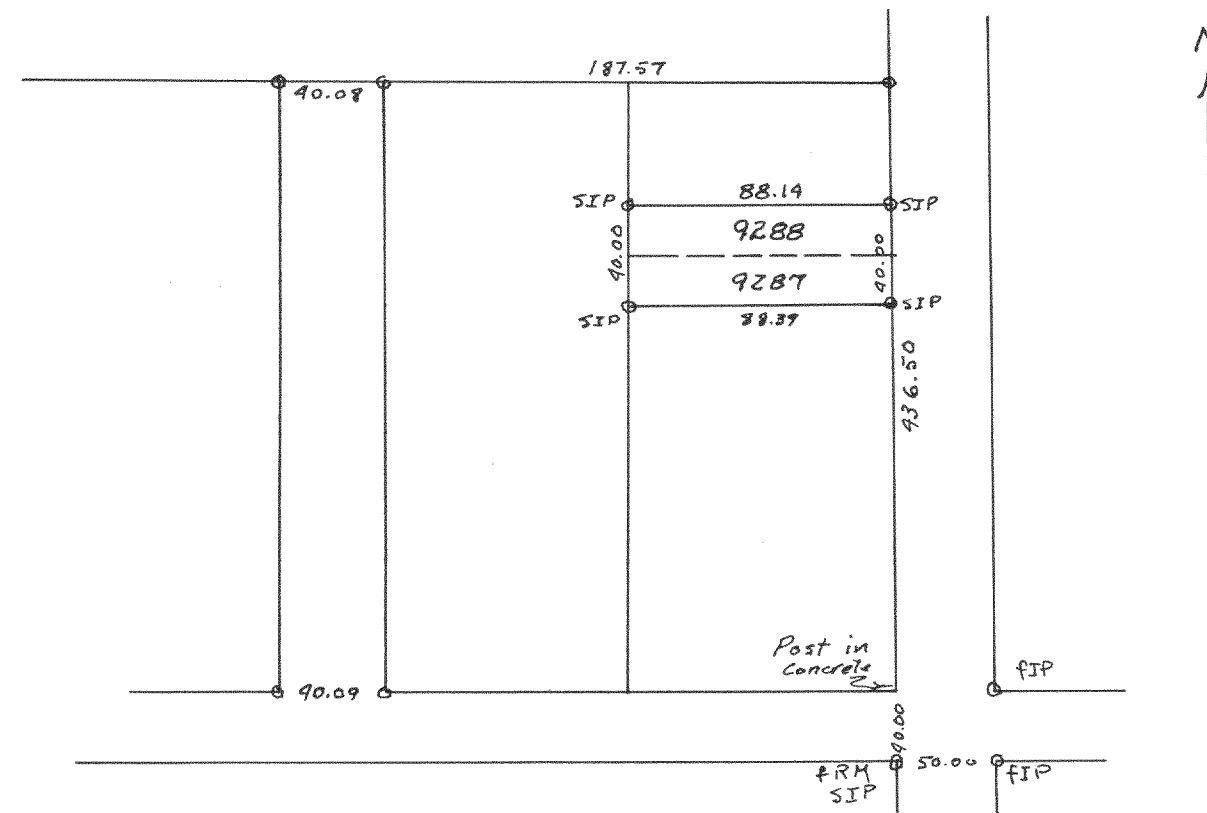

Lots 9287-9288 Lake Como Beach Subdivision in
Walworth County Wisconsin
April 14, 1947 Lloyd L Jensen

april 14, 1947

Lloyd L Jensen
County Surveyor
ids