



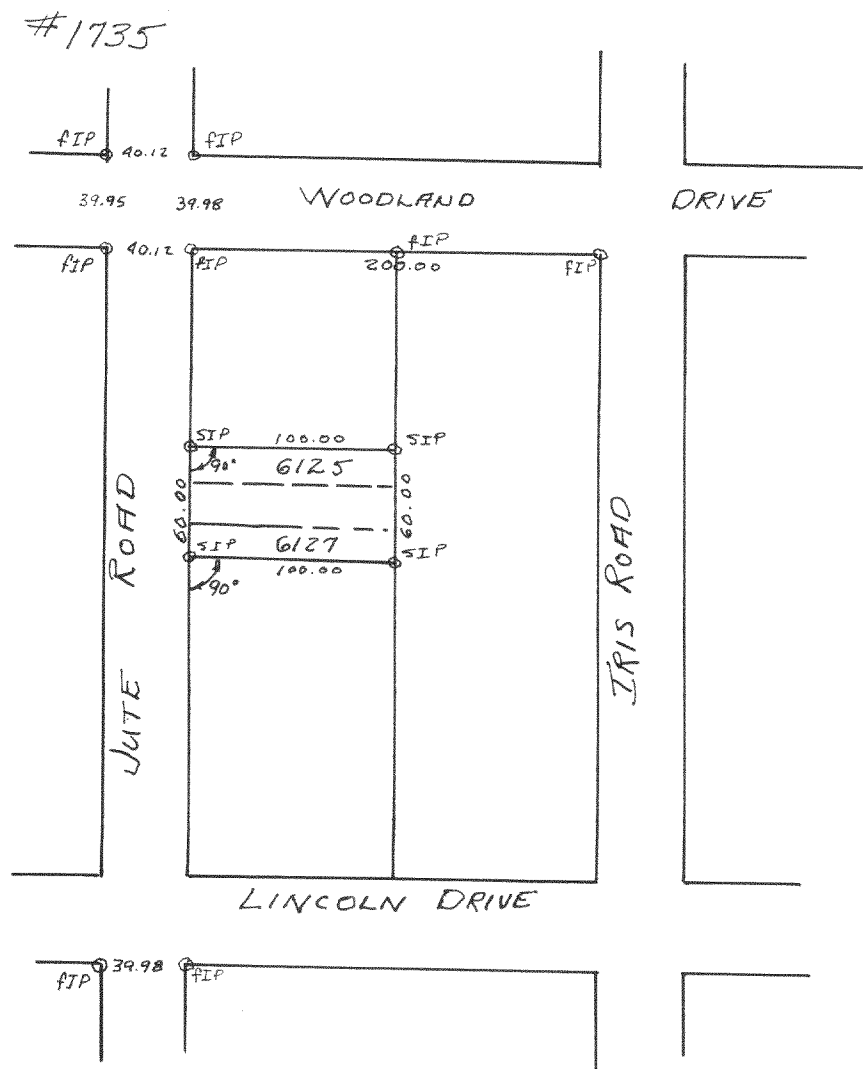

Plot of survey of lots 6125-6127 Lake Como Beach subdivision, Walworth County, Wisconsin

April 13, 1947


Lloyd S Jensen
County Surveyor
LSJ

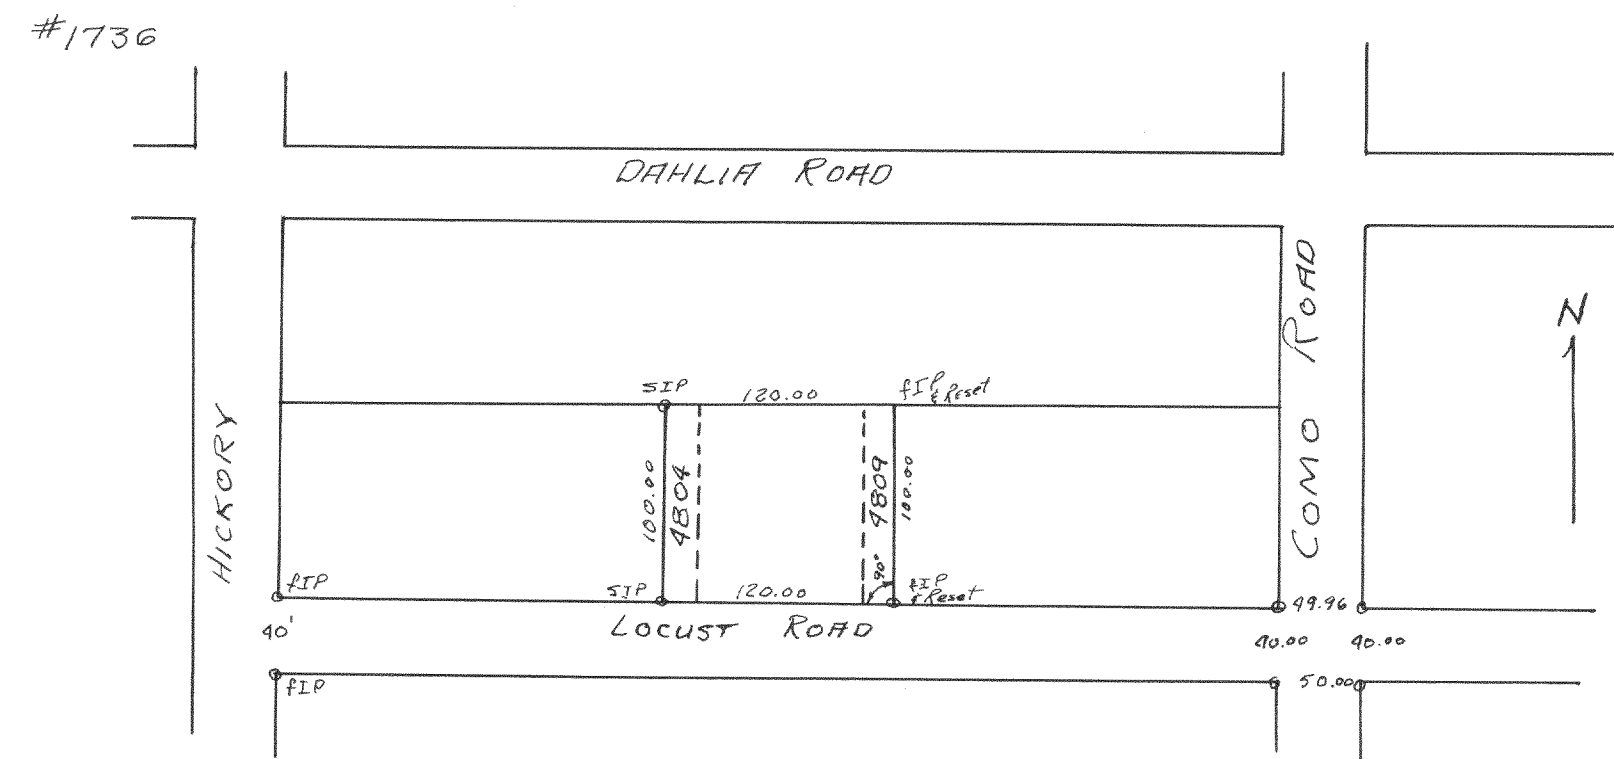

Plot of survey of lots 4804-4809 Lake Como Beach
Walworth County, Wisconsin
April 14, 1947

Lloyd S Jensen
County Surveyor
LSJ

#1737

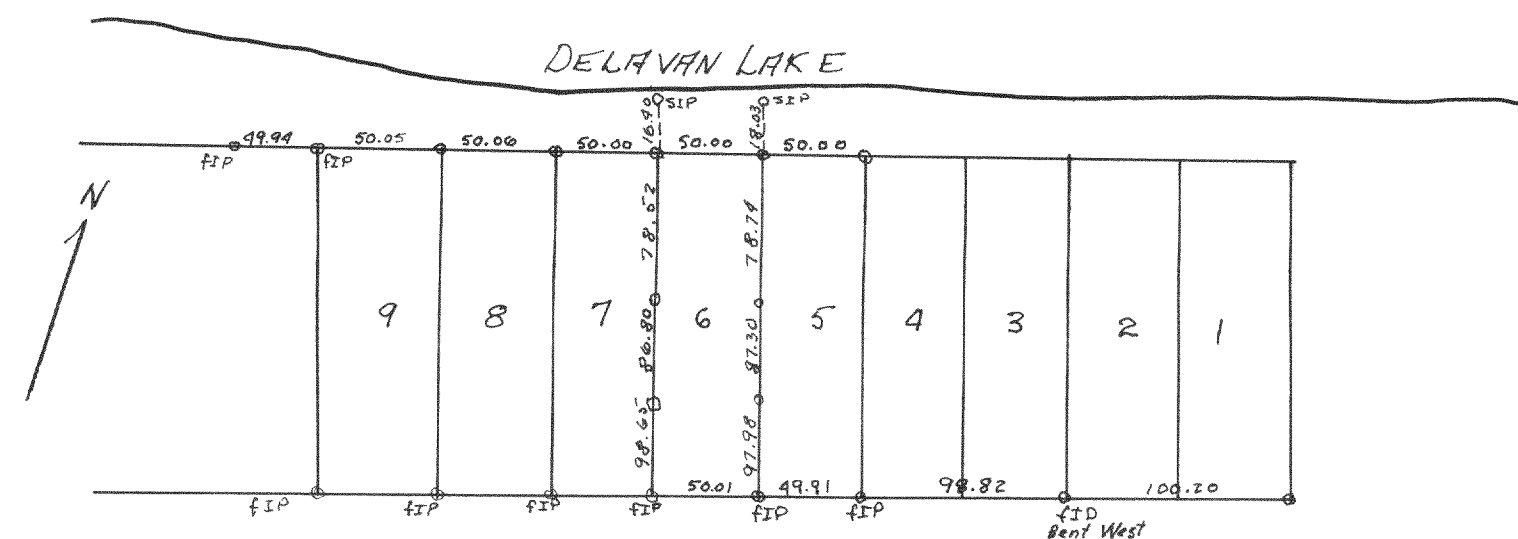

Plot of survey of Lot #6 of Government Lot #2 located in Section 32, T2N R16E
of Walworth County, Wisconsin

April 16, 1947

Lloyd S Jensen
County Surveyor
LSJ