


#1740

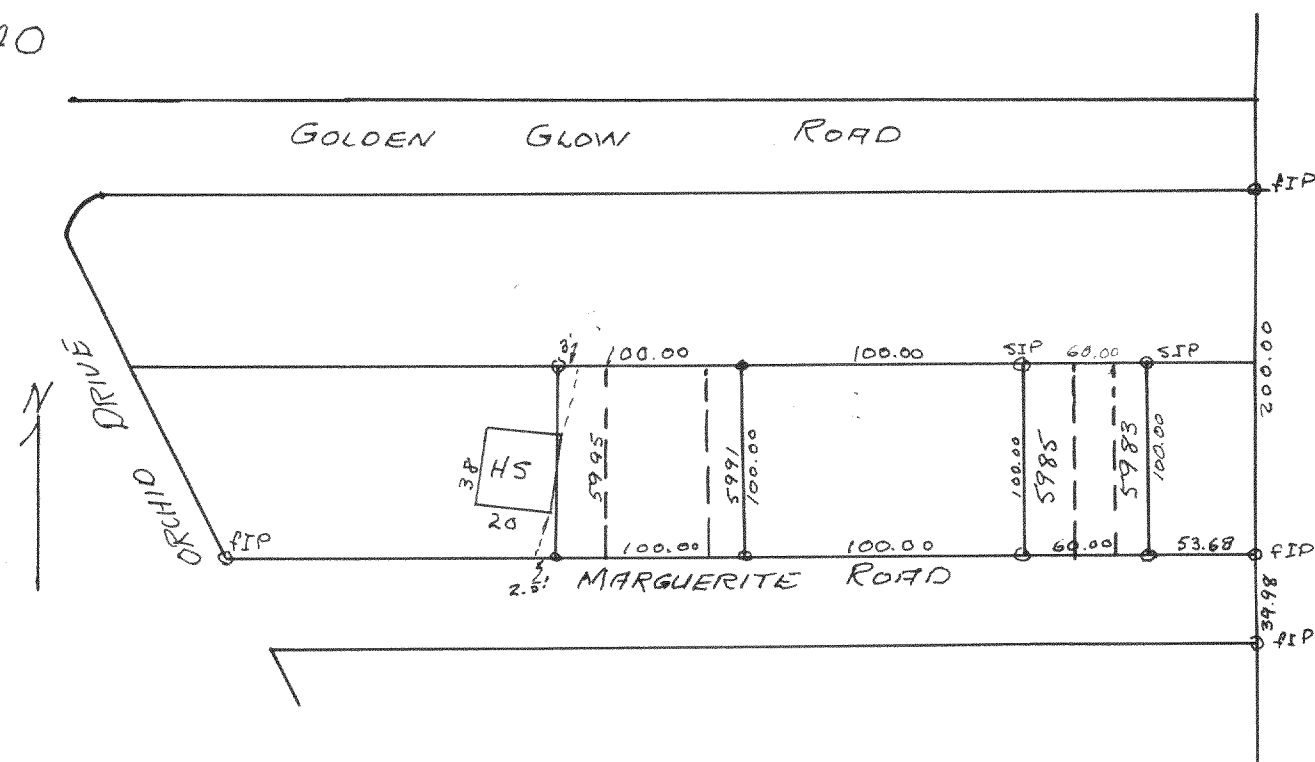


Plot of survey of lots 5982-5985, 5991-5995 in Bell Lake Subdivision Walworth County Wisconsin

April 26, 1947

Floyd S Jensen
County Surveyor
sds

#1741

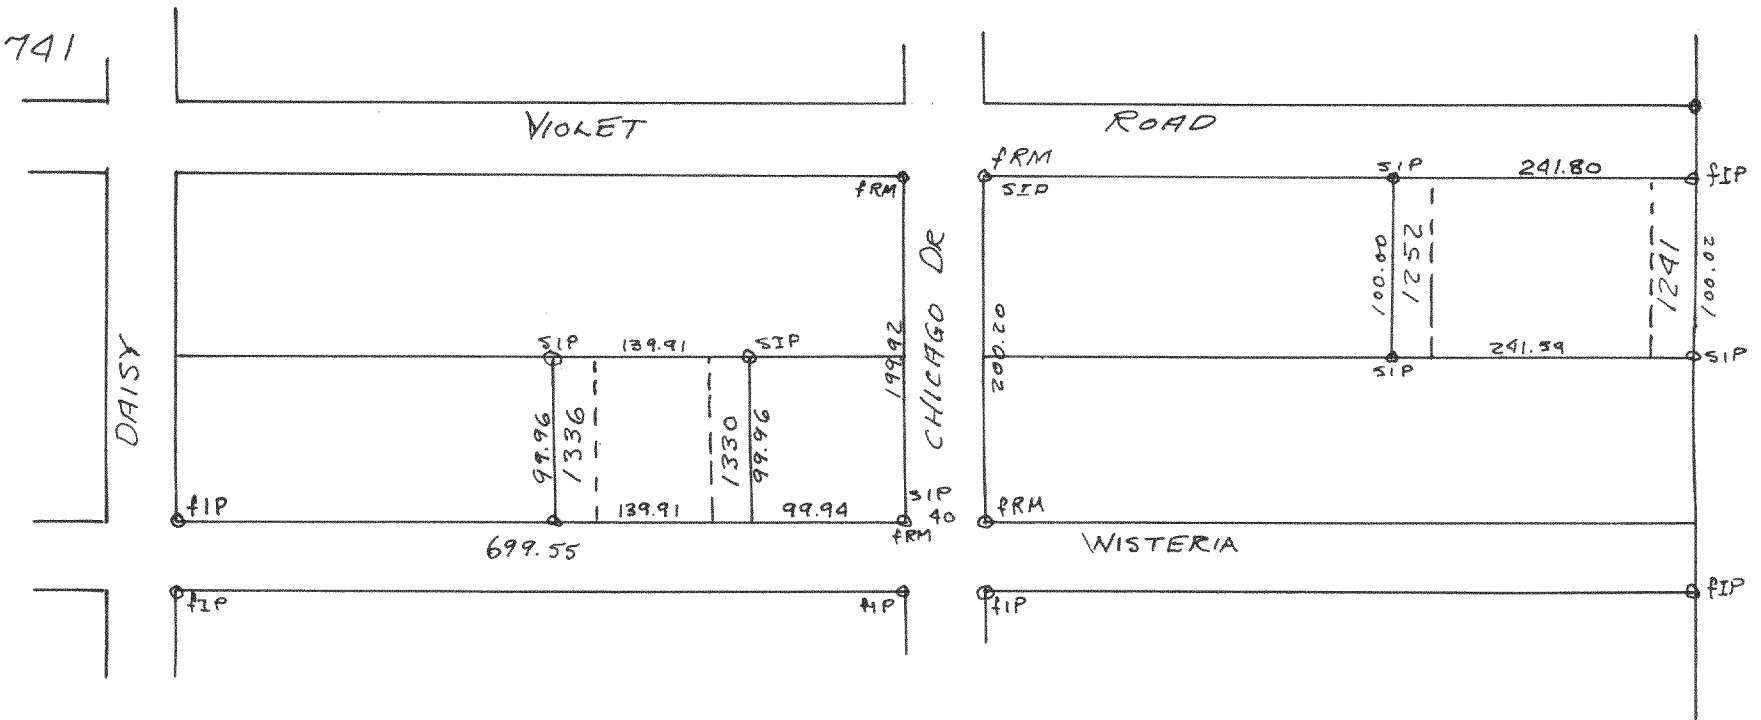


Plot of survey of lots 1291-1252, 1330-1336 Bell Lake Addition Walworth County Wisconsin

April 26, 1947

Floyd S Jensen
County Surveyor
sds

#1742

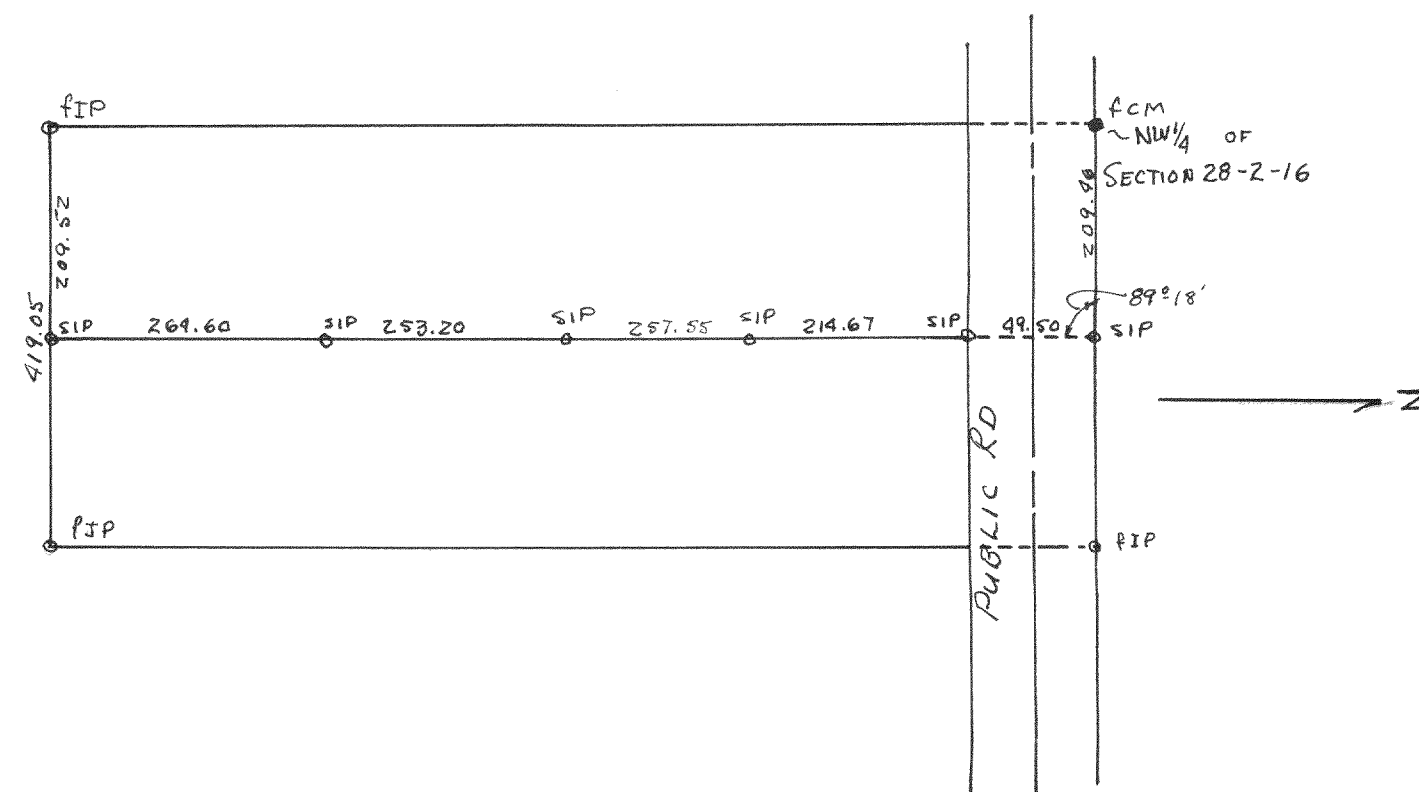


Plot of survey of east line of Halloway property located in the NW 1/4 of Section 29 T2N R16E of Walworth County Wisconsin

1947

Floyd S Jensen
County Surveyor
sds

#1743

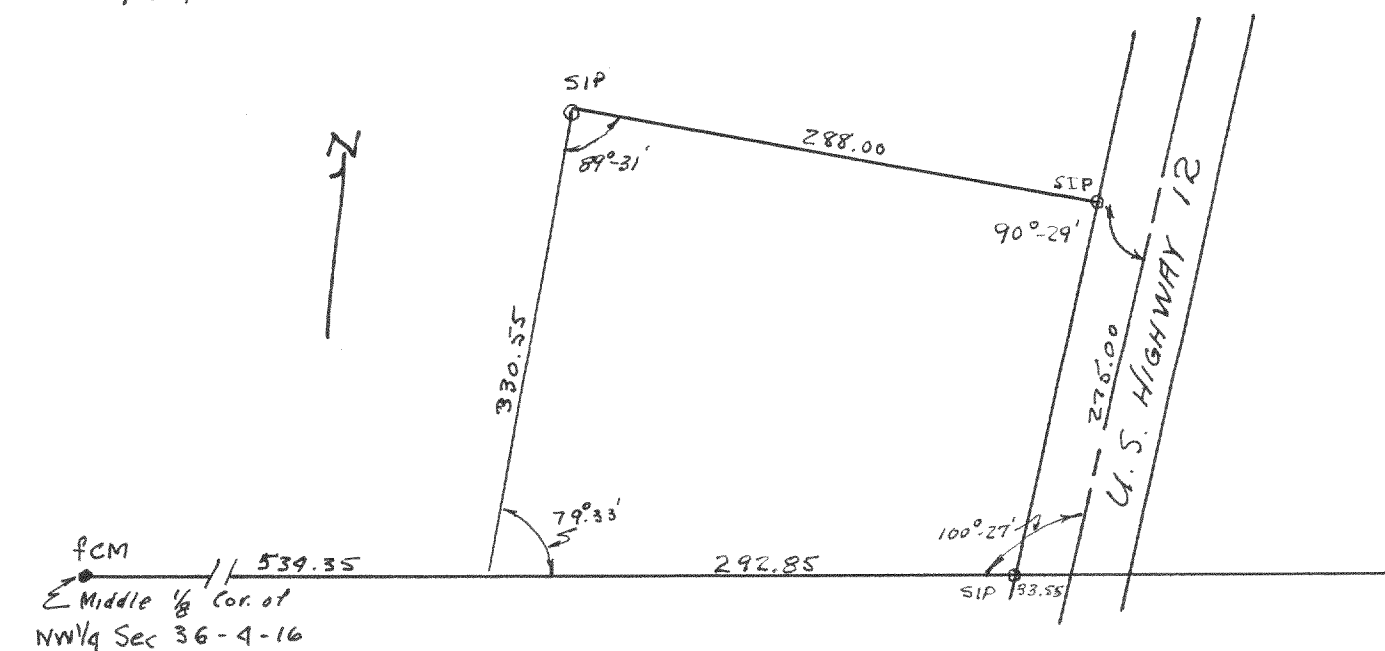

Plot of survey of parcel of land on the Swanson Farm Sandeshul Lake located in the NW 1/4 of Section 36 T4N R16E of Walworth County Wisconsin

May 15, 1947

Floyd S Jensen
County Surveyor
sds