


#1746

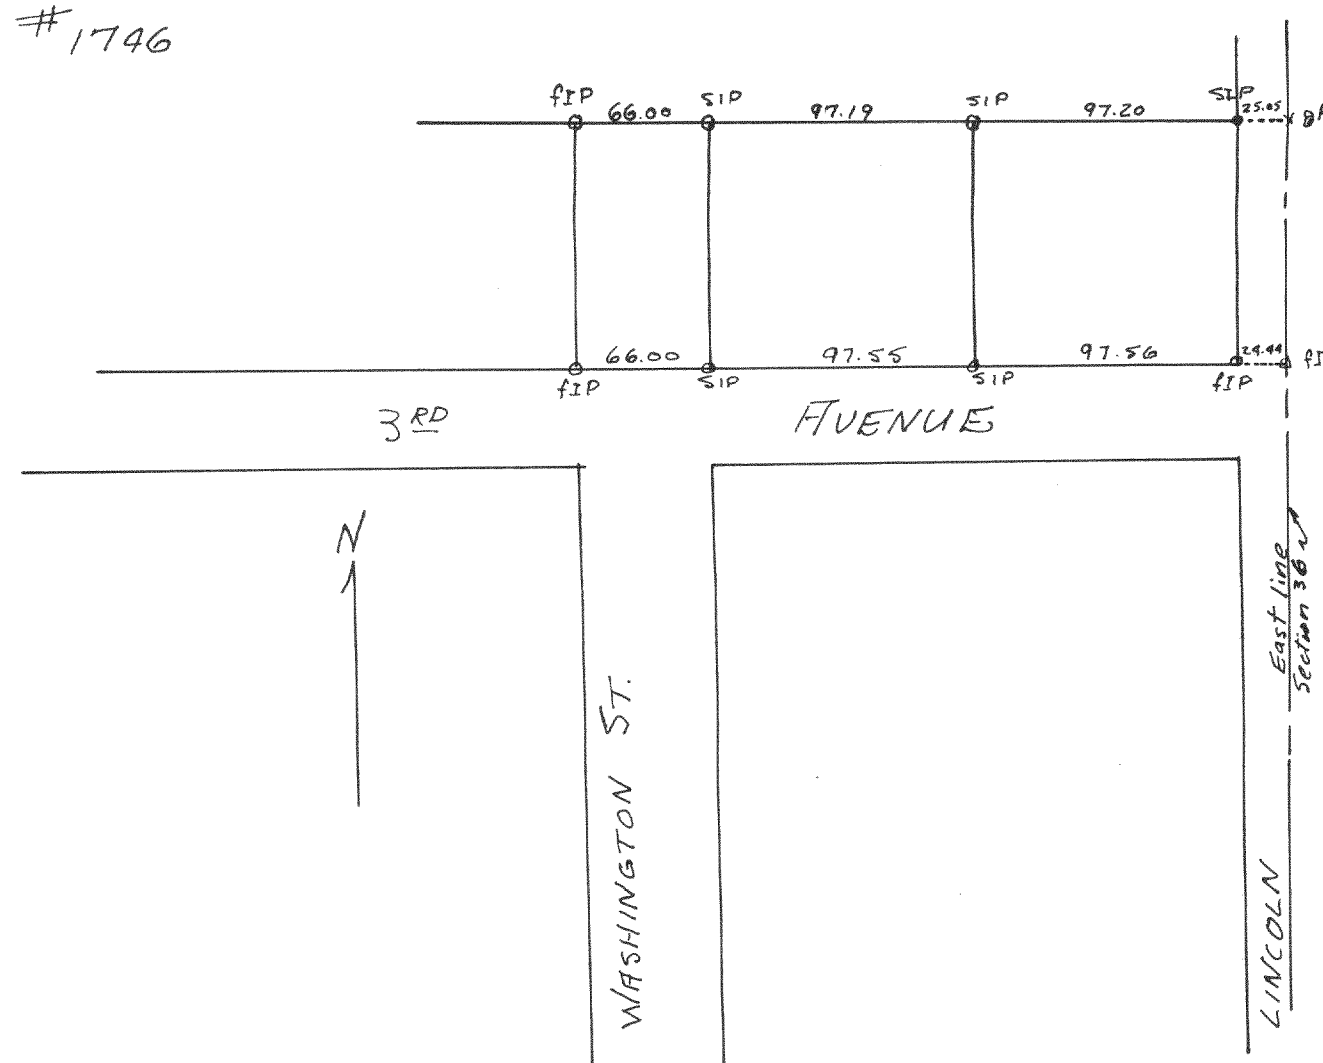


Plot of survey of Campbell property located in the
City of Elkhorn, Malworth County, Wisconsin

May 21, 1947

Lloyd S Jensen
County Surveyor
[Signature]

#1747

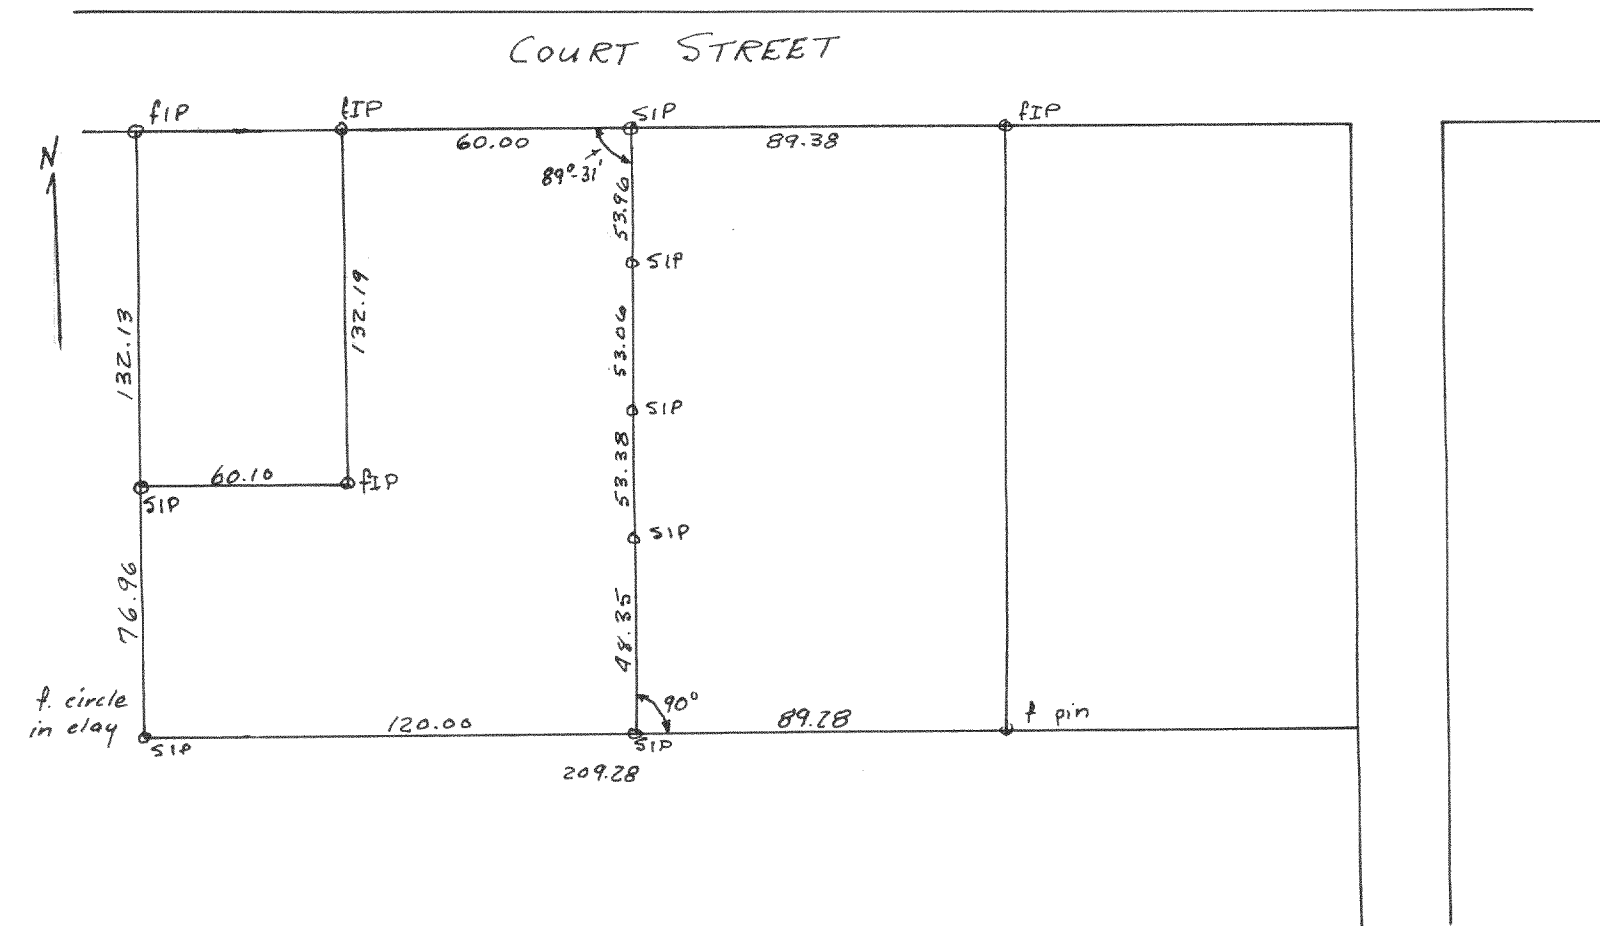

Plot of survey of parcel of land sold to Williams by Tubbs
located in the City of Elkhorn, Malworth County, Wisconsin

May 22, 1947

Lloyd S Jensen
County Surveyor
[Signature]