


1754

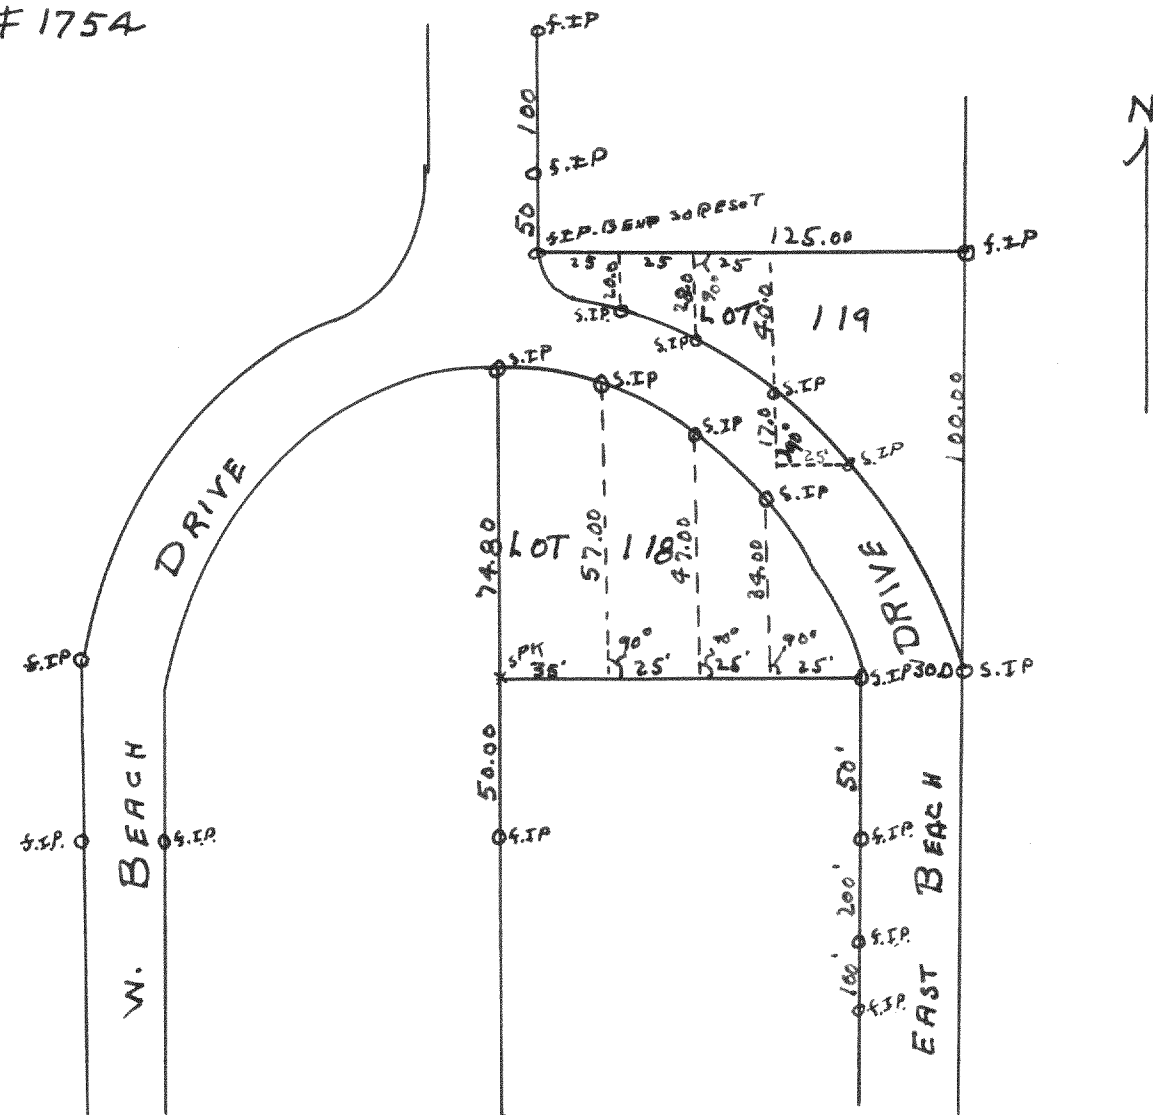


Plot of Road survey on curve between Lots 18 and 19 in
Lake Geneva Beach Subdivision Walworth County Wisconsin

July 5, 1947

Floyd S. Jensen
County Surveyor
[Signature]

1755

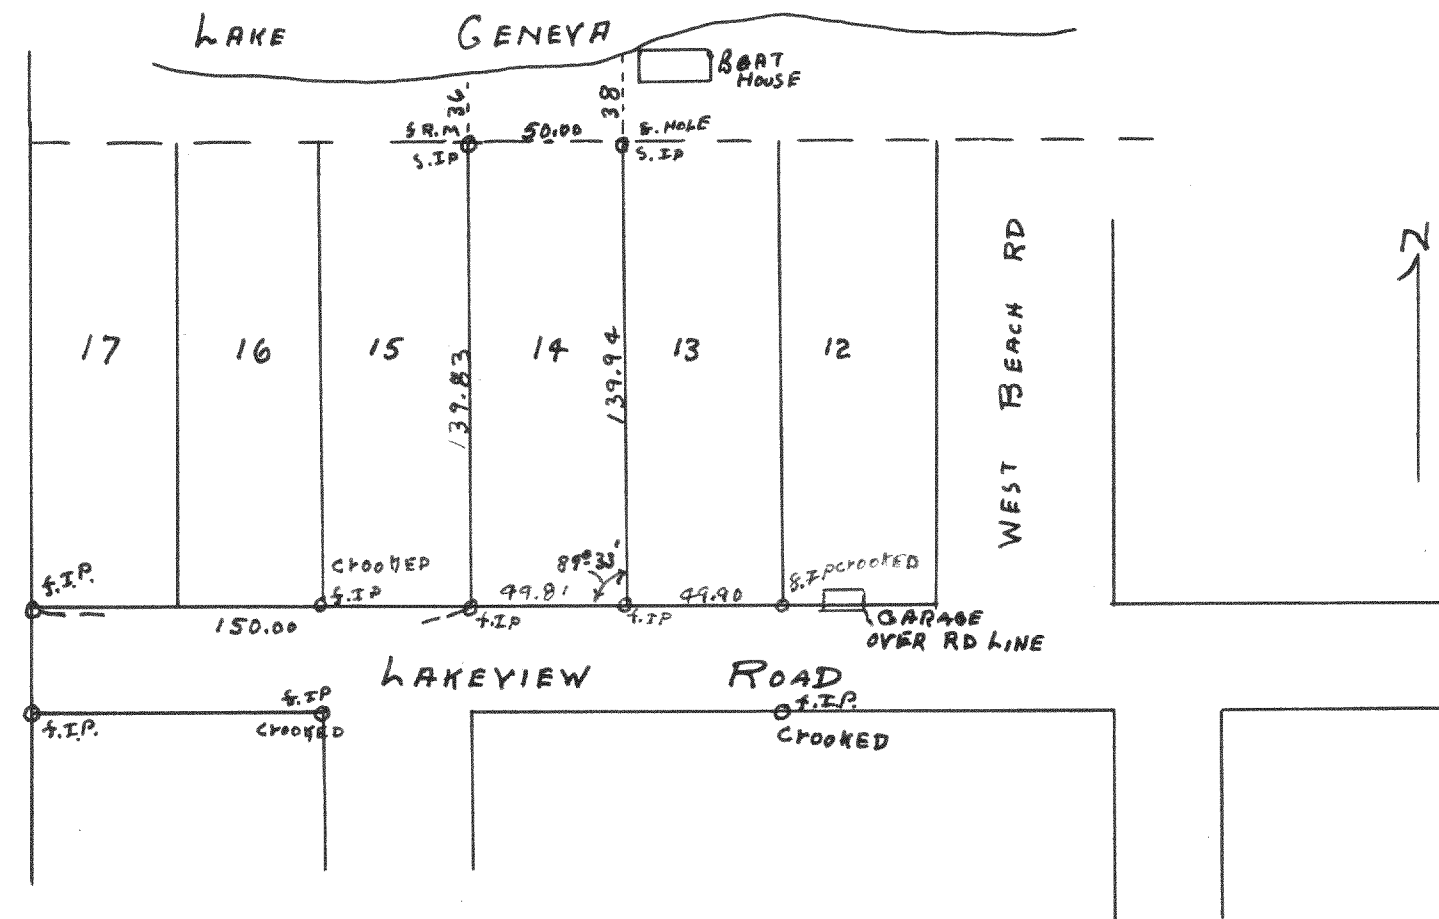

Plot of survey of Lot 14 Lake Geneva Highlands Walworth
County Wisconsin

July 24, 1947

Floyd S. Jensen
County Surveyor
[Signature]