


#1756

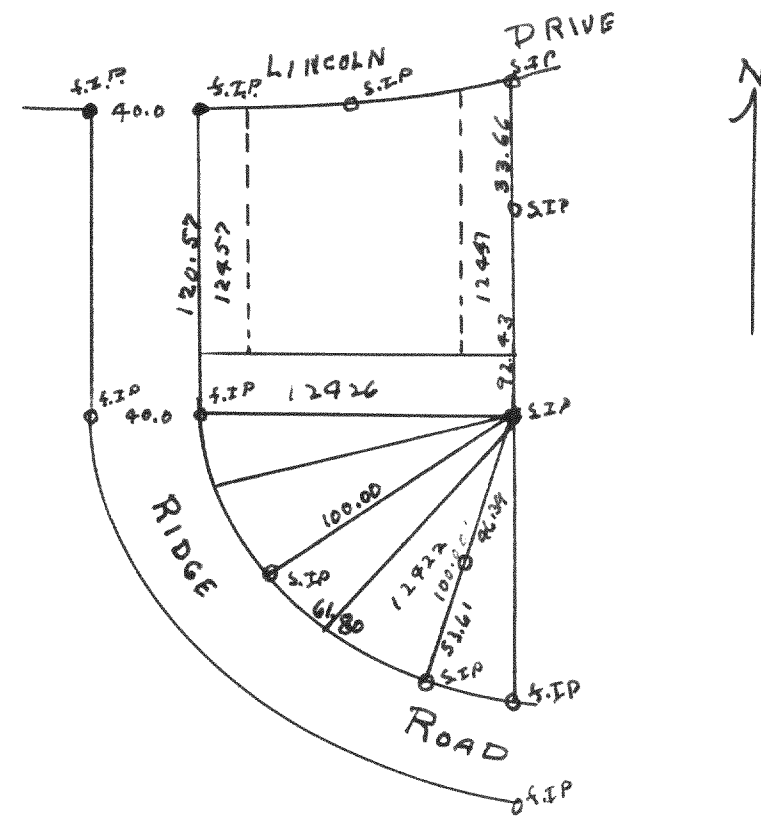


Plot of survey of Lots 12922-12924, 12947-12951
Lake Como Beach subdivision, Walworth County, Wis.

July 24, 1997

Lloyd S Jensen
County Surveyor
L.S.J.

#1757

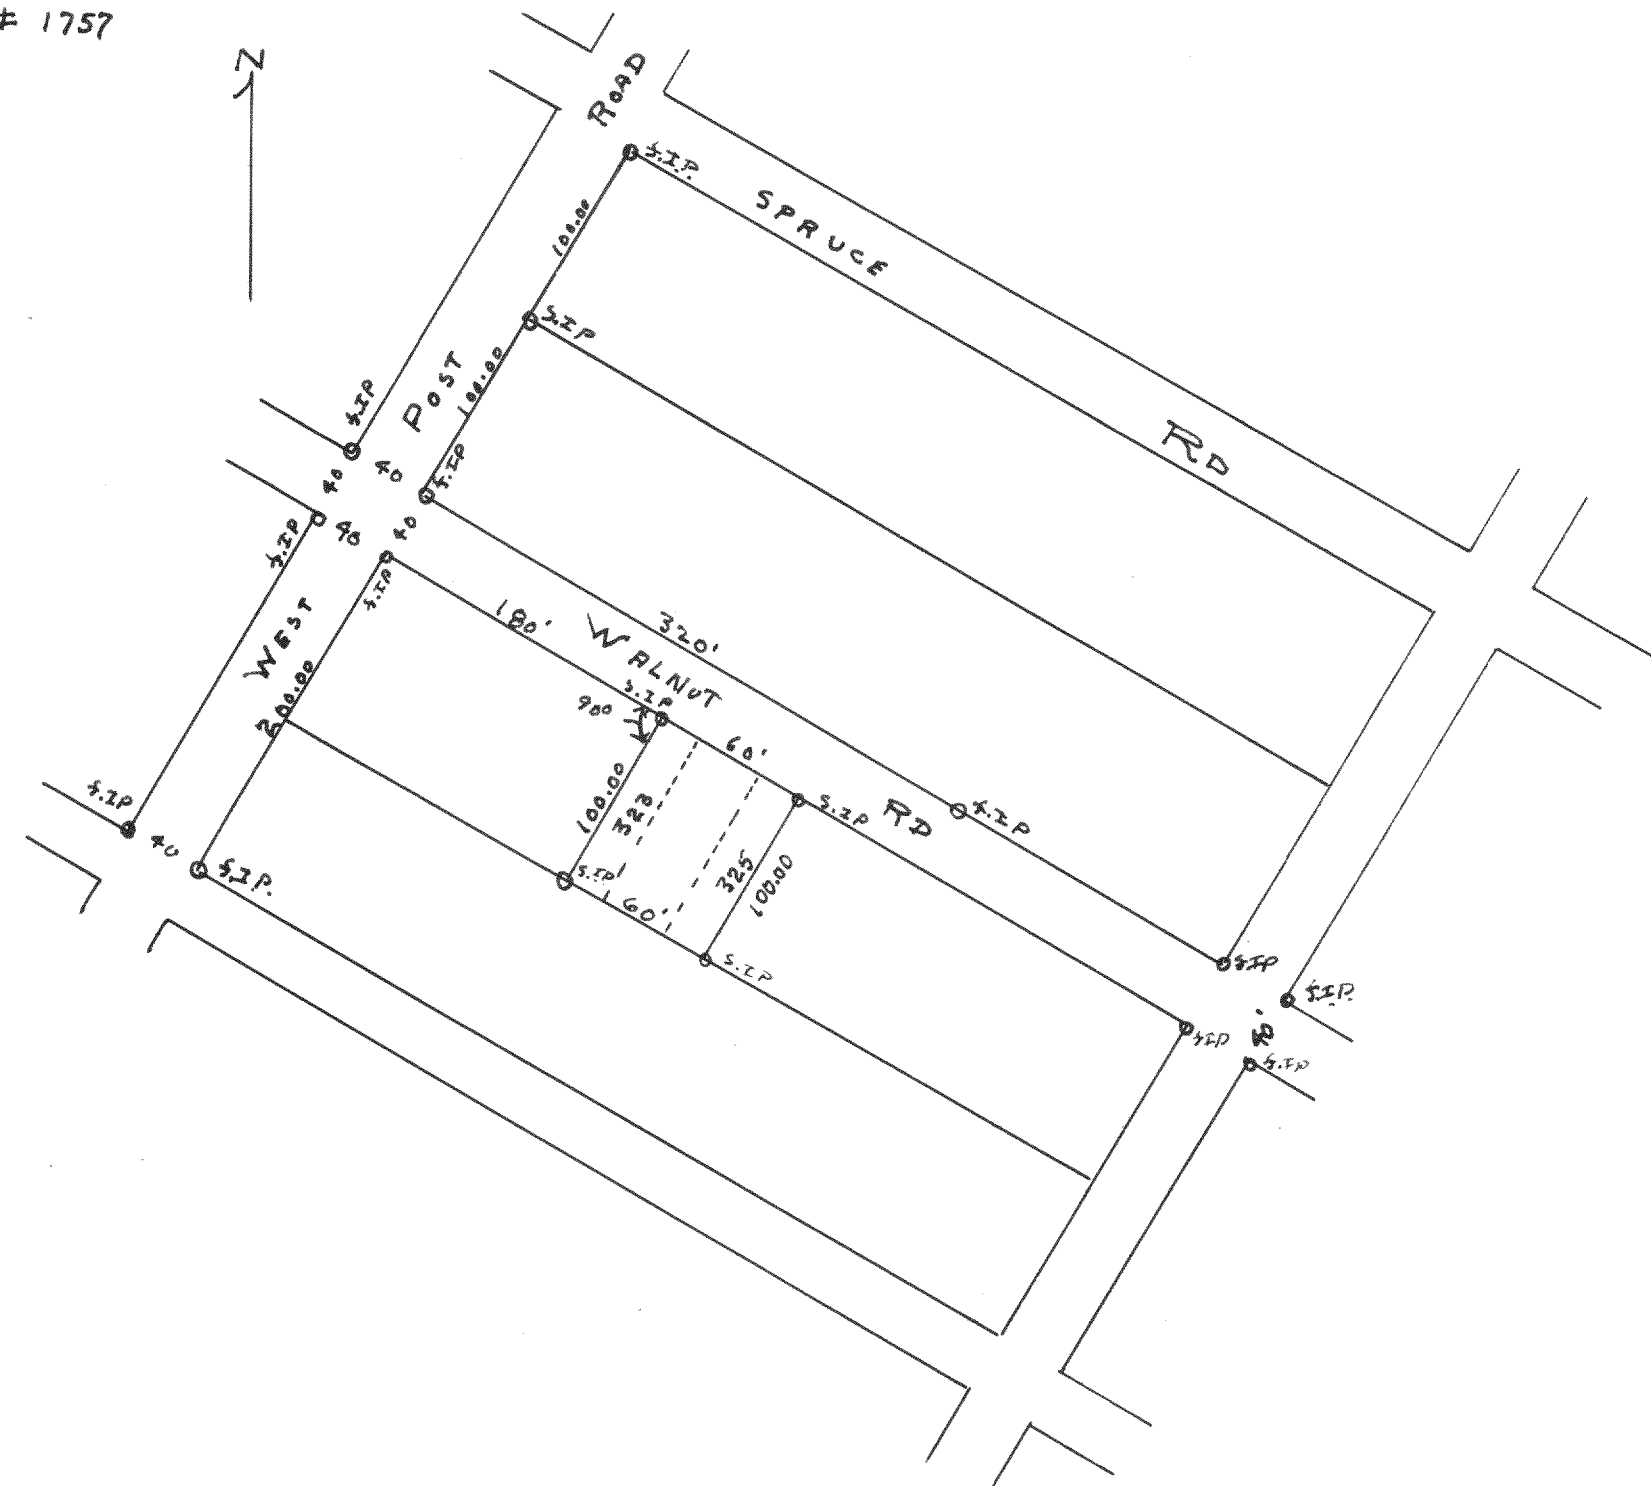

Plot of survey of Lots 323-325 Section I Bell Lake
Walworth County, Wisconsin

July 28, 1997

Lloyd S Jensen
County Surveyor
L.S.J.