


1758

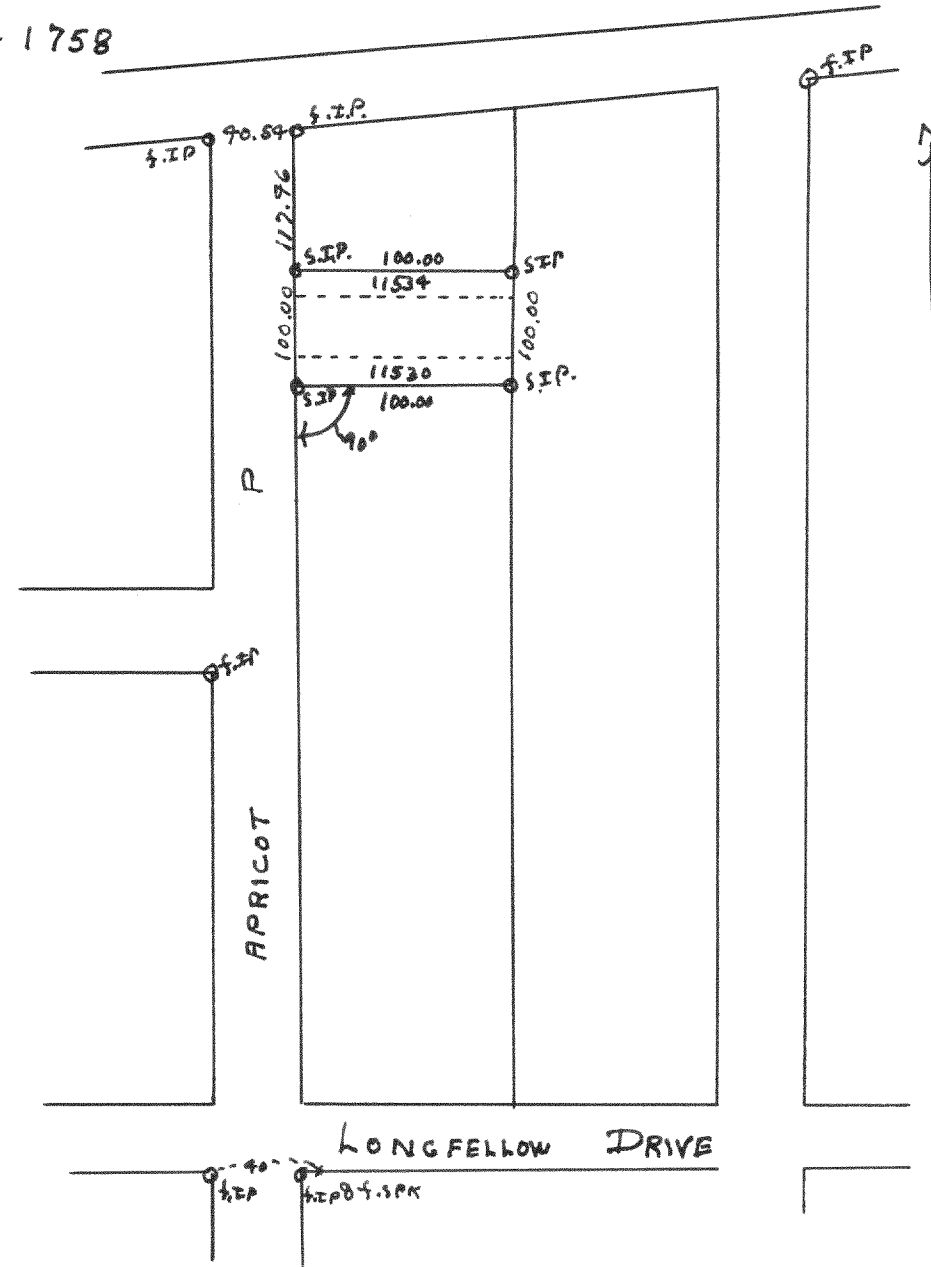


Plot of survey of lots 11530-11534 Lake Como Beach,
Walworth County, Wisconsin

July 30, 1947

Floyd S. Jensen
County Surveyor
[Signature]

1759

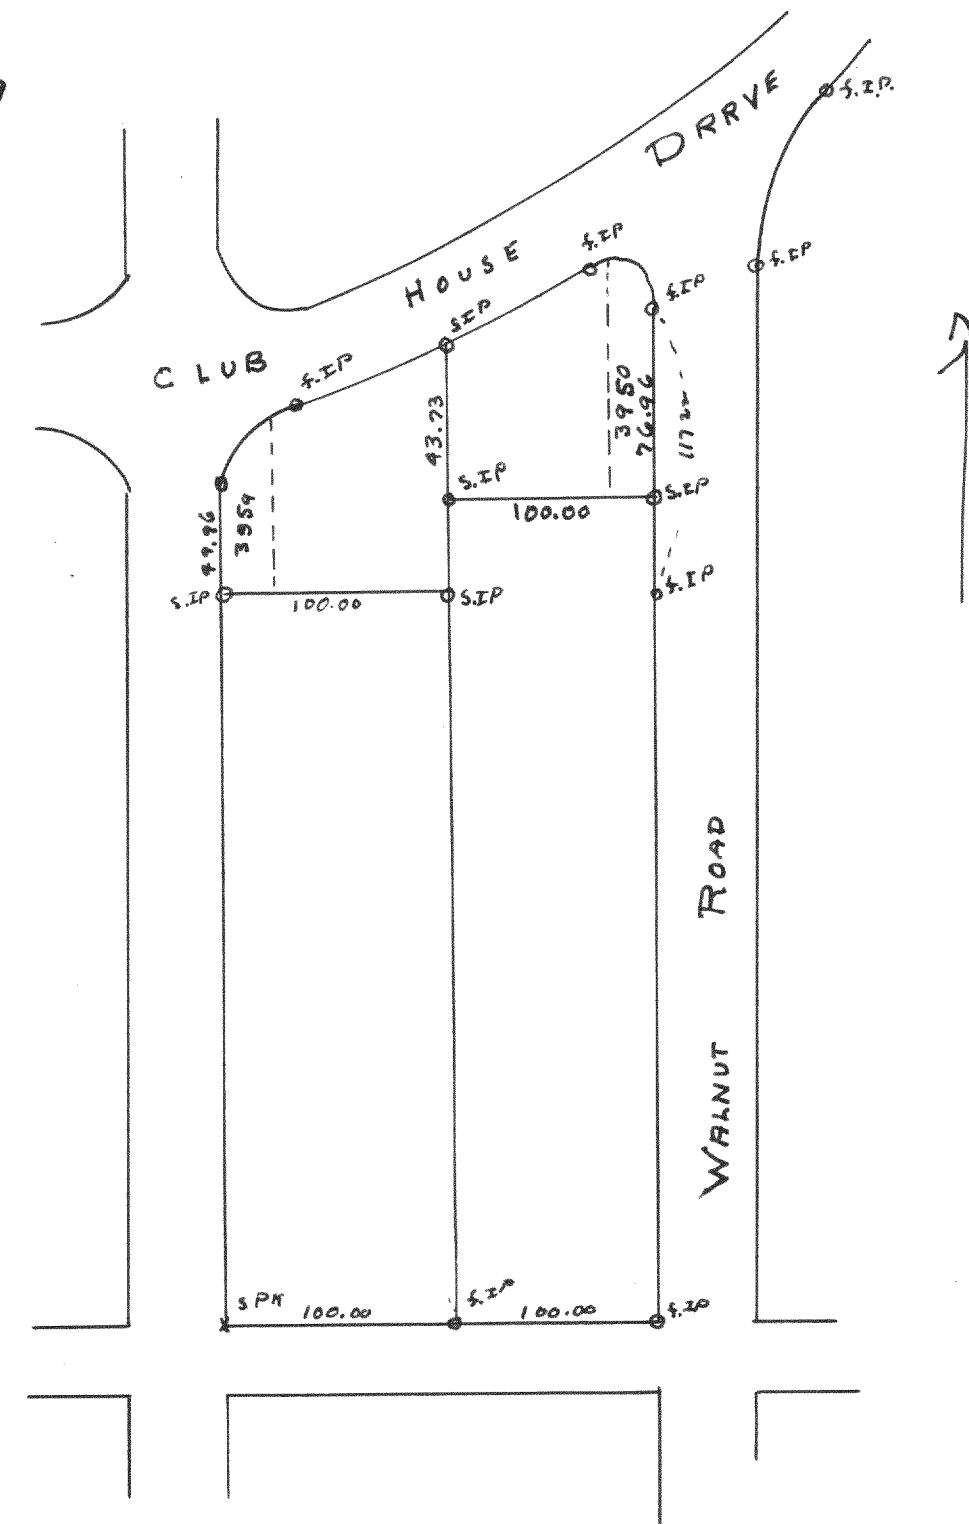

Plot of survey of lots 3950-3959 Lake Como Beach
Walworth County, Wisconsin

July 30, 1947

Floyd S. Jensen
County Surveyor
[Signature]