


#1760

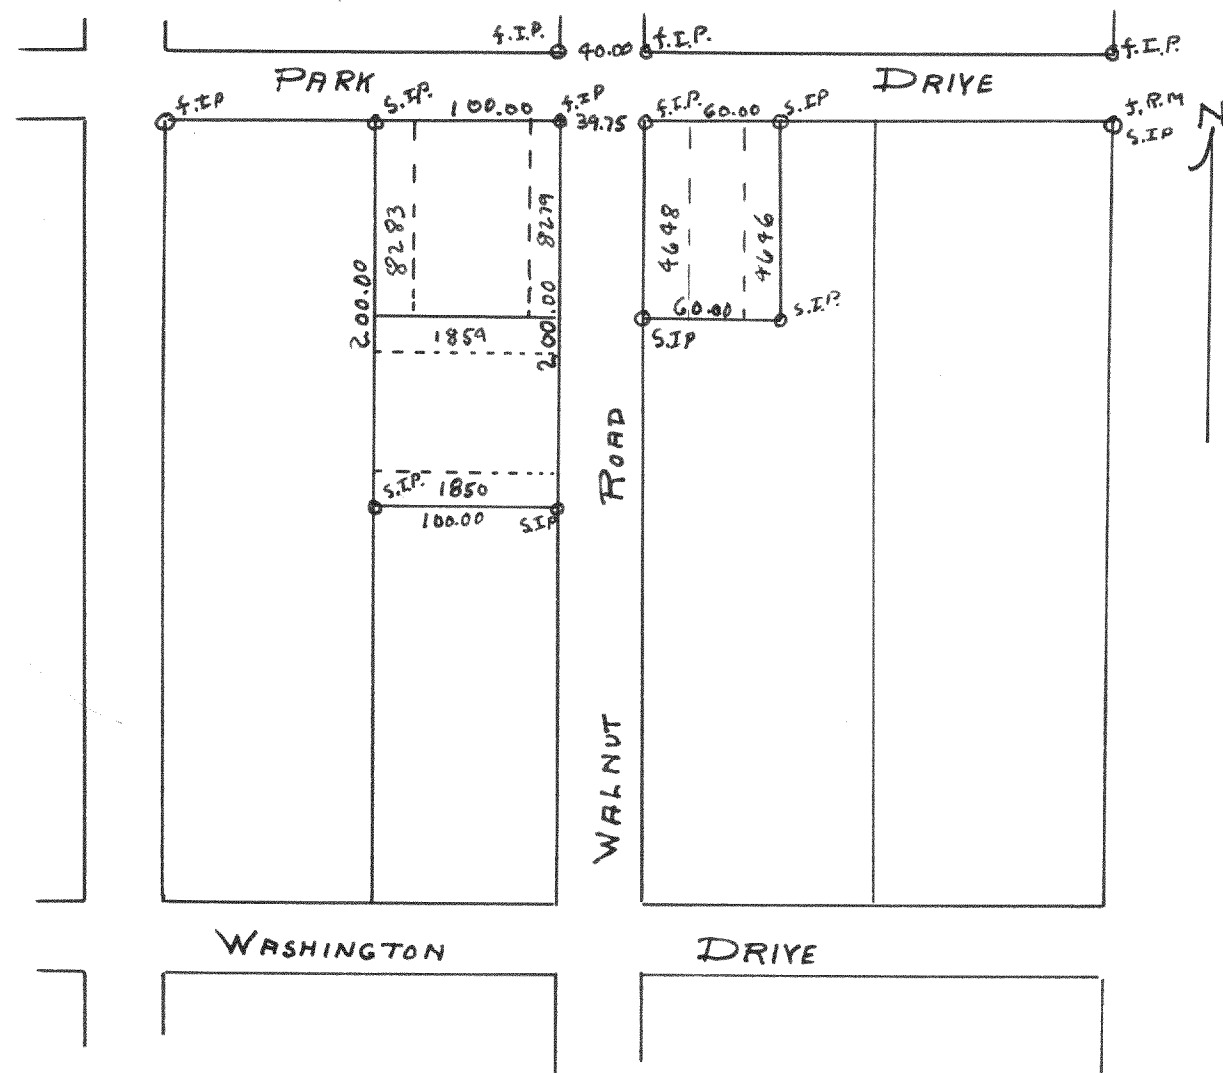


Plot of survey of lots 8250-8259, 8279-8283, 4646-4648
Lake Como Beach Walworth County Wisconsin

Aug 1, 1947

Lloyd S. Jensen
County Surveyor
SD

#1761

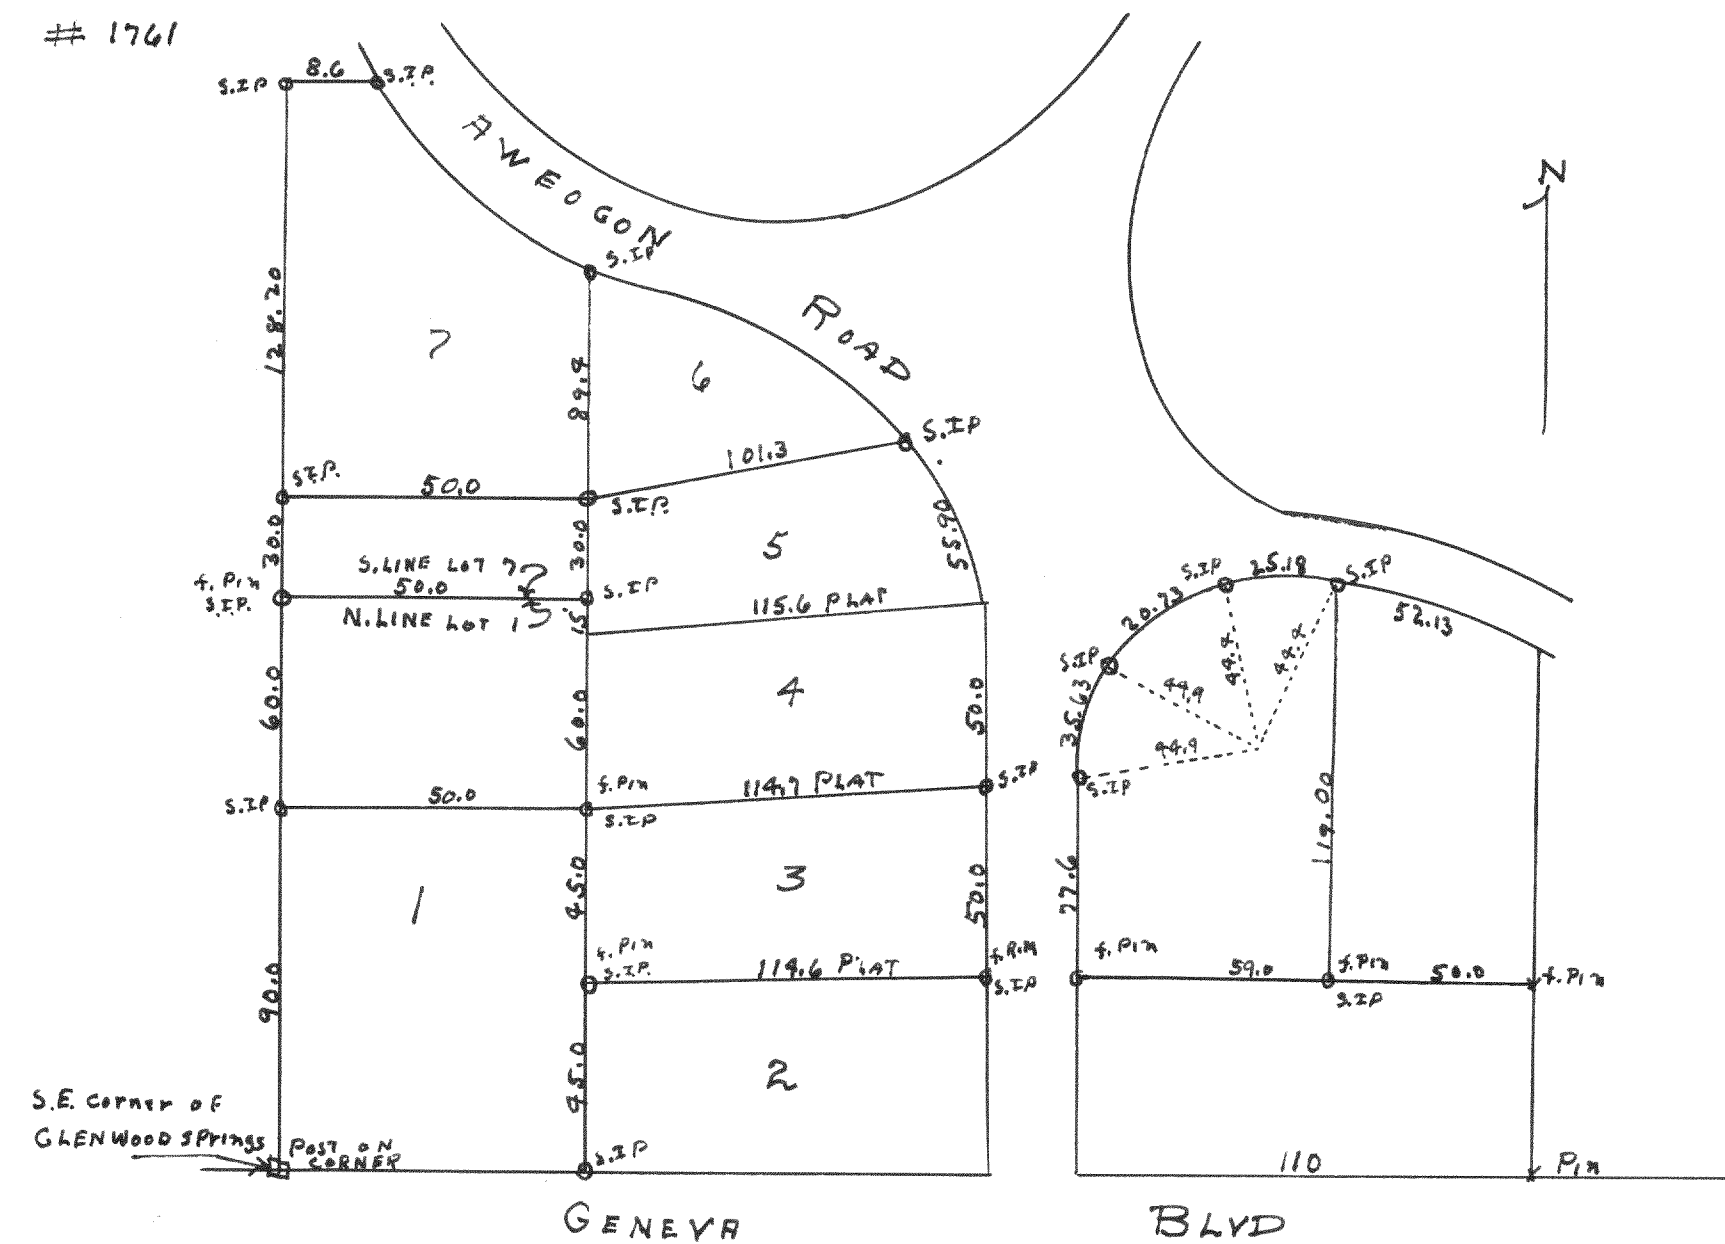

Plot of survey of lots 1, 4, 5, 7 Block 1 and lot 1 of Block 4
Indian Hills Subdivision, Fortuna, Walworth County Wisconsin

Aug. 1947

Lloyd S. Jensen
County Surveyor
SD