


#1764

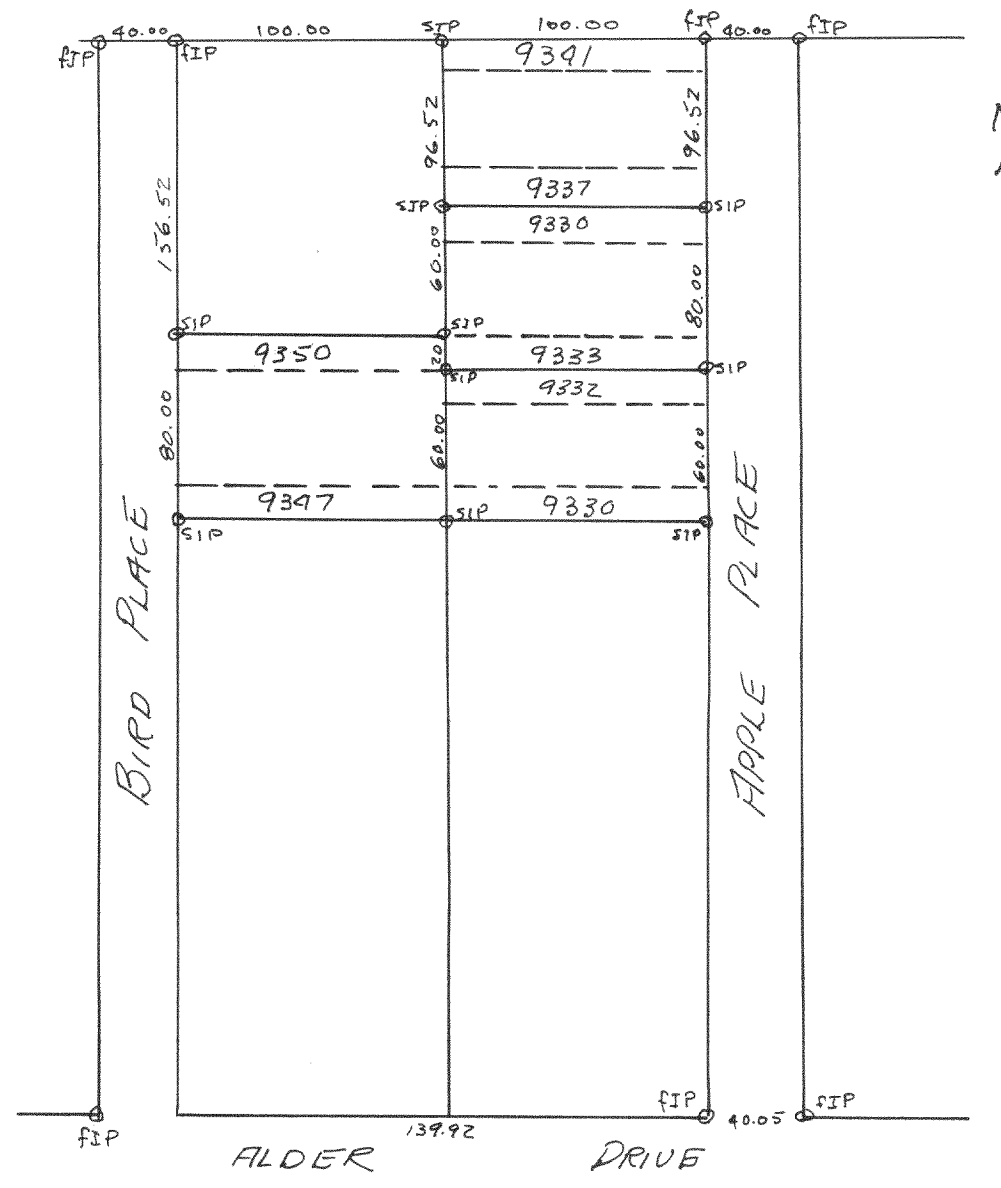


Plot of survey of lots 9347-9350, 9330, 9332, 9333-9336, and 9337-9341
in Lake Como Beach Subdivision, Walworth County, Wisconsin

Aug 22, 1947

Floyd S Jensen
County Surveyor
FSD

#1765

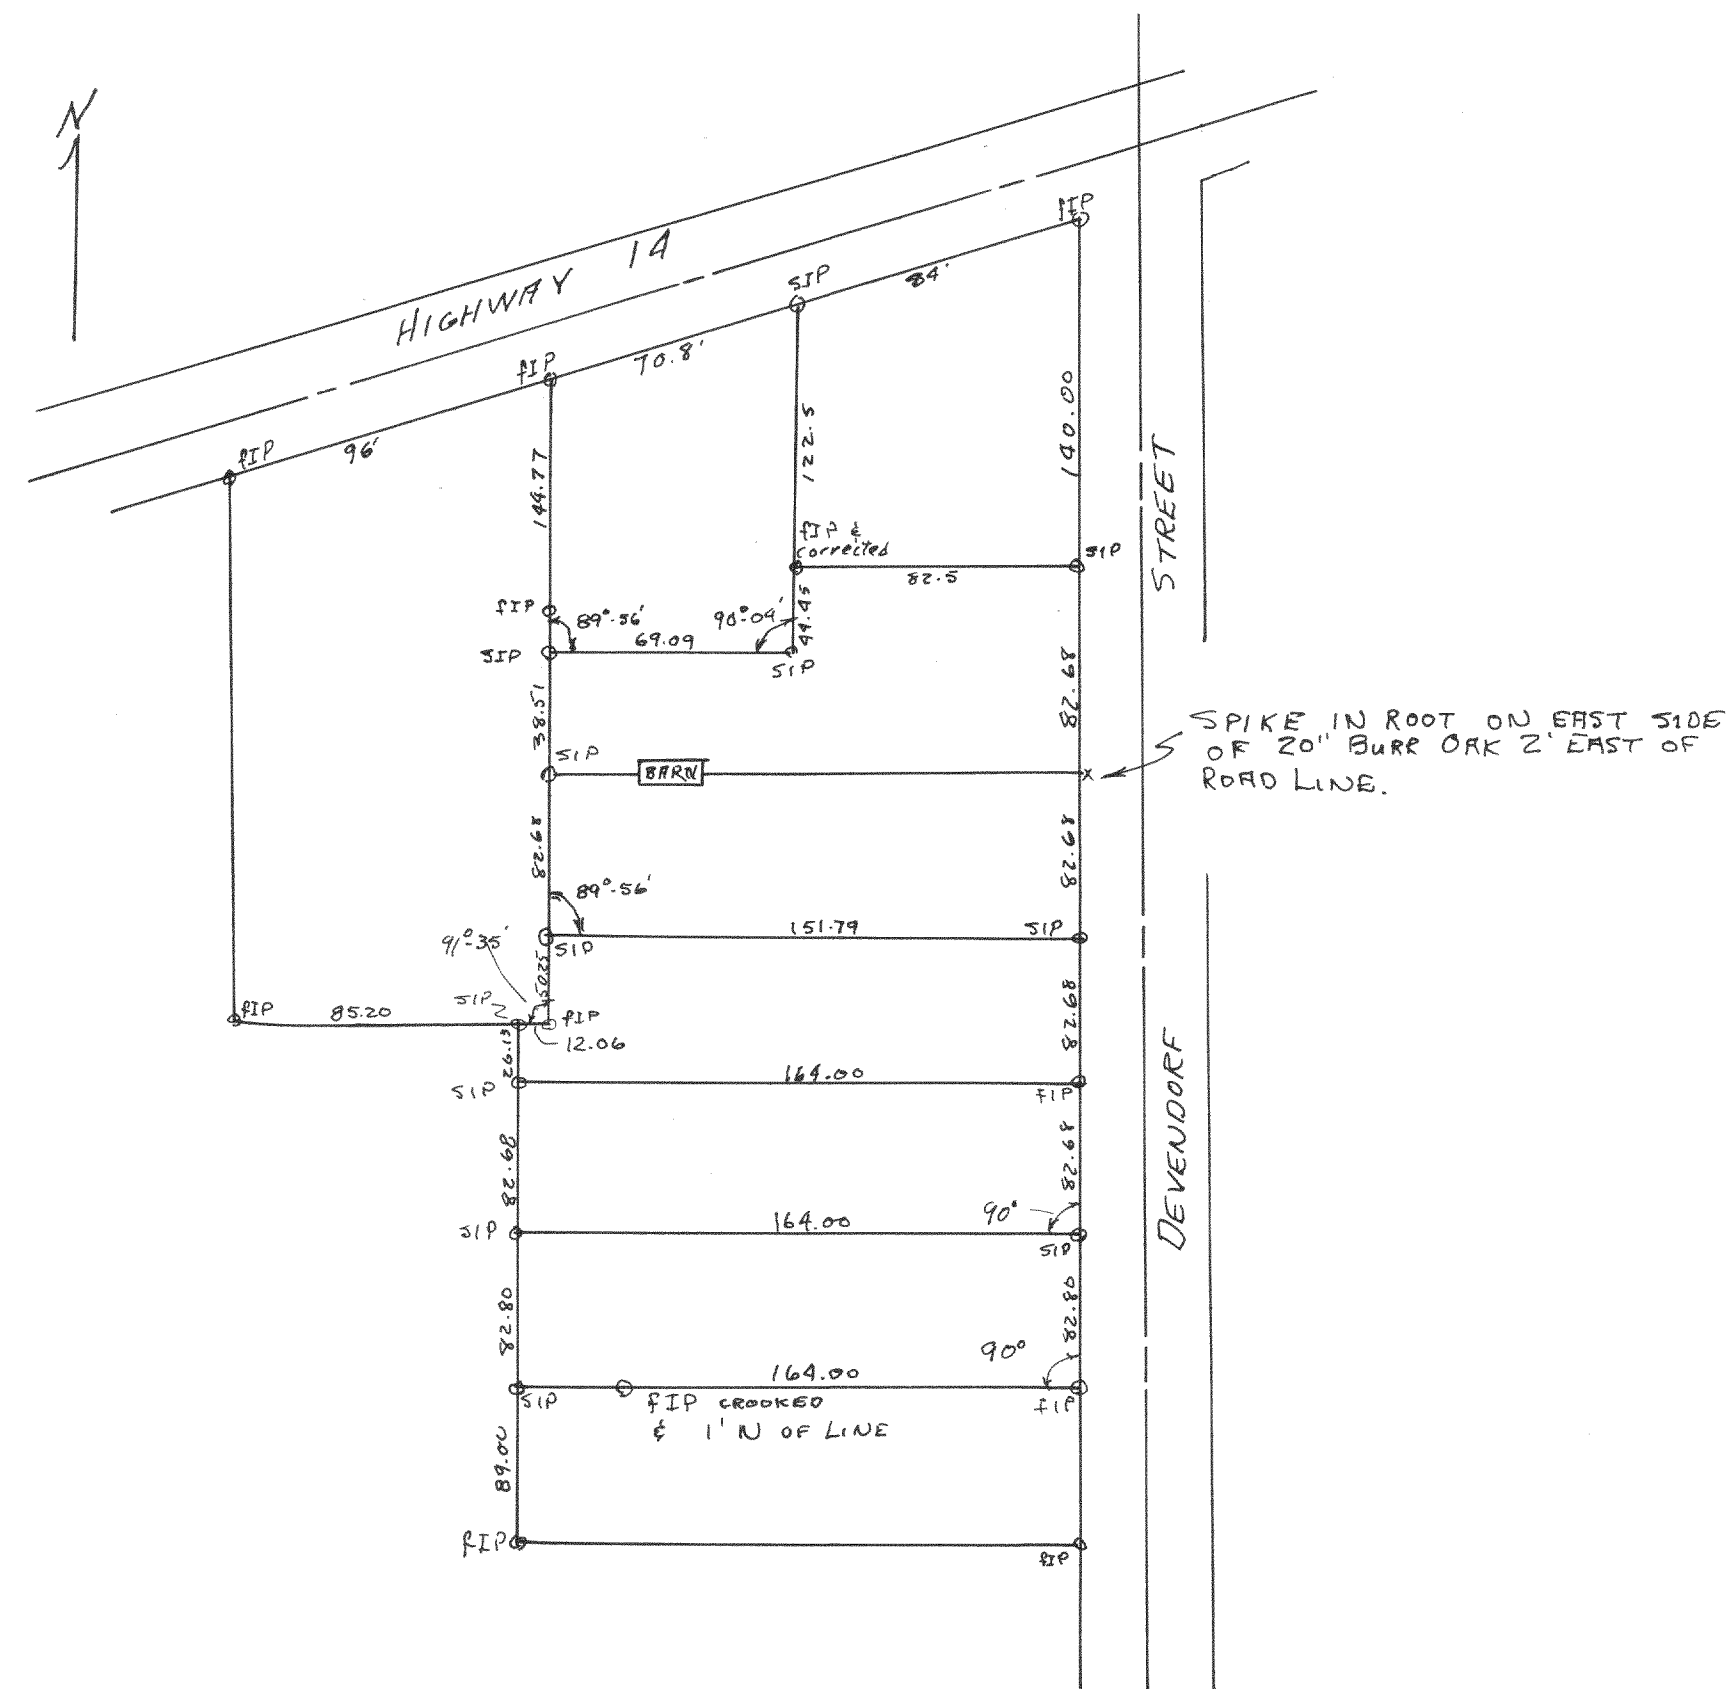

Plot of survey of land owned by Burger on Devendorf St in the
city of Elkhorn, Walworth County, Wisconsin

Aug 1947

Floyd S Jensen
County Surveyor
FSD