



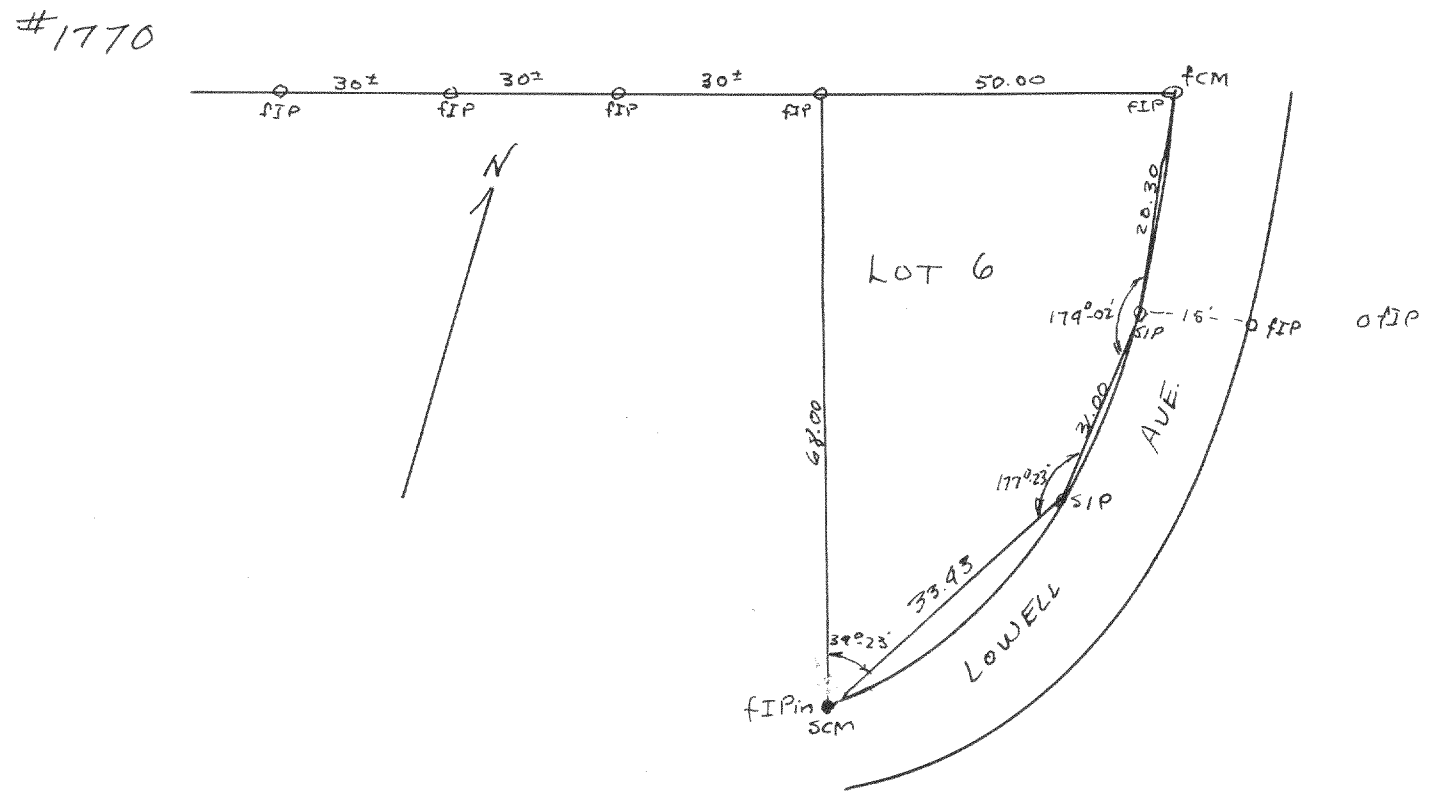

Plot of survey of Lot 6 Block R of Assembly grounds
Delavan Lake Walworth County Wisconsin

Oct 4, 1947

Floyd E Jensen
County Surveyor
1947

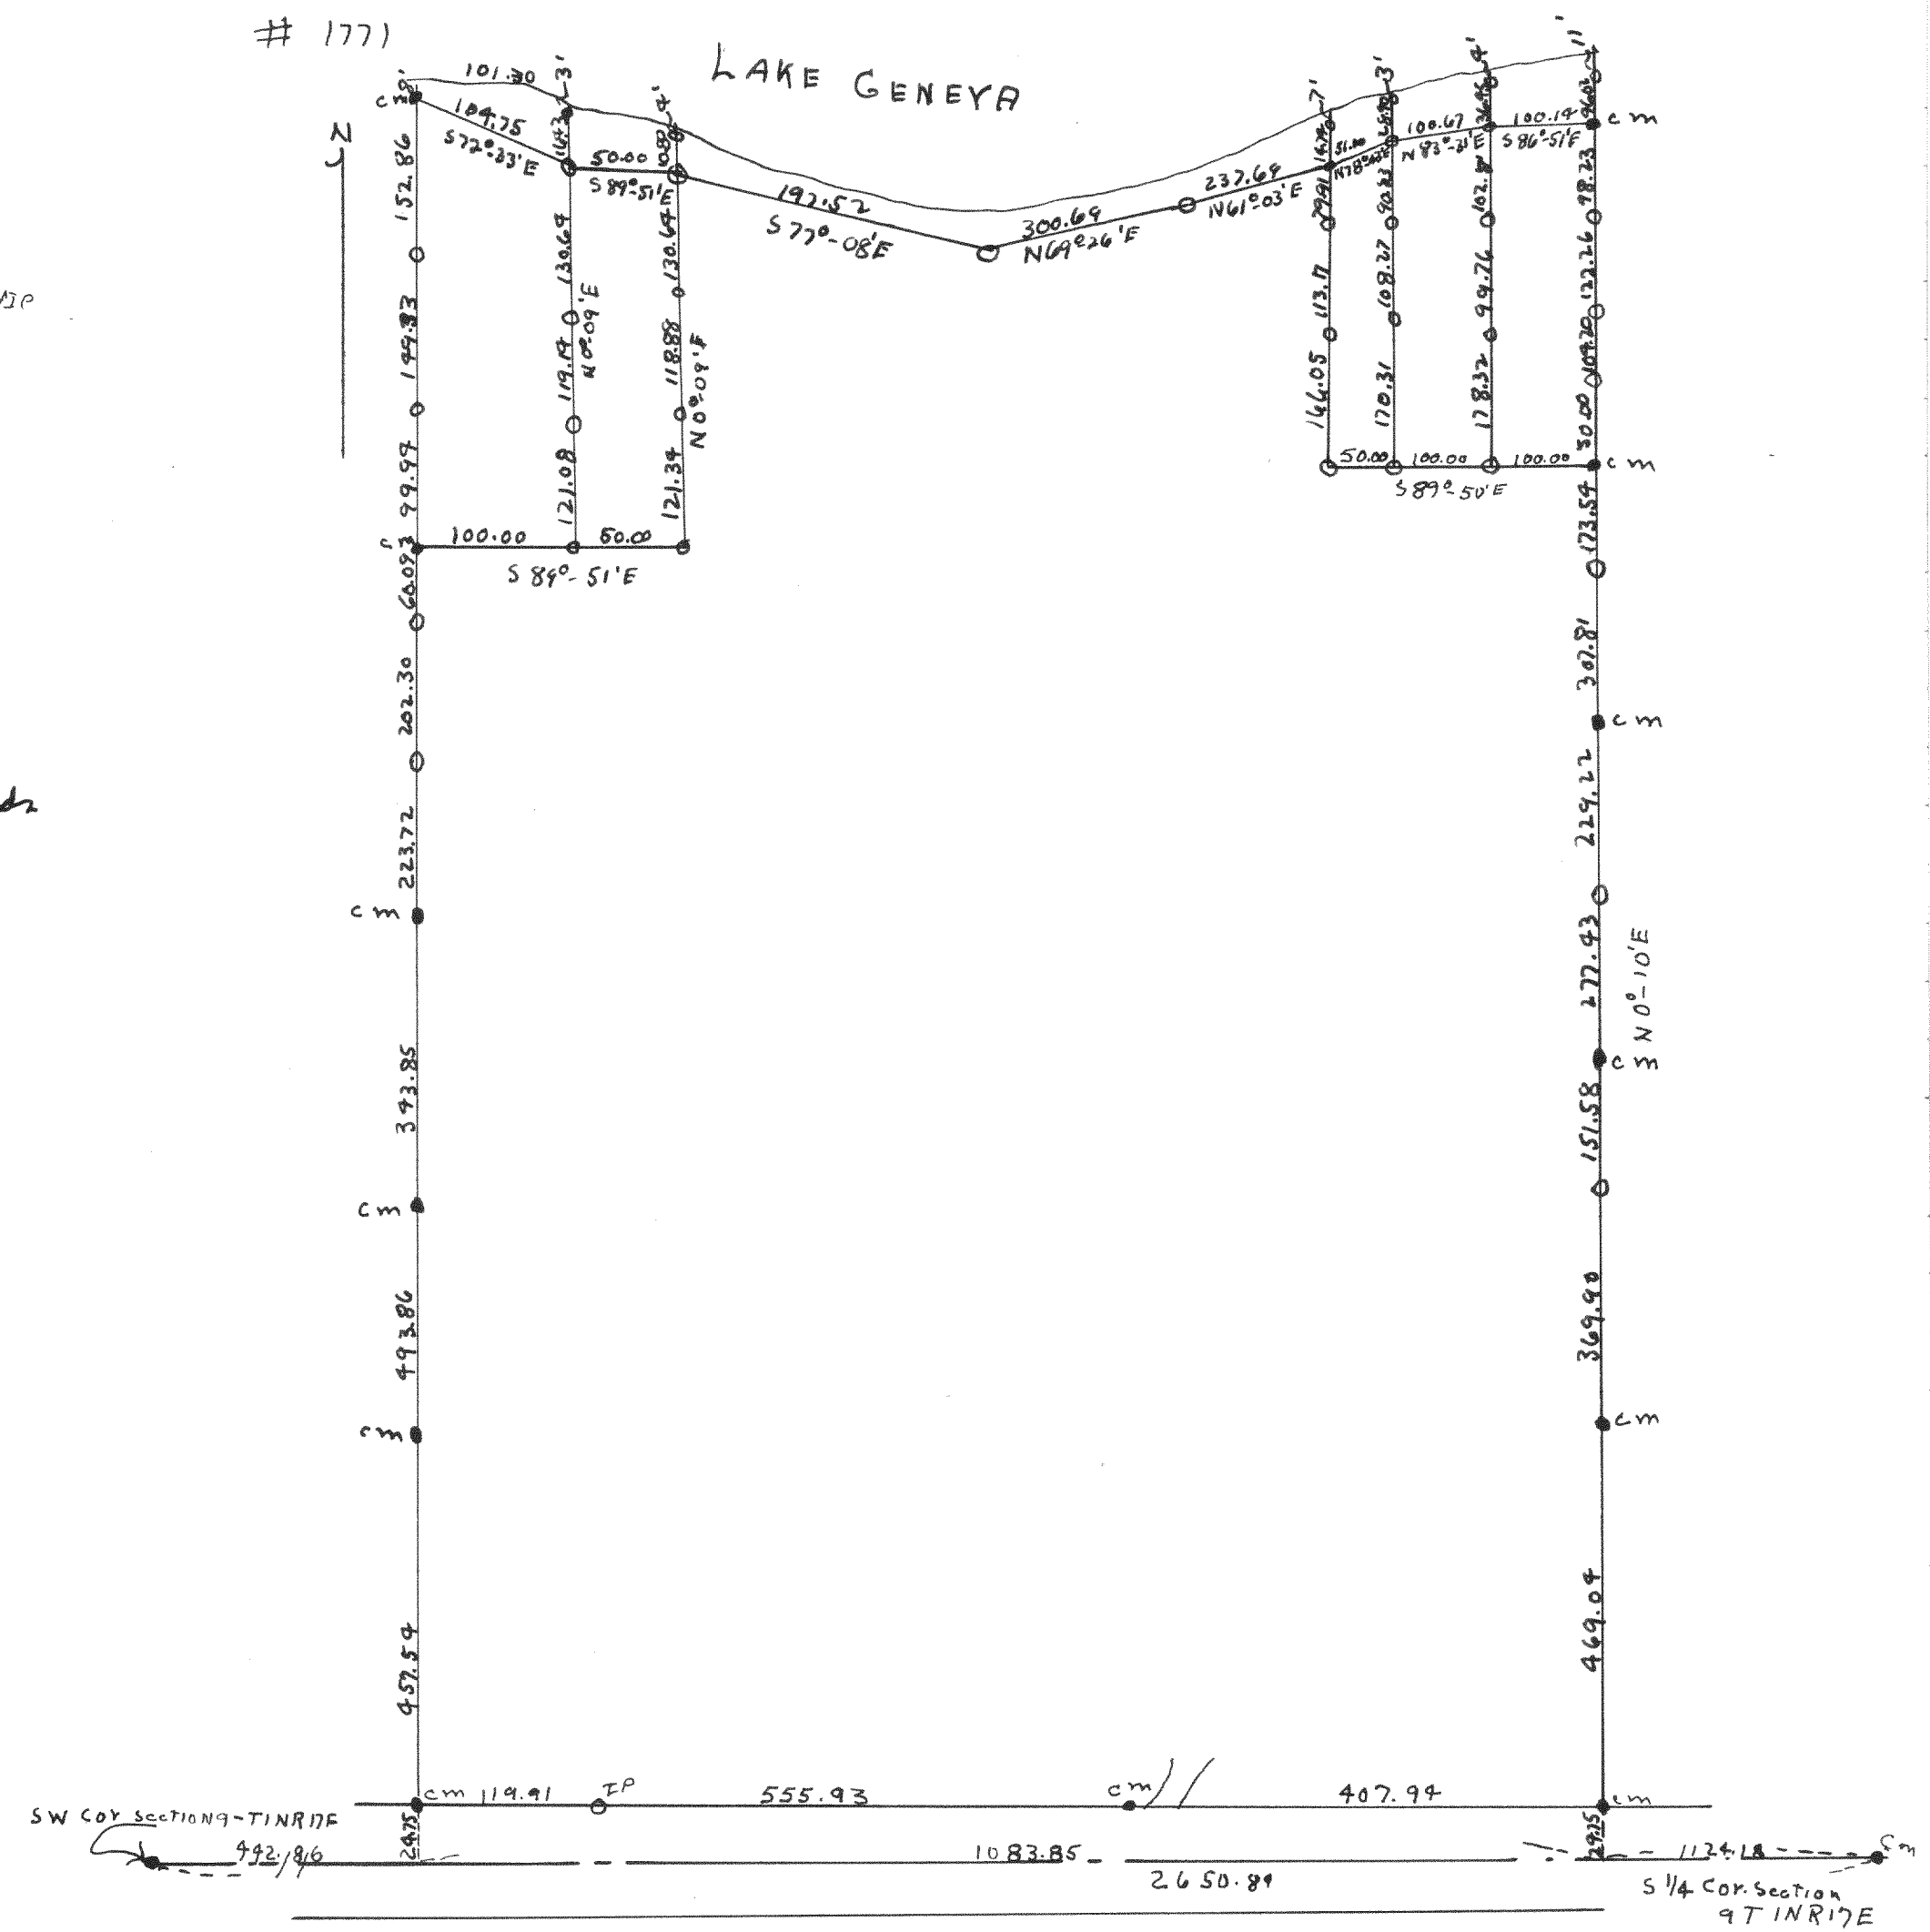

Plot of survey of Liffen Estate located in Section 9, T1N R17E
of Walworth County, Wisconsin

January 1948

Floyd E Jensen
County Surveyor
1948