



#1778

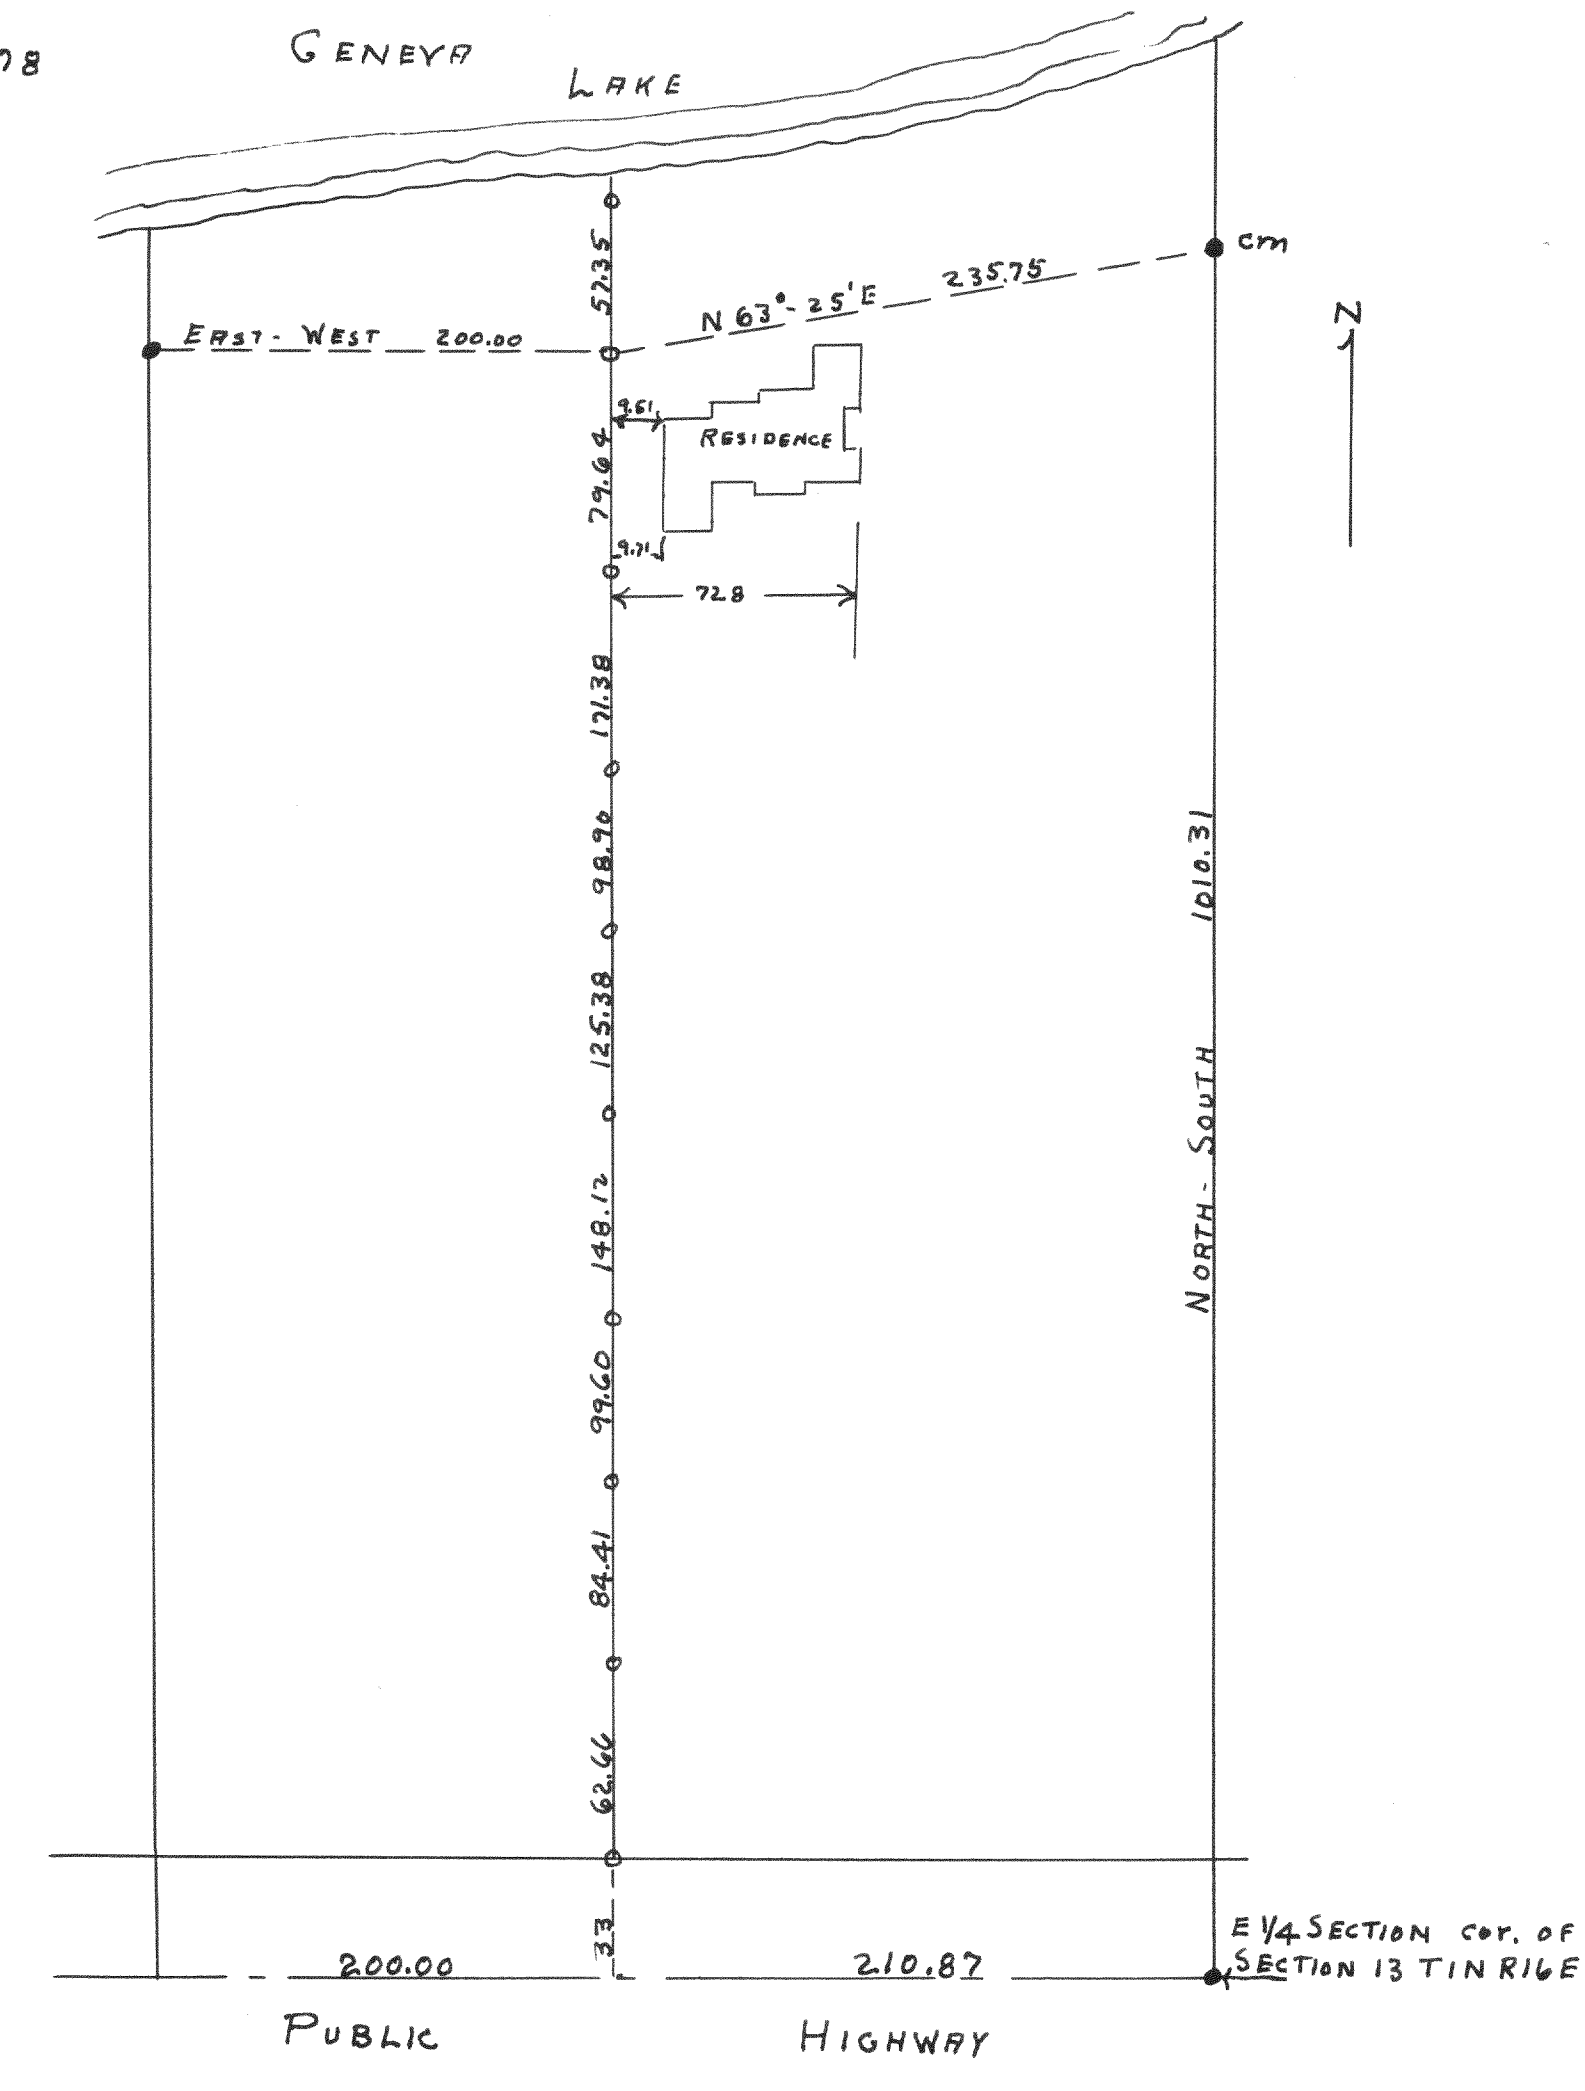

Plot of survey of parcel of land located in the NE 1/4 of
 Section 13 T1N R16E of Walworth County, Wisconsin
 June 19 1947
 Lloyd E Jensen
 County Surveyor

#1779

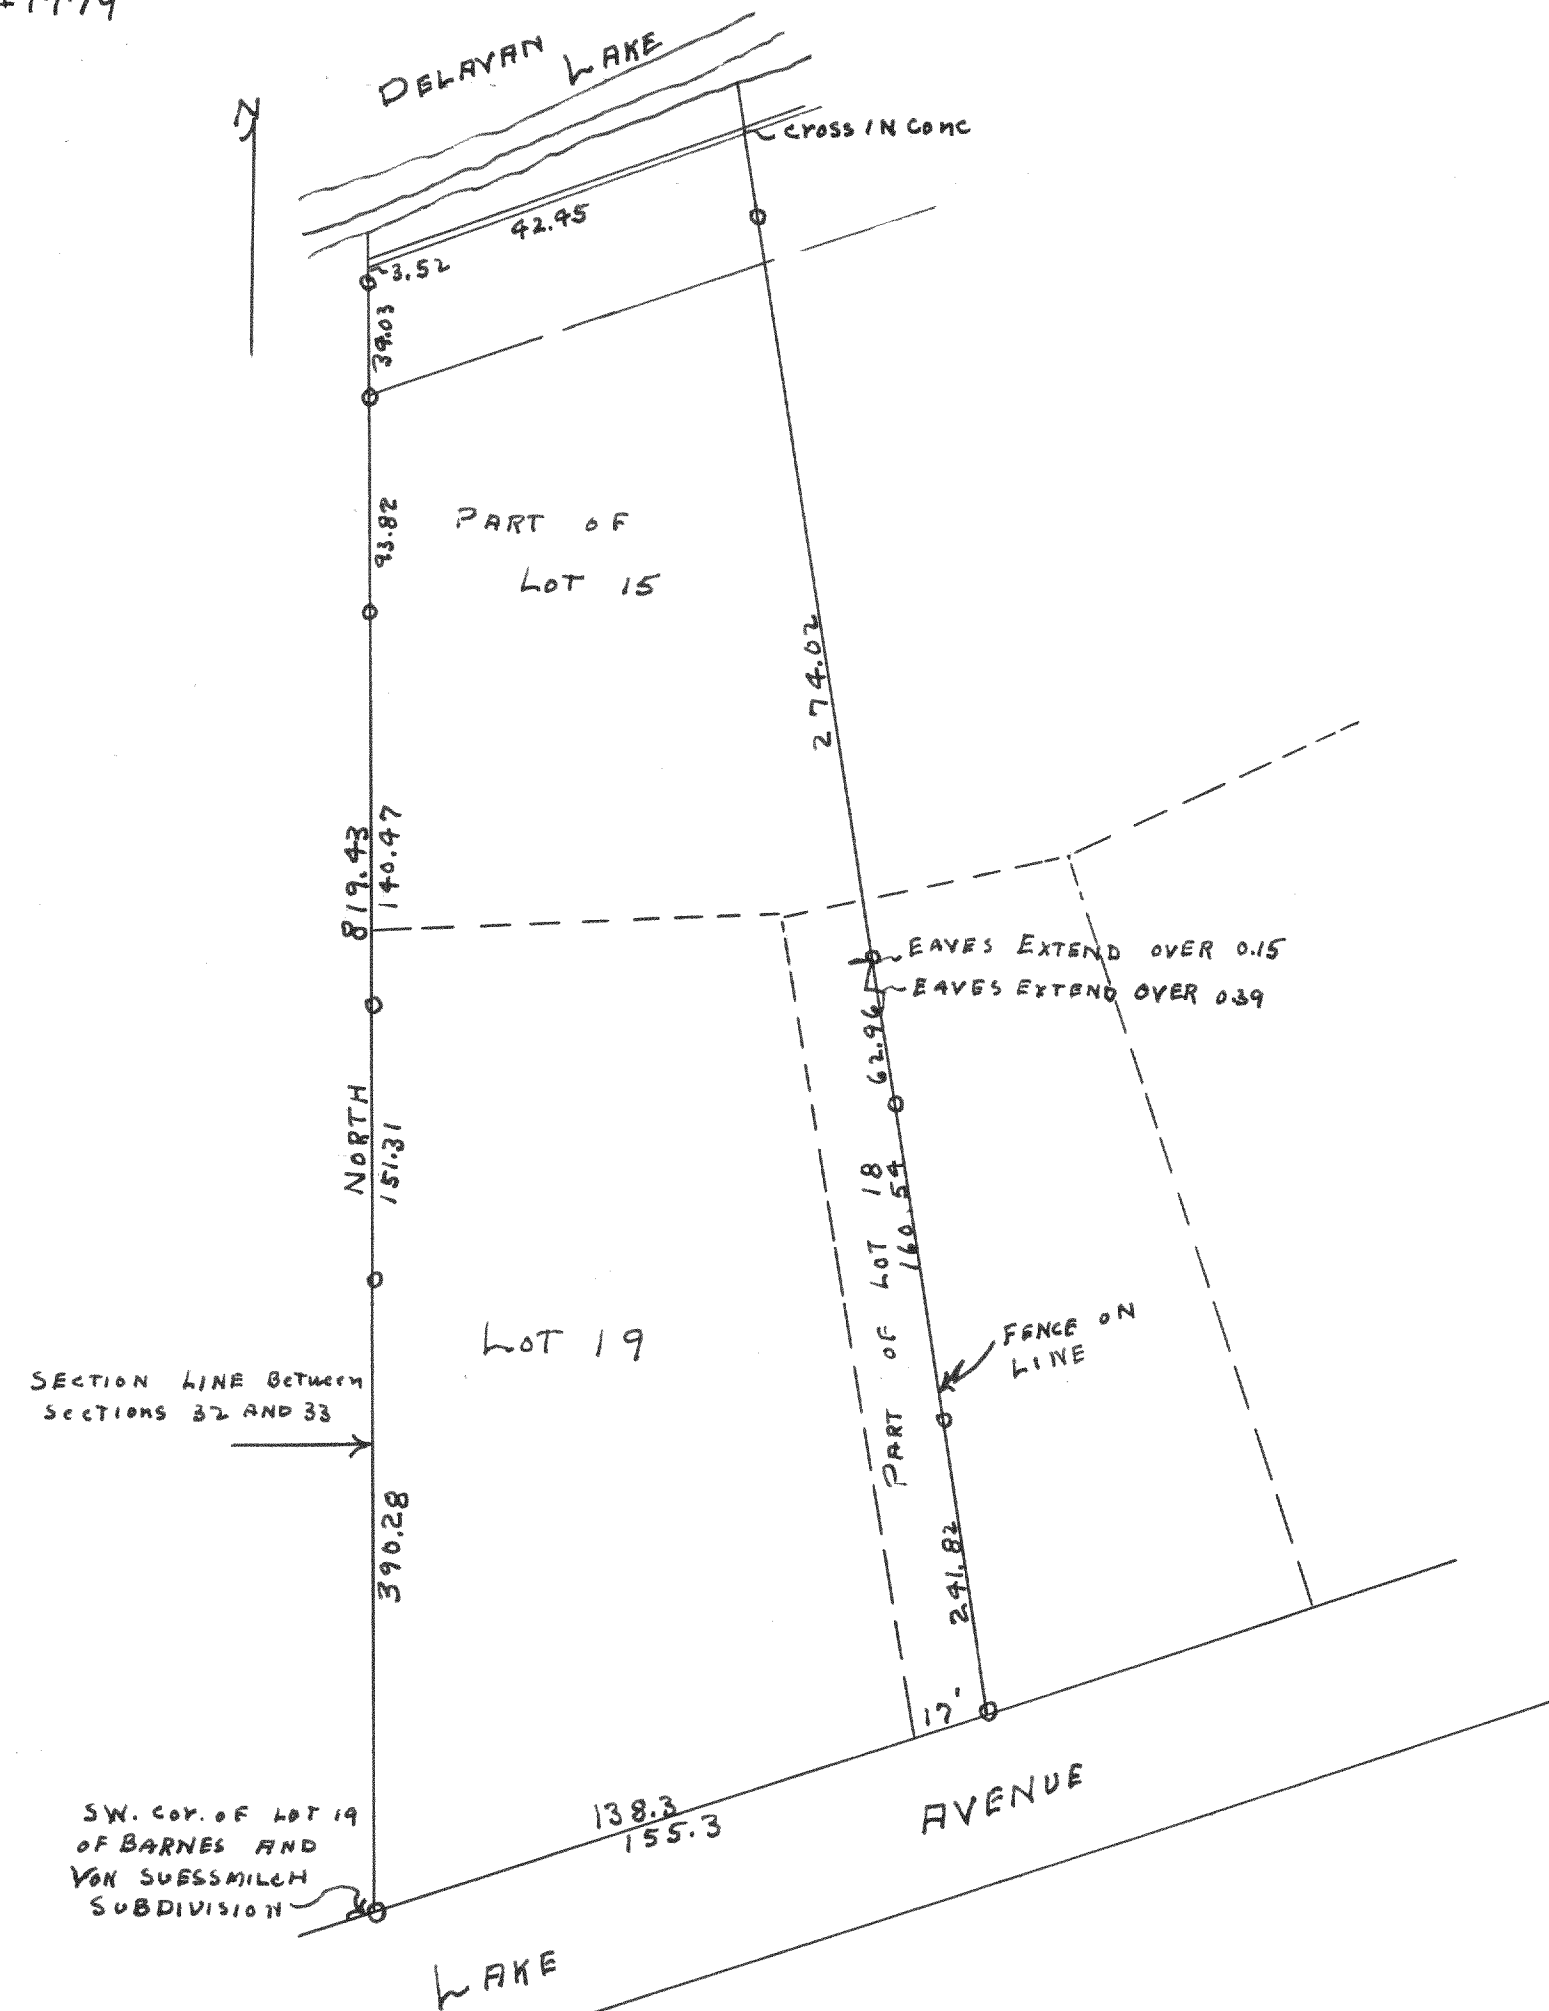

Plot of survey of lot 19, part of lot 15 and 18 of
 Barnes and Van Suesmich subdivision located in
 Section 33 T2N R16E of Walworth County, Wisconsin
 Lloyd E Jensen
 County Surveyor
 September 1947