


1780

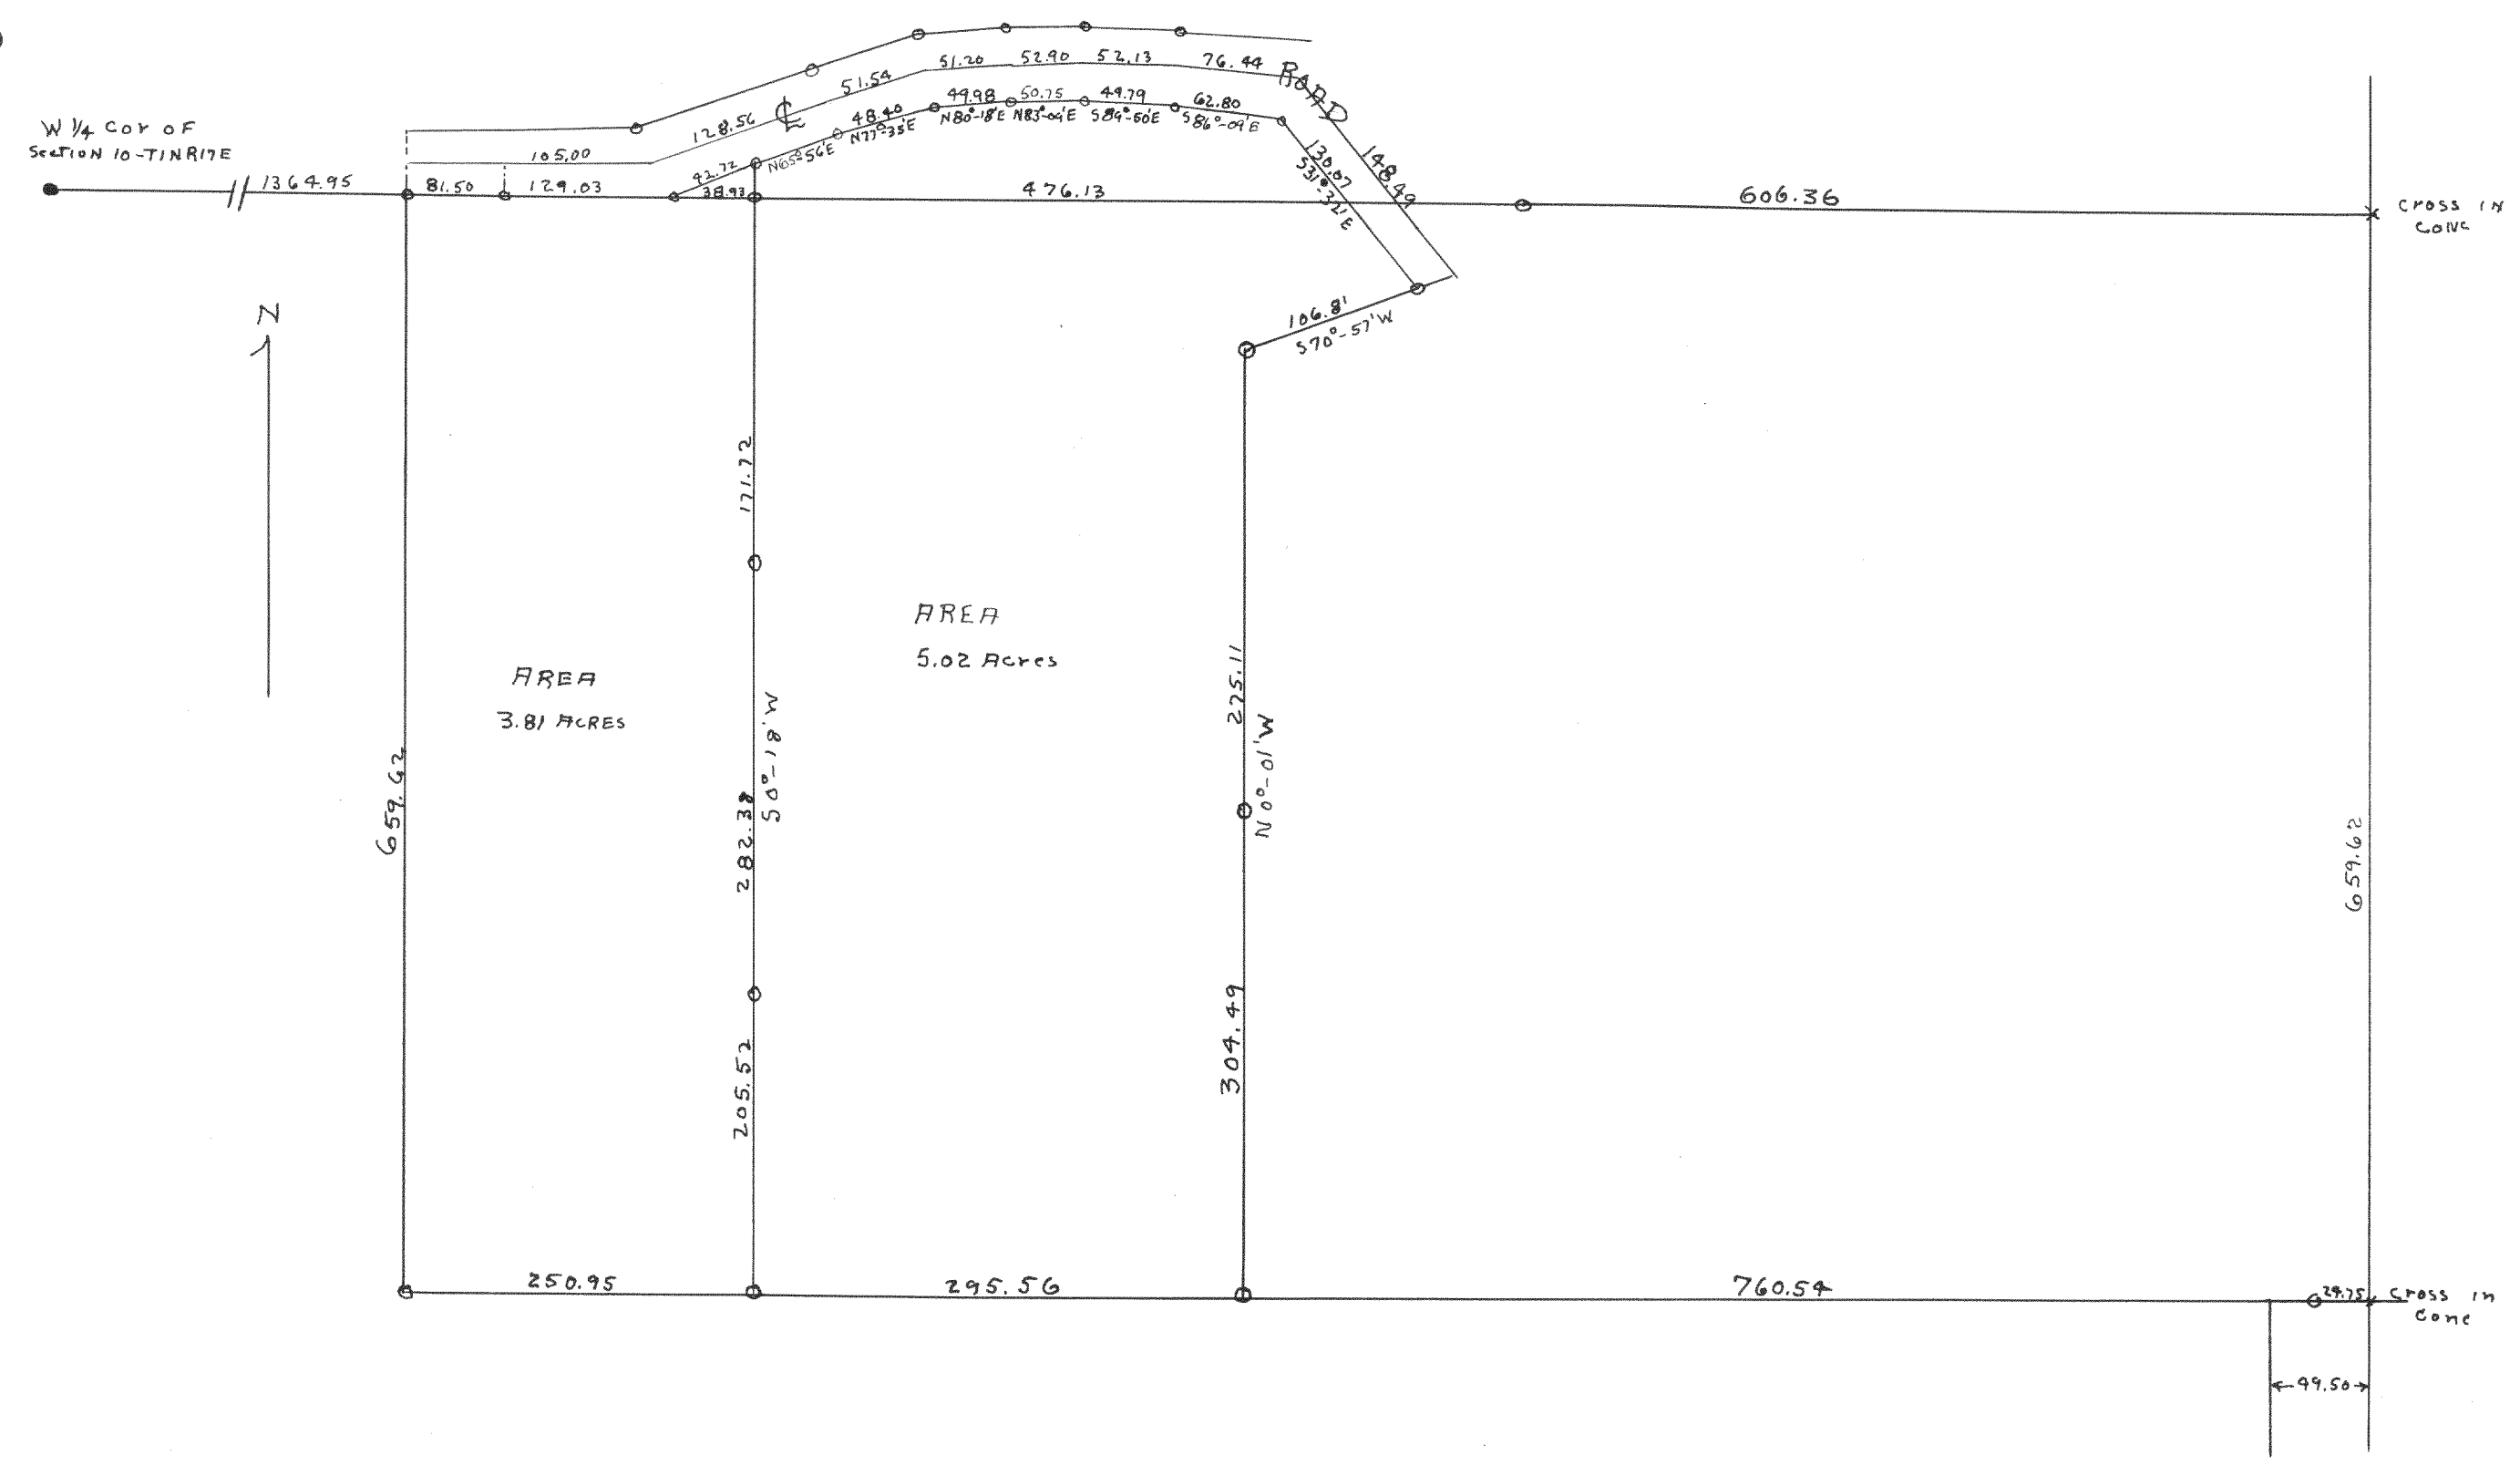

Plot of survey of a parcel of land located in Section 10 T1N R17E
of Walworth County Wisconsin

1947

Lloyd S Jensen
County Surveyor
1947