


#1783

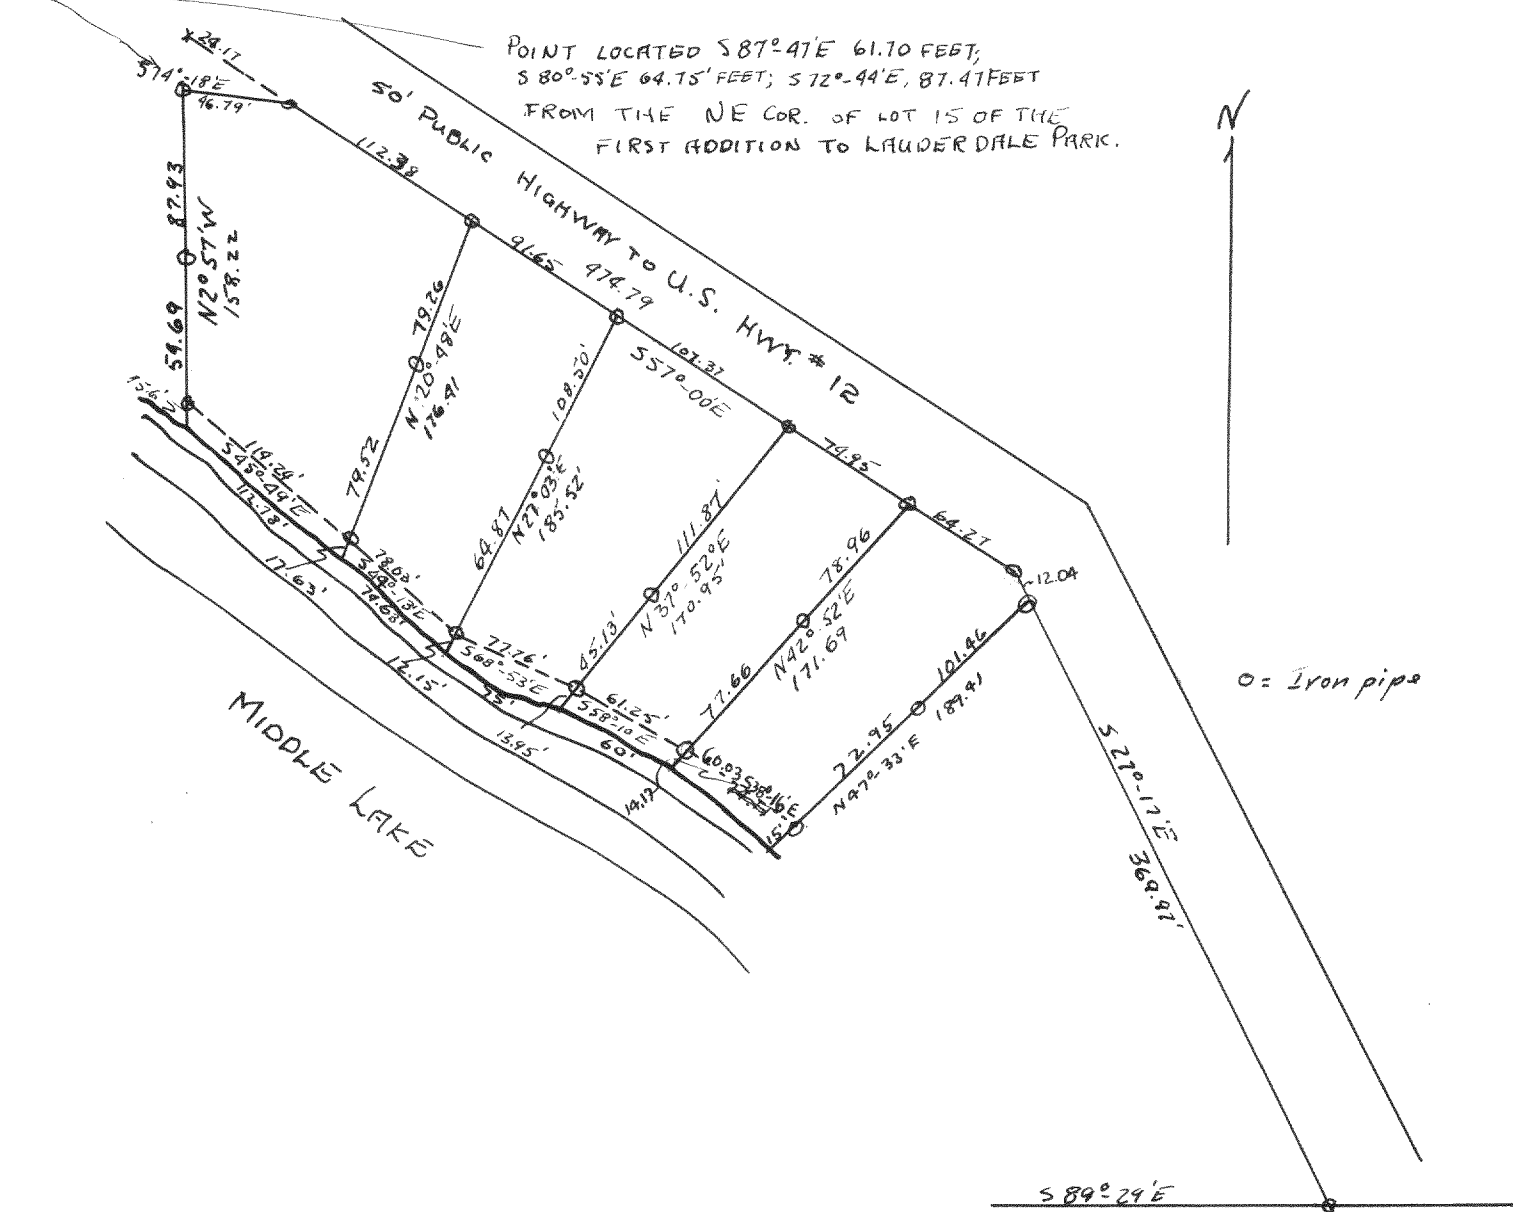


PLAT OF SURVEY OF LAND LOCATED IN GOVERNMENT LOT 4,
 SAID LOT IS THE NORTH $\frac{1}{2}$ OF THE SOUTHWEST FRACTIONAL $\frac{1}{4}$
 OF SECTION 25, T4N R16E OF WALWORTH COUNTY, WISCONSIN.

OCT. 1947

Lloyd L. Jensen
 WALWORTH COUNTY SURVEYOR

#1784

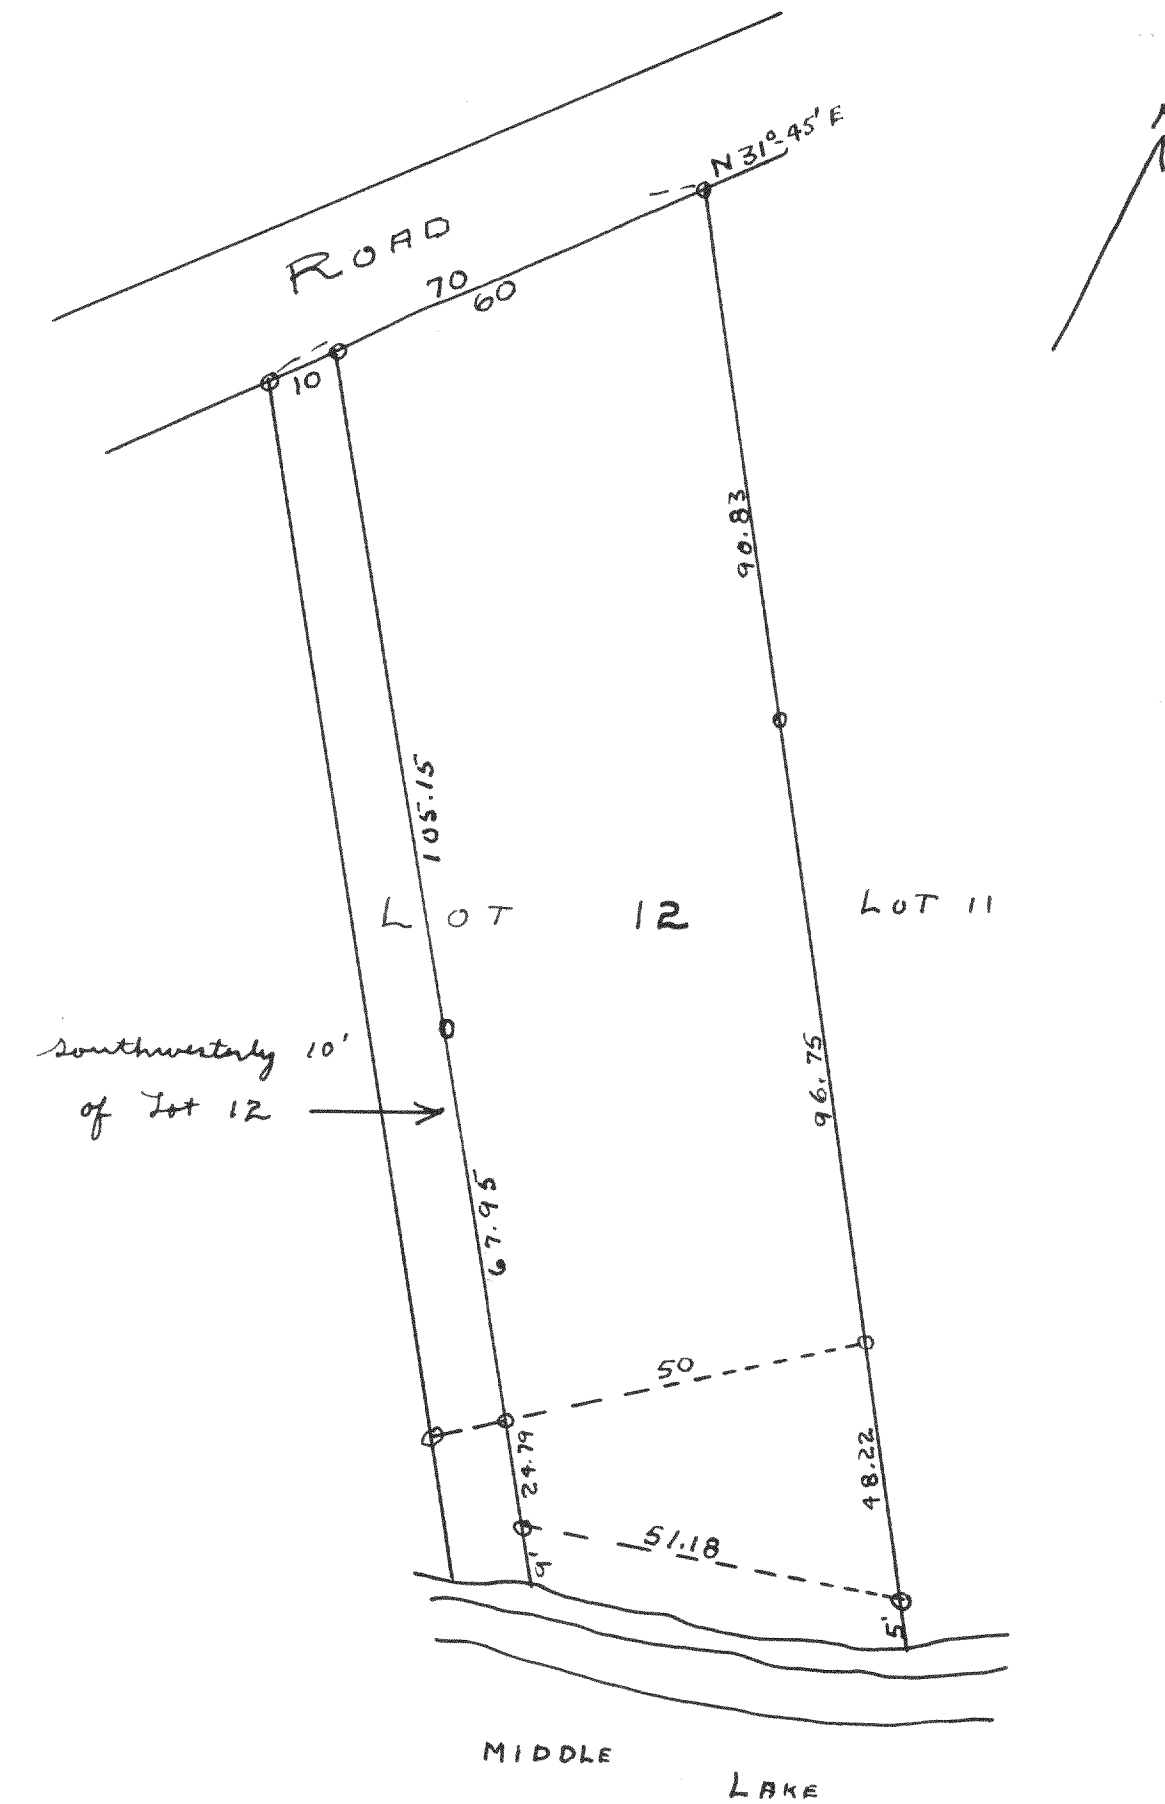

Plat of survey of lot 12 of Oak Park subdivision excepting the
 southwesterly 10 feet; said subdivision is located in Section 26 T4N R16E
 of Walworth County Wisconsin

1948

Lloyd L. Jensen
 County Surveyor