


SURVEY NO. 1240

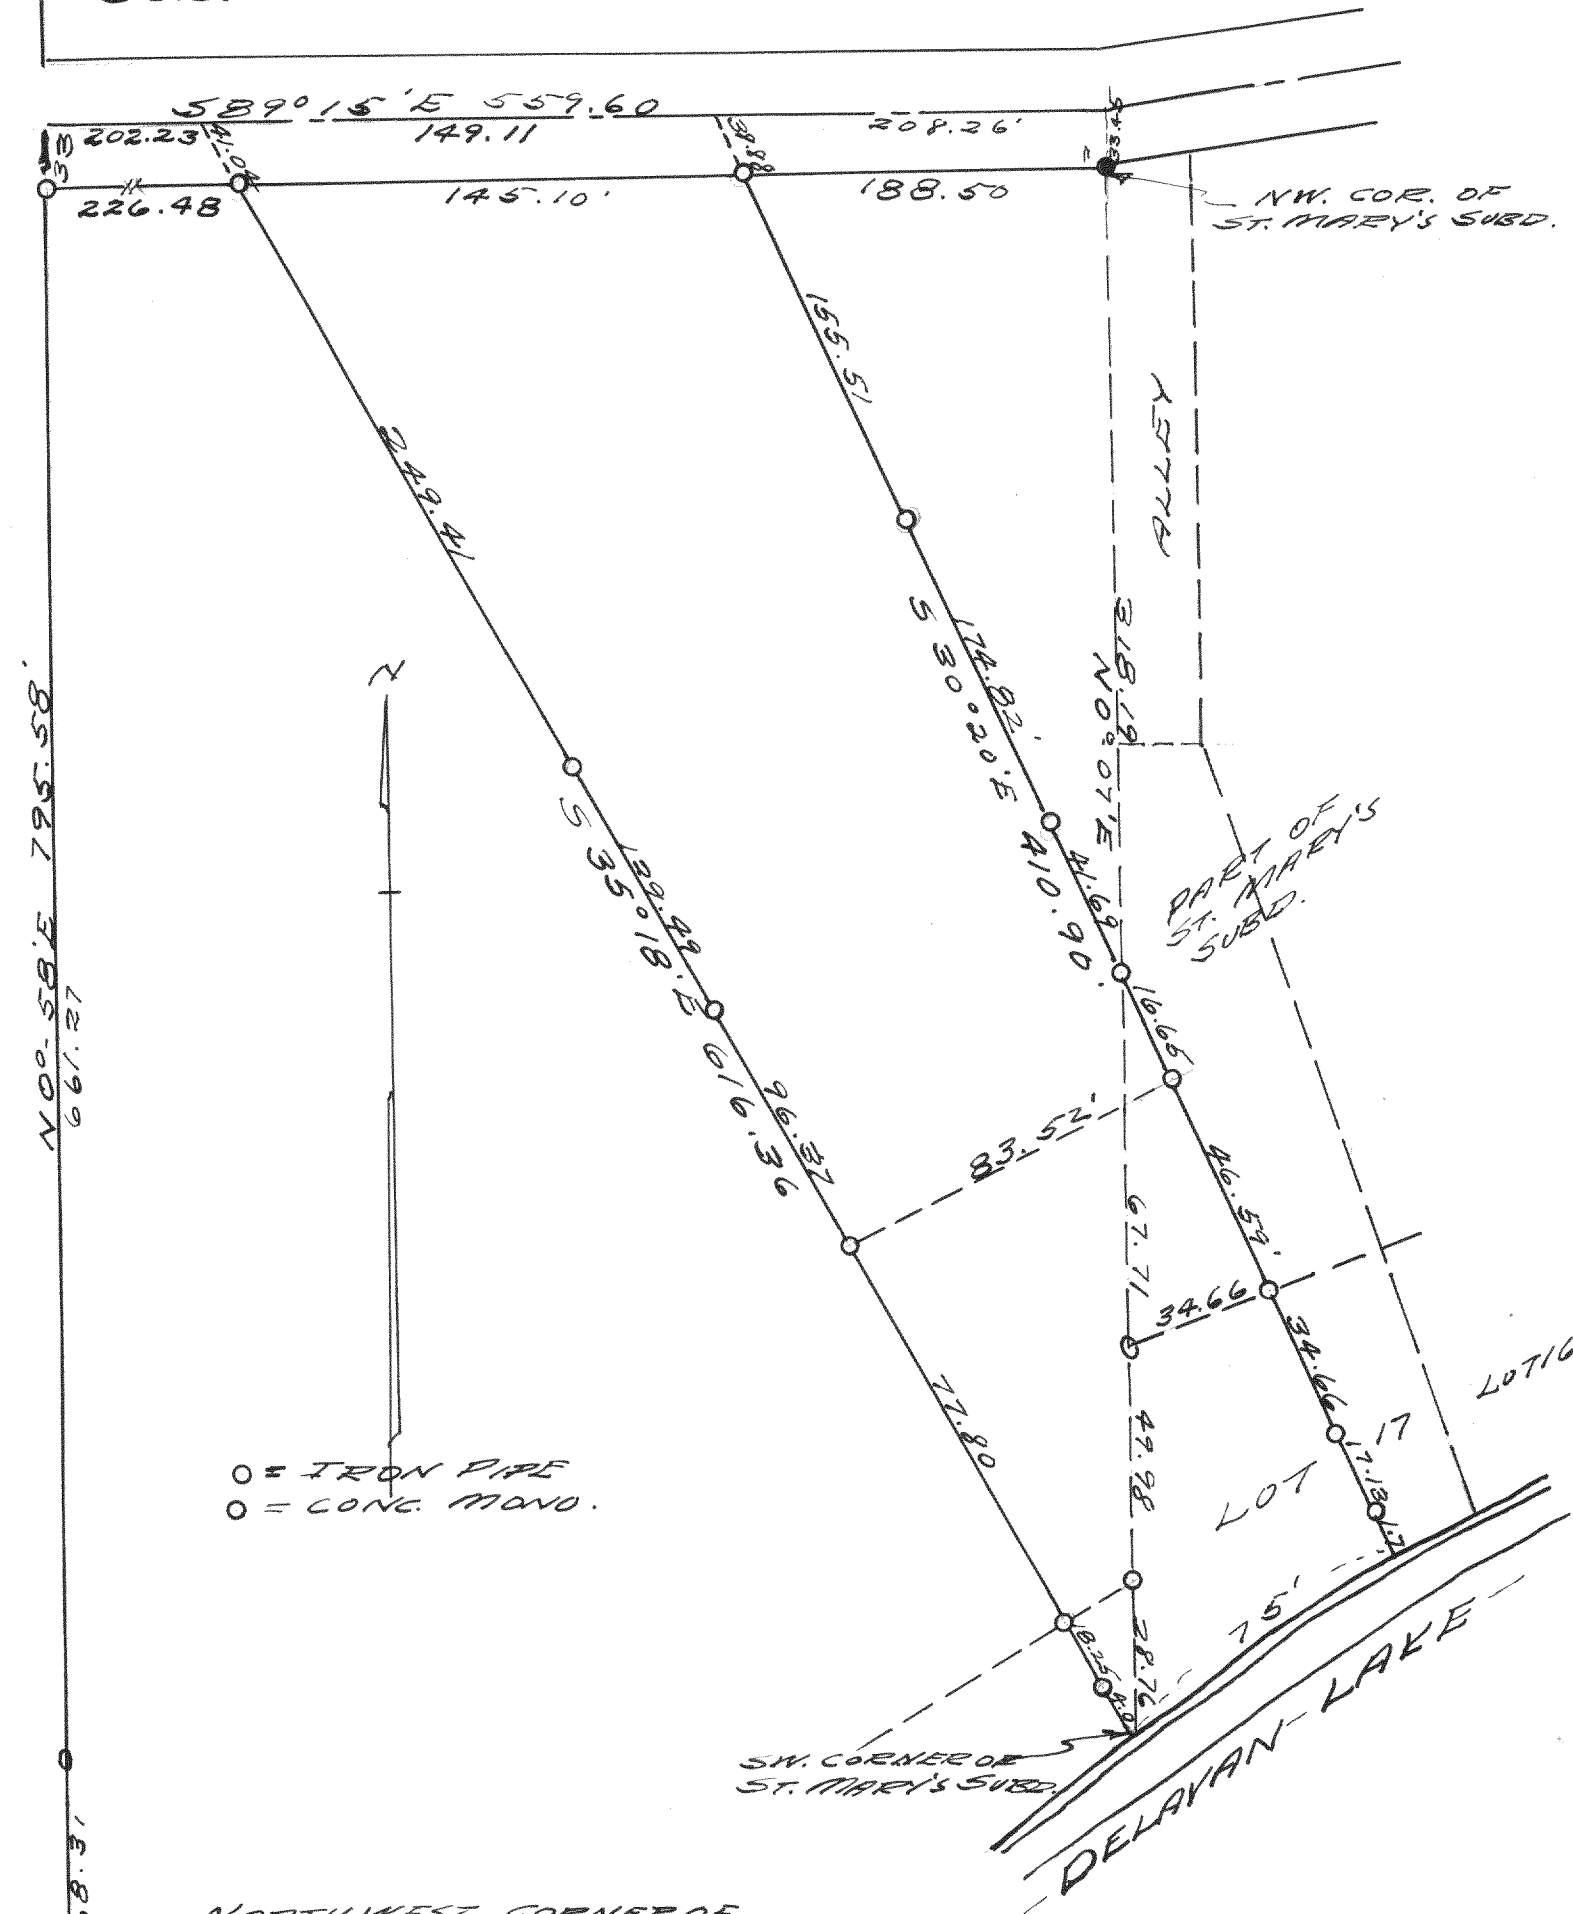


NORTHWEST CORNER OF
ROCKFORD COLONY SUBD.

PLAT OF SURVEY OF LAND LOCATED IN
THE NORTHWEST $\frac{1}{4}$ OF SECTION 28,
T2N R16E OF WALNORTH COUNTY, WISC.
OCT, 1941

Lloyd L. Jensen
R.E.G.

SURVEY NO. 1241

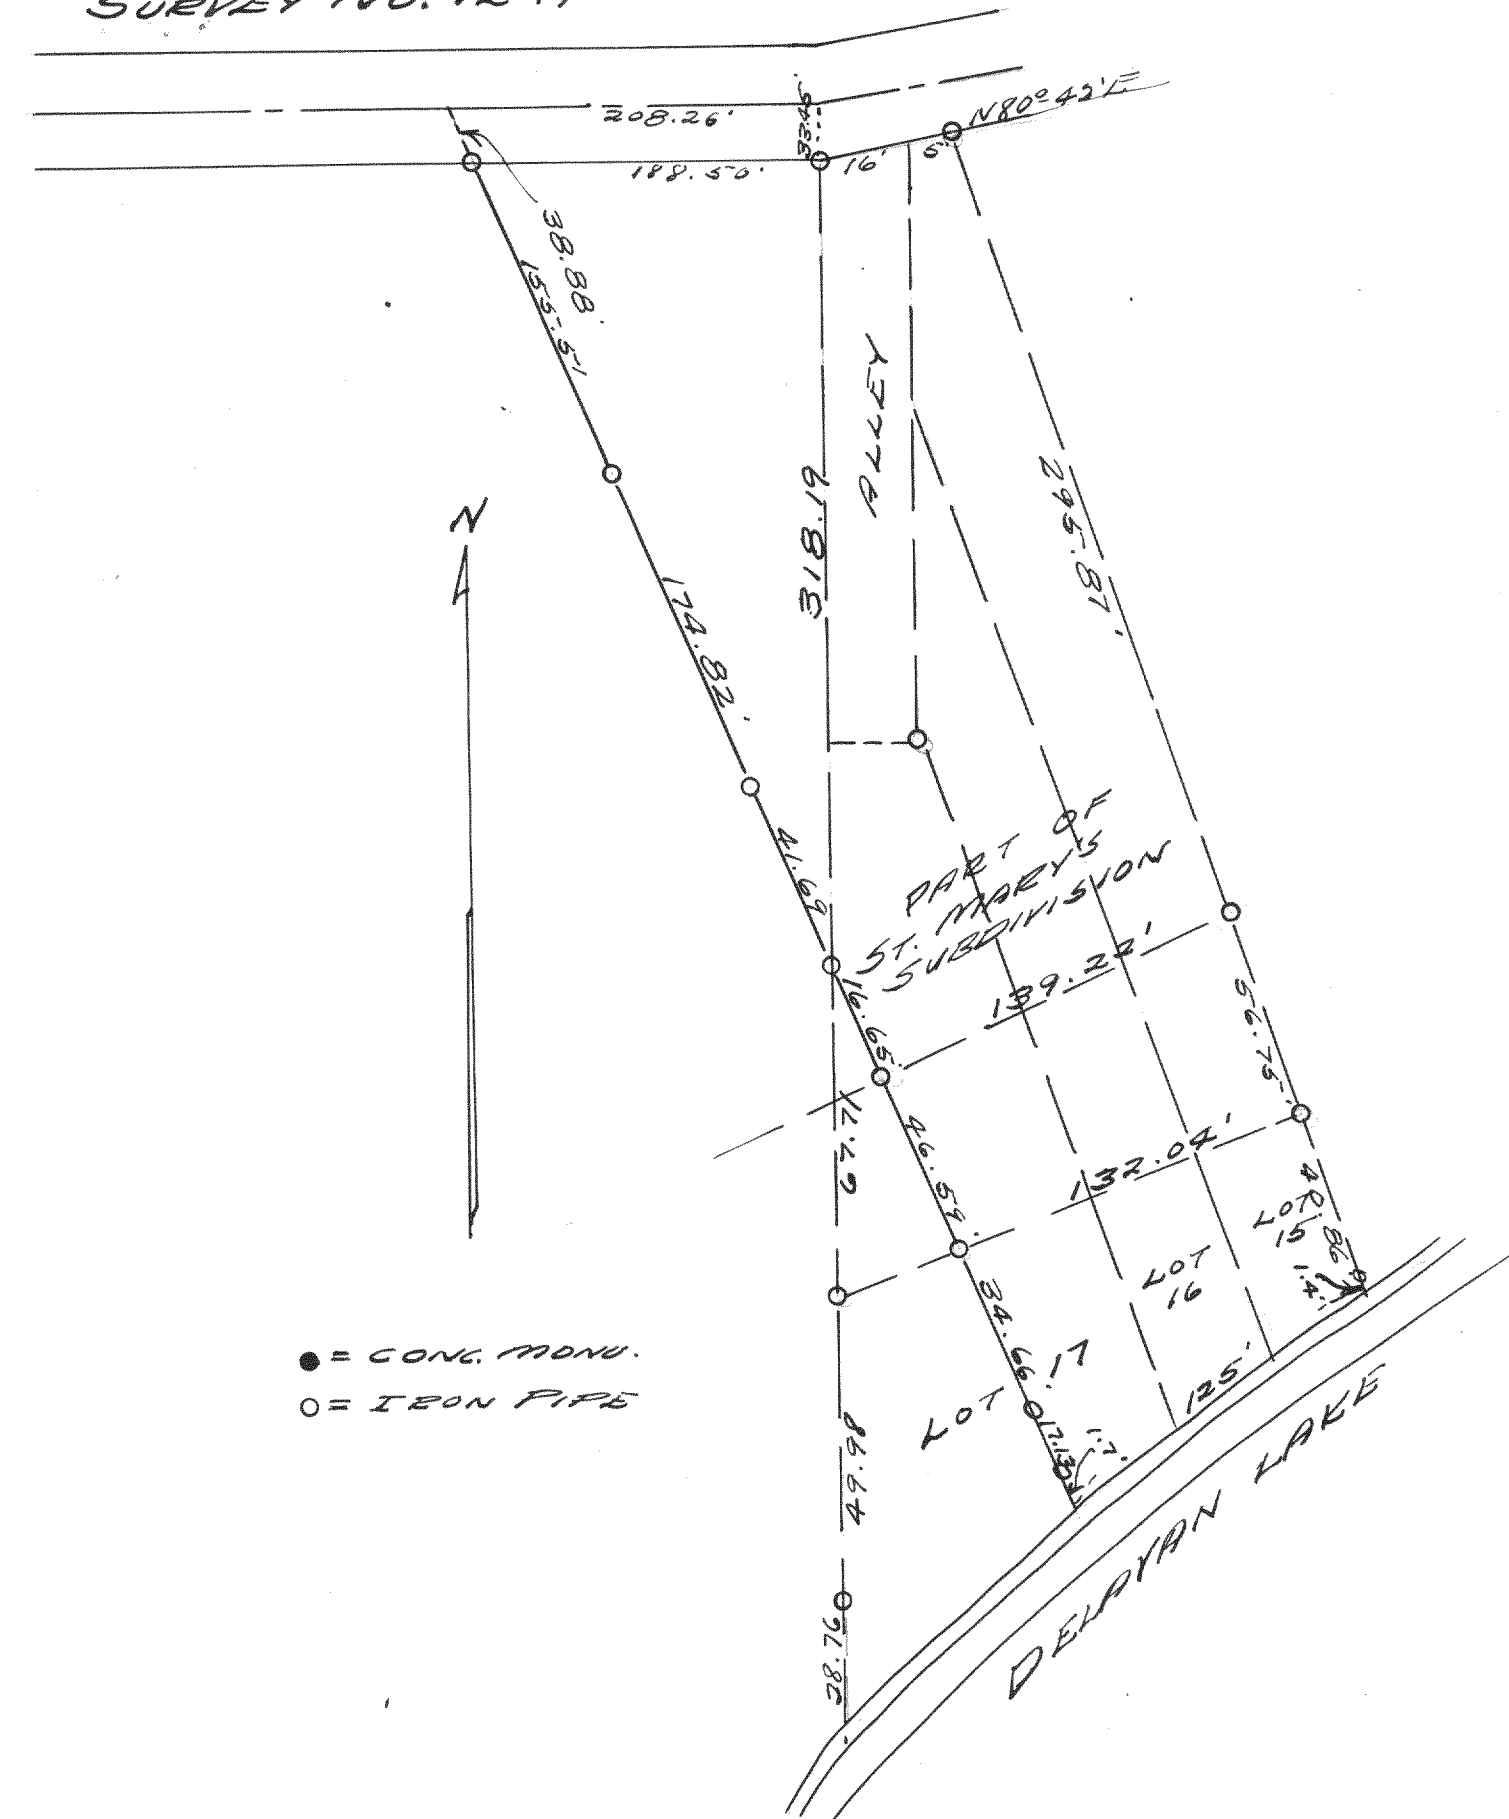

● = CONC. MONU.
○ = IRON PIPE

PLAT OF SURVEY OF LAND LOCATED
IN THE NORTHWEST $\frac{1}{4}$ OF SECTION 28
T2N, R16E, WALNORTH CO., WISCONSIN

OCT, 1941

Lloyd L. Jensen
R.E.G.