


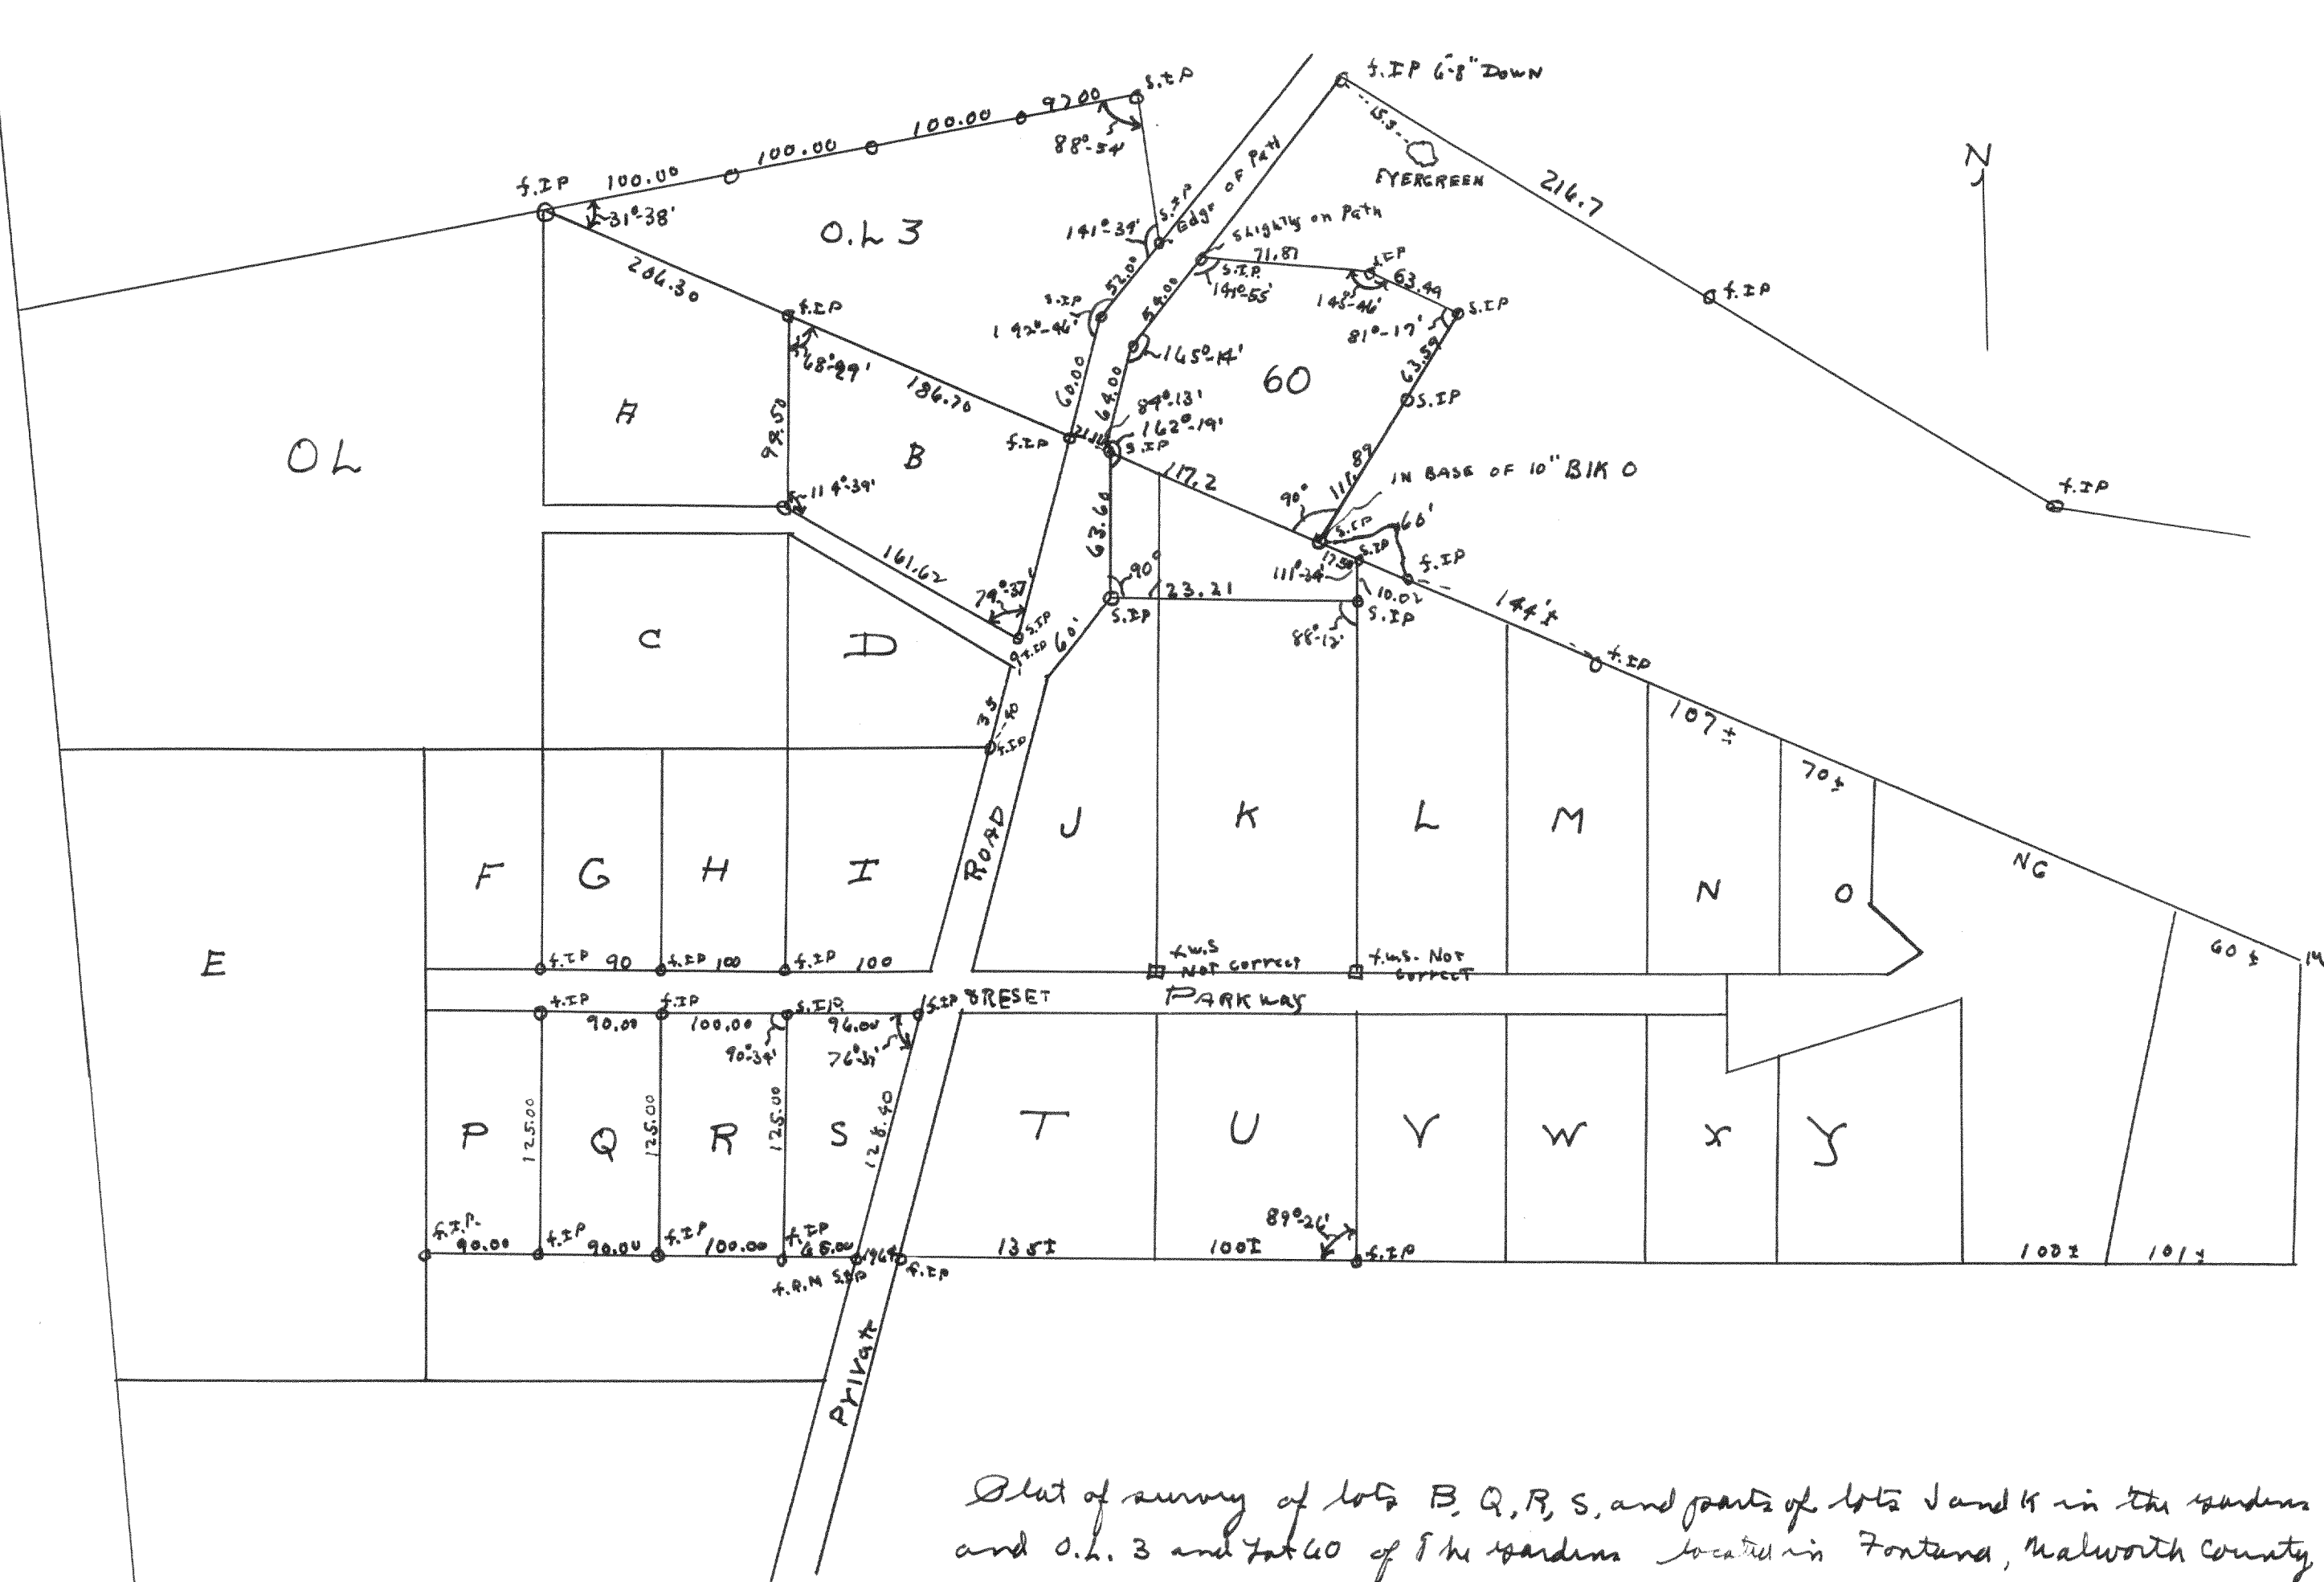

Sept 1997.

Lloyd E Jensen
County Surveyor
1950