


1790

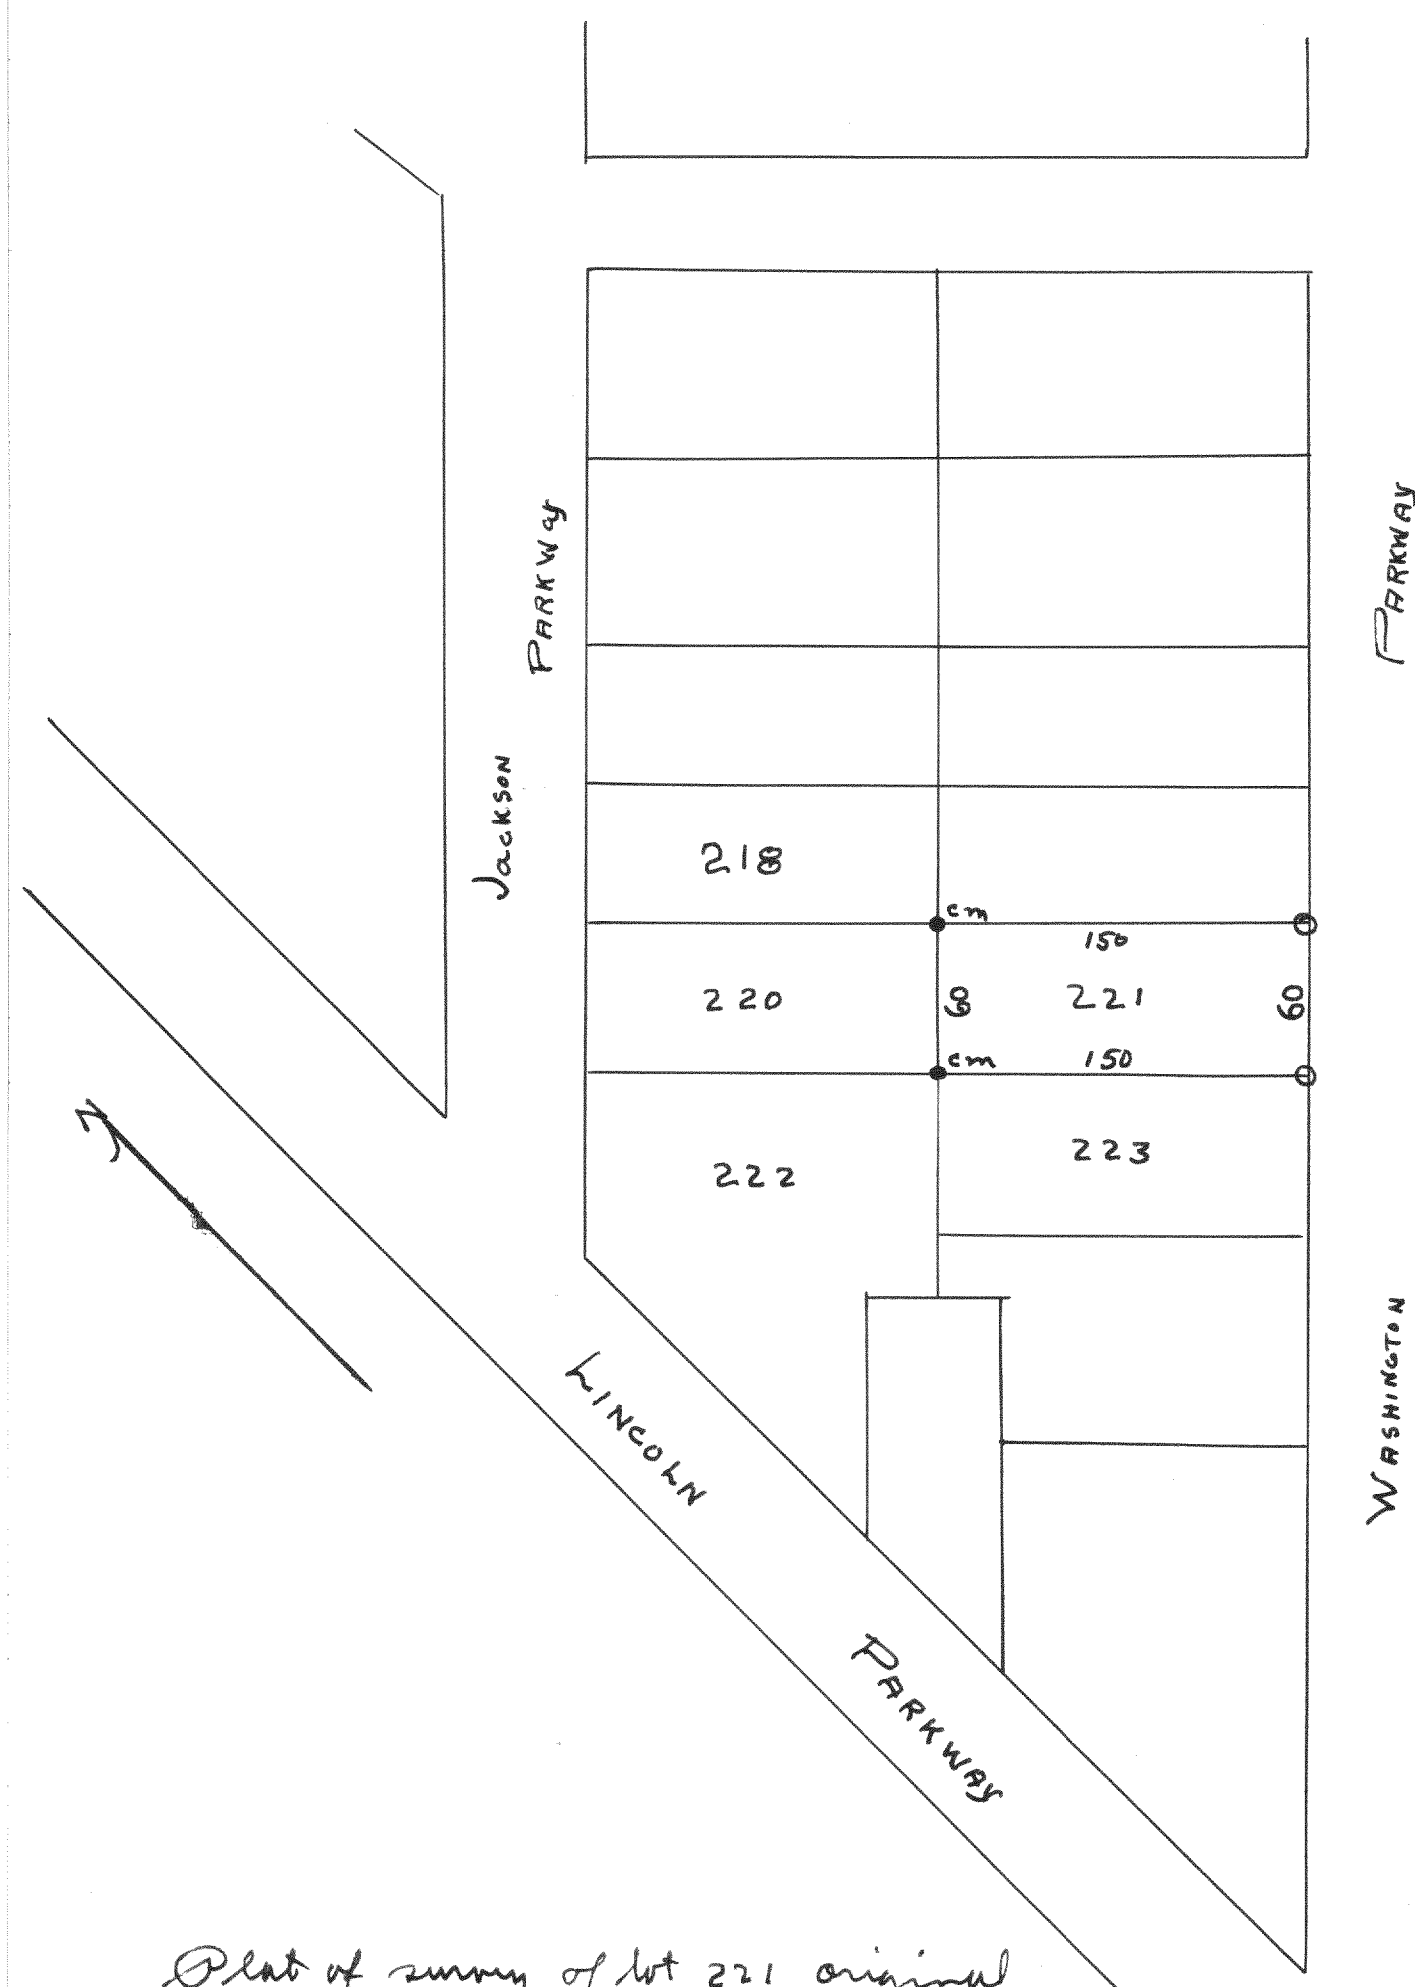


Plot of survey of lot 221 original
Adair Park subdivision located in the
Village of Williams Bay, Walworth County Wisconsin

Sept 1946

Lloyd L Jensen
County Surveyor
1946

1791

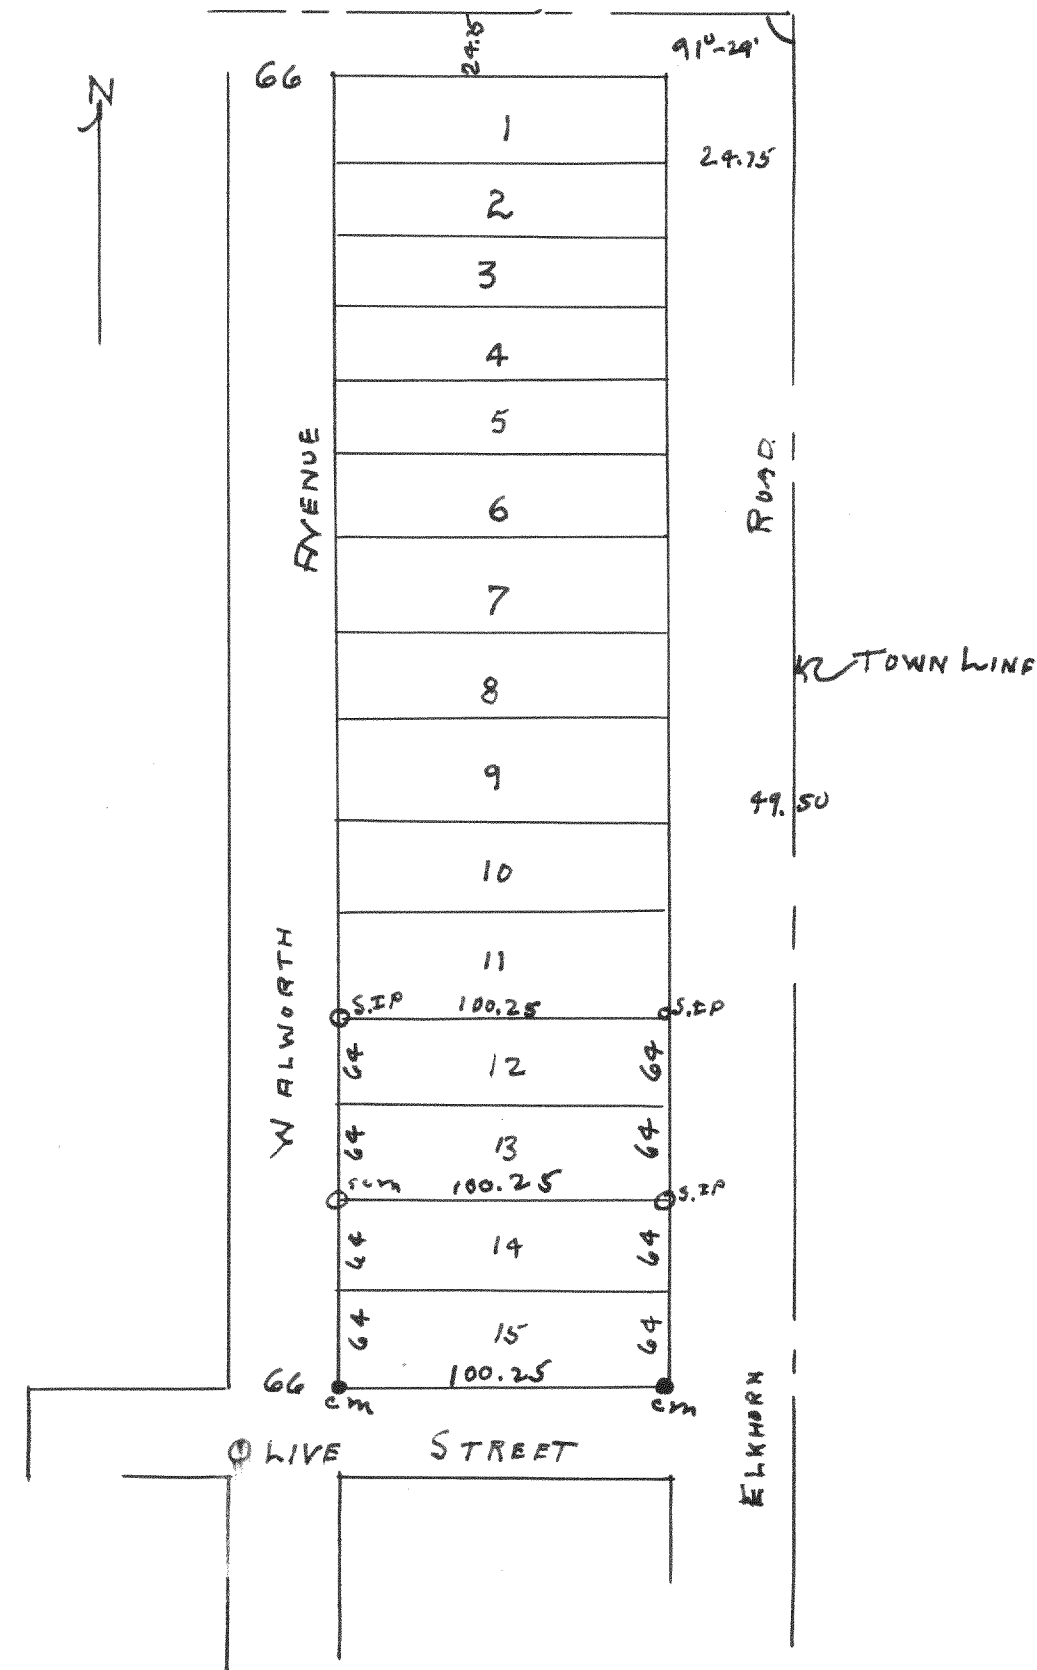

Plot of survey of lots 12 and 13 of William H Francis
subdivision in the Village of Williams Bay, Walworth County
Wisconsin
1947

Lloyd L Jensen
County Surveyor
1947