


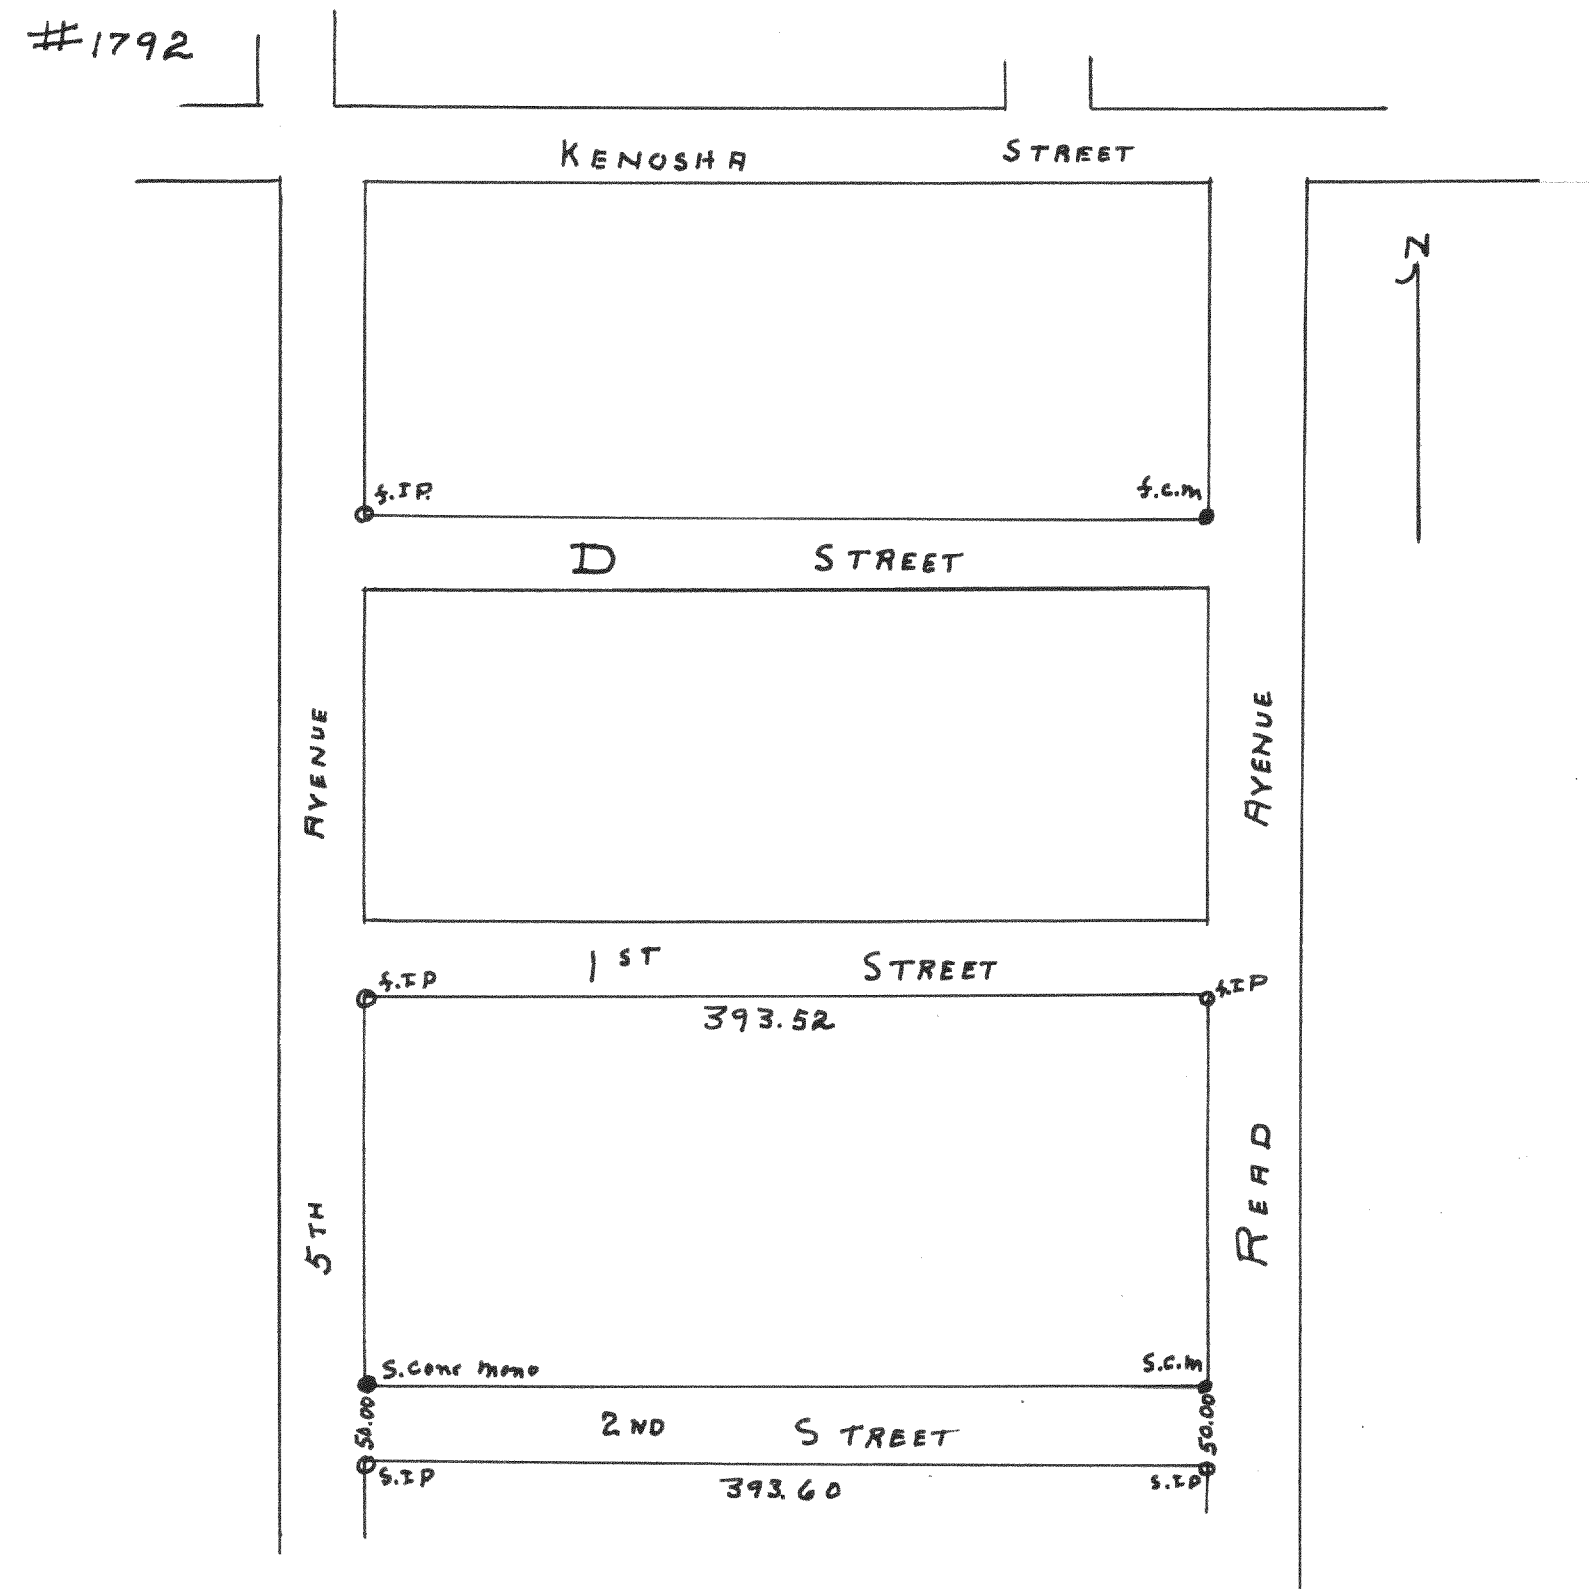


Plat of survey of Block Corners on 2nd Street in
the Village of Malworth, Malworth County, Wisconsin

Nov. 1997

Lloyd L Jensen
County Surveyor
LJJ

#1793

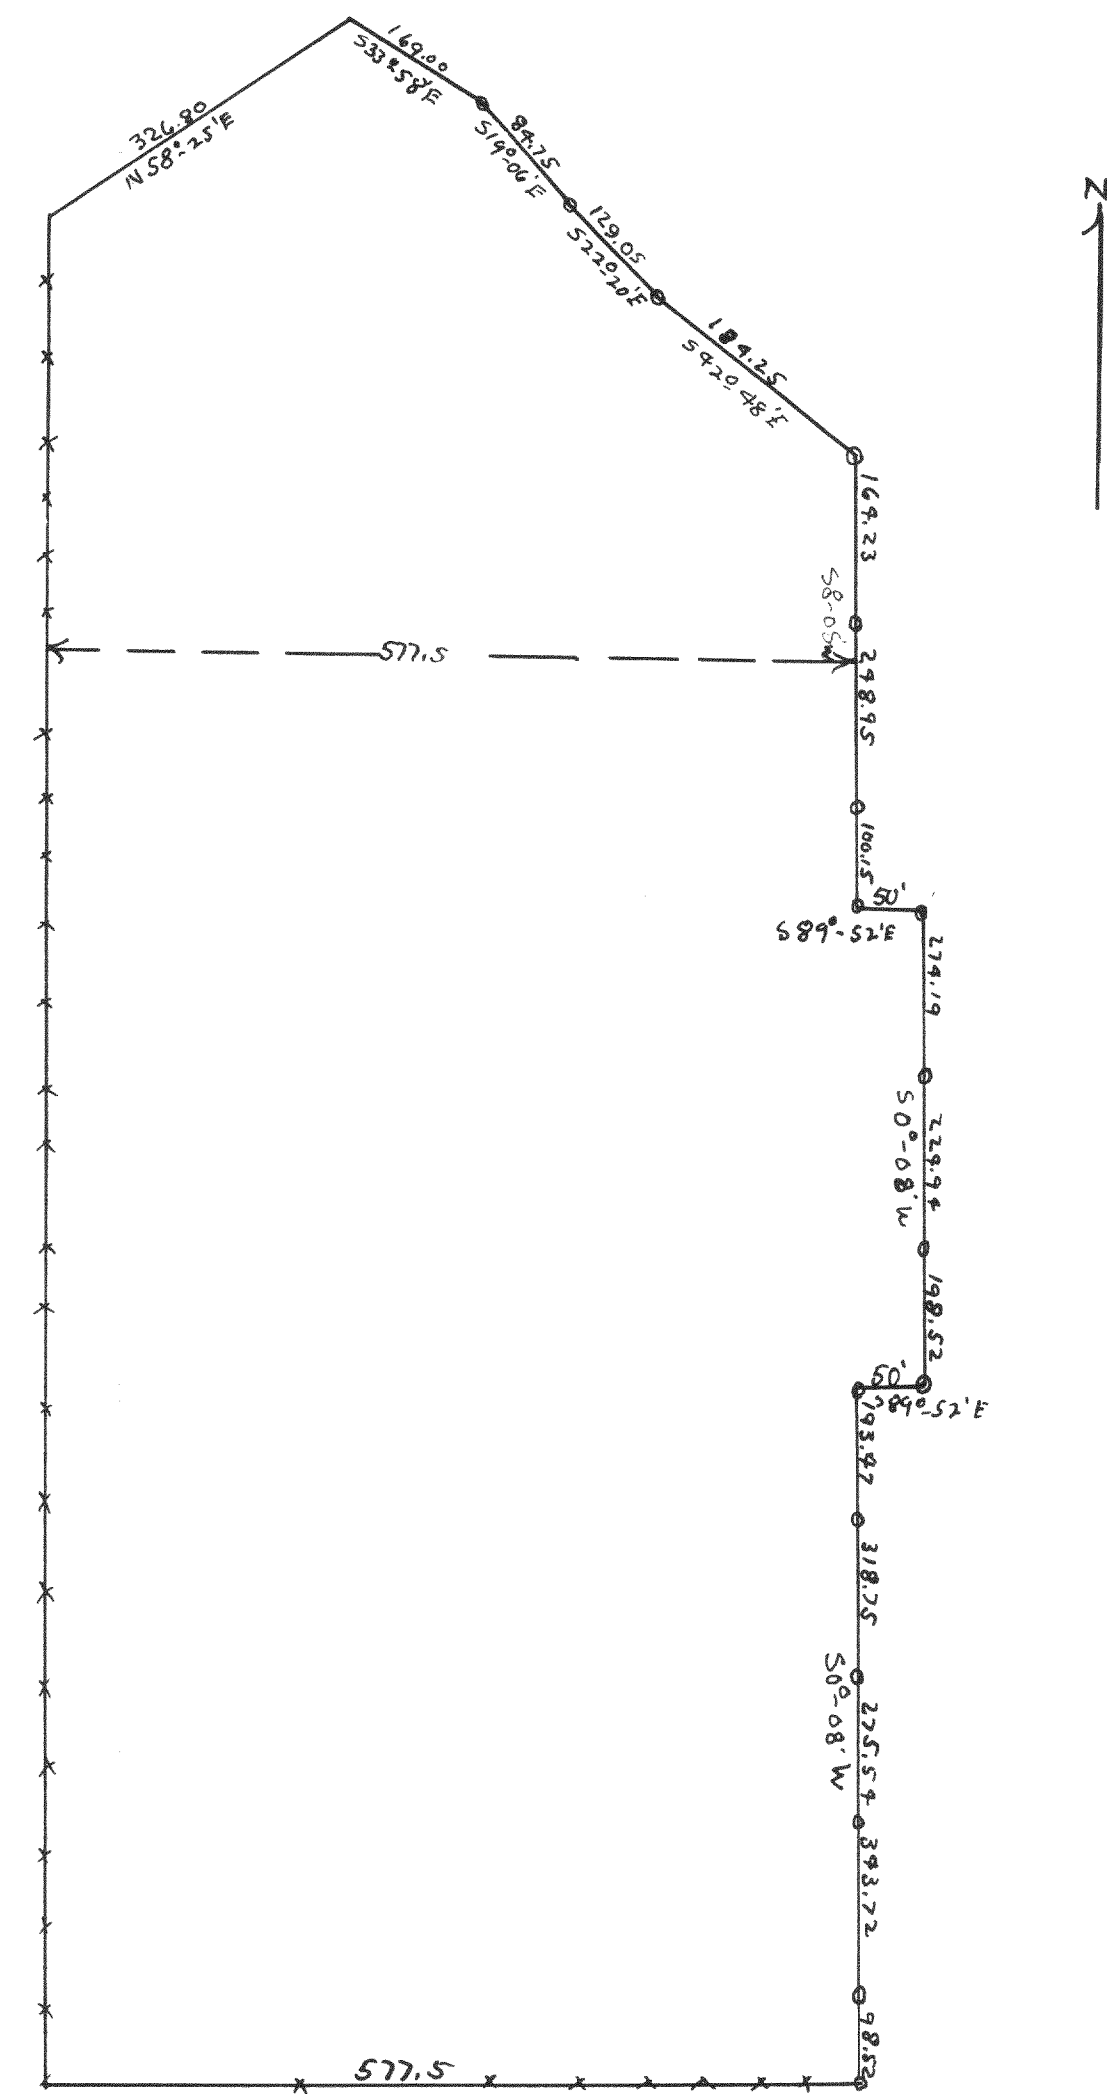

Plat of survey of land sold by Milo Krahn to the State of Wisconsin, located
in Section 26, T4N R15E of Malworth County, Wisconsin
7 Feb. 1998

Lloyd L Jensen
County Surveyor
LJJ